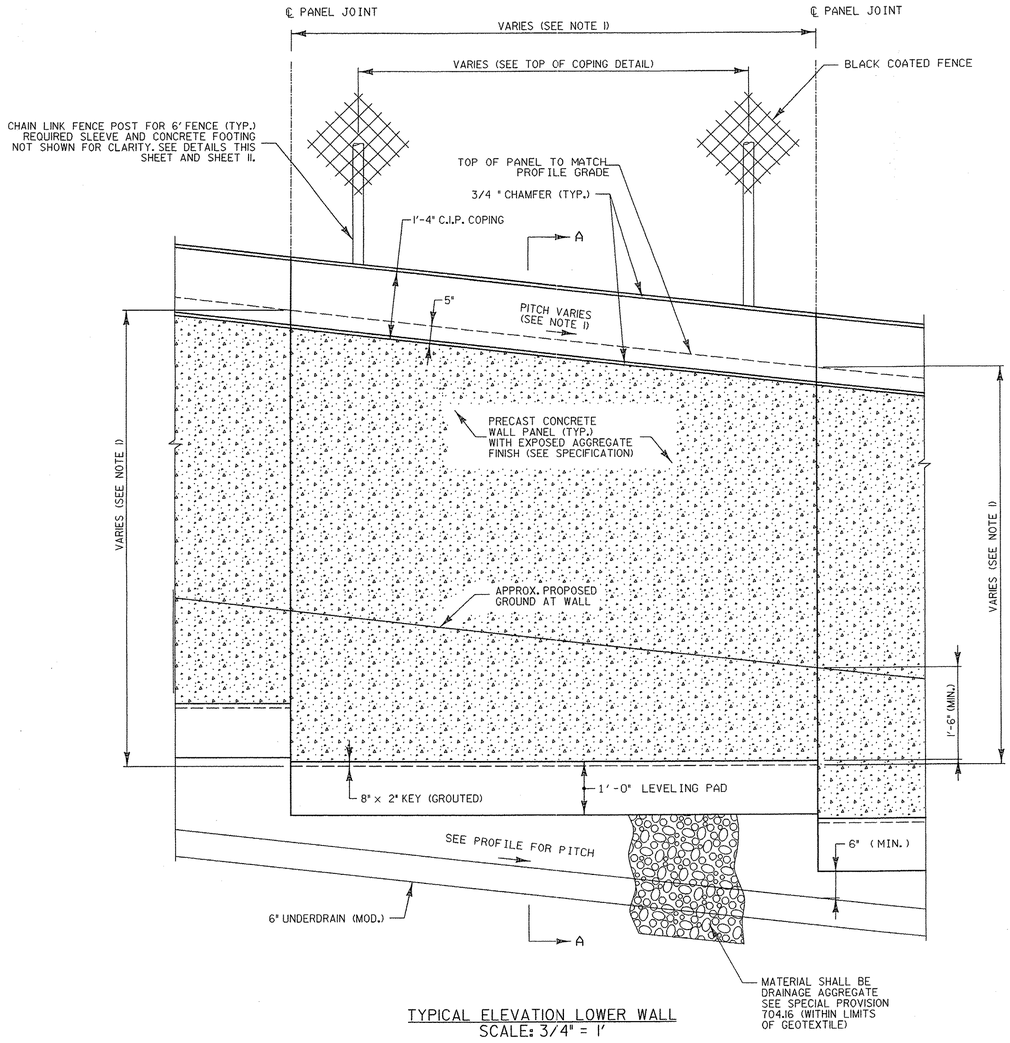

TYPICAL ELEVATION LOWER WALL
SCALE: 3/4" = 1'

NOTES:

1. PRE-CAST PANEL DIMENSIONS TO BE DETERMINED BY PRECASTER. DIMENSIONS SHOULD ALLOW FOR GAP IN BETWEEN PANELS TO ALLOW FOR THERMAL EXPANSION. IT IS RECOMMENDED THAT AS BUILT PLANS BE USED FOR PANEL SIZING IF AVAILABLE.

2. REQUIRED REINFORCEMENT IN PRECAST LEVELING PADS TO BE DETERMINED BY PRECASTER.

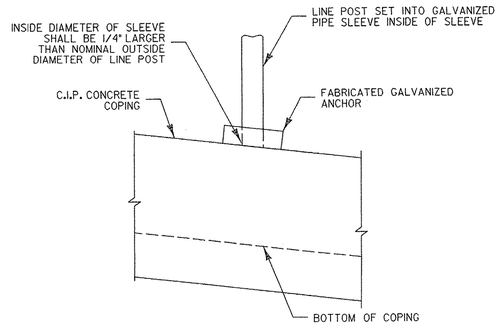

GALVANIZED SLEEVE DETAIL
N.T.S.

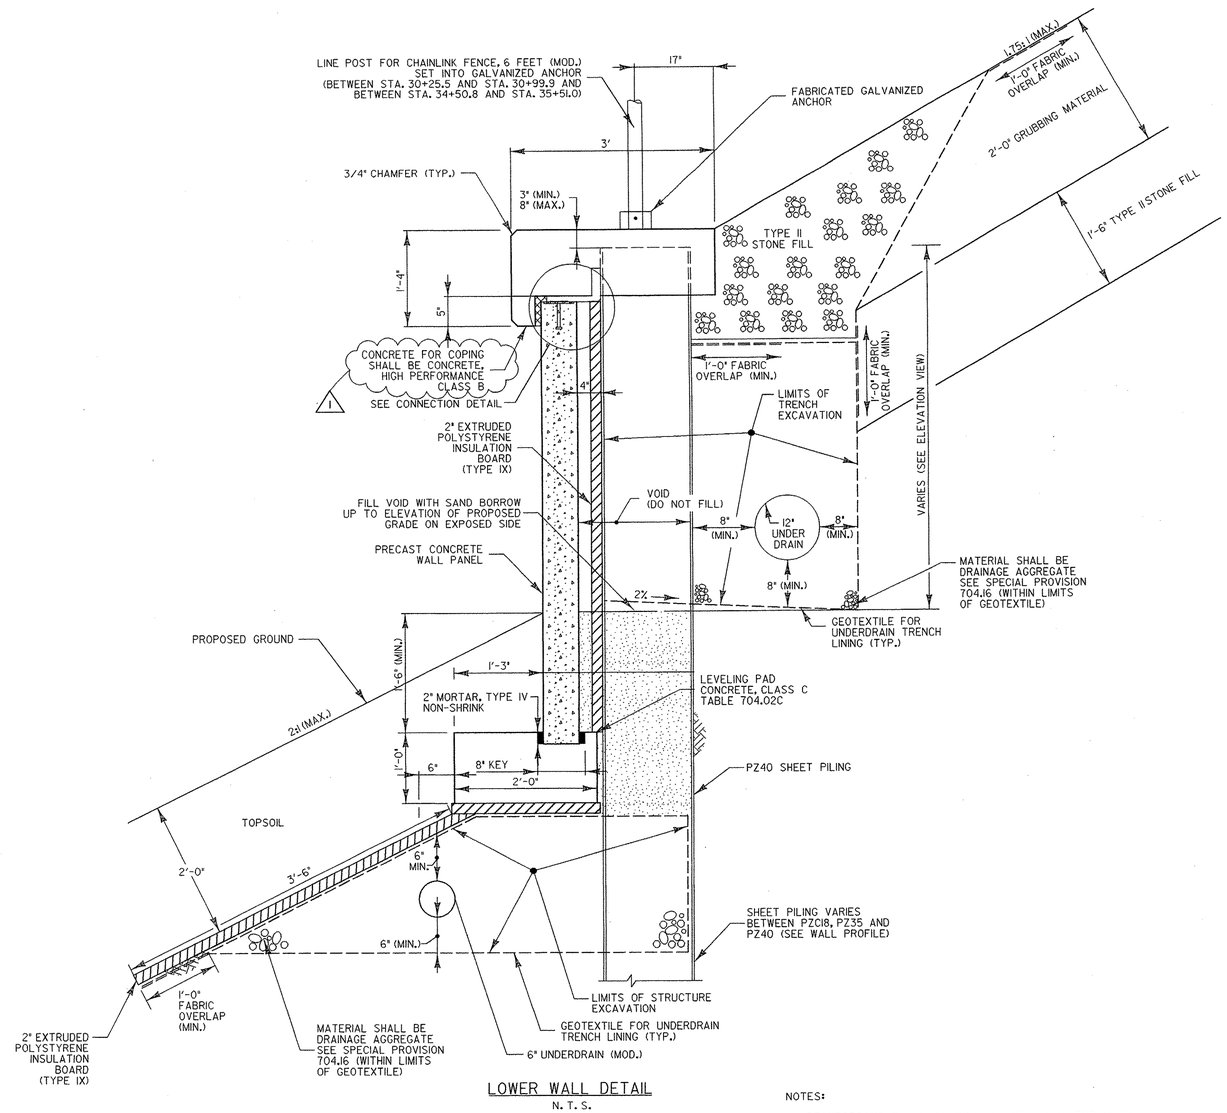

LOWER WALL DETAIL
N.T.S.

NOTES:

1. REINFORCING STEEL IN COPING NOT SHOWN FOR CLARITY.

2. GRUBBING AND ROCK FILL DETAILS LIKELY TO CHANGE AND POSSIBLY NEED SUPPORTING MEASURES SUCH AS GEOCELLS. FINAL DESIGN BY LANDSCAPE ARCHITECT IN COORDINATION WITH PIKE AND GEODESIGN.

3. 1/4" CORK MATERIAL CONFORMING TO 707.08 OF THE STANDARD SPECIFICATIONS SHALL BE USED ON EVERY JOINT OF THE PRECAST CONCRETE PANELS. THE CORK SHALL BE SEALED WITH A POLYURETHANE MATERIAL CONFORMING TO 707.05 OF THE STANDARD SPECIFICATIONS, THAT SHALL BE OF THE SAME COLOR AS THE PRECAST CONCRETE PANELS.

PROJECT NAME: HARTFORD	
PROJECT NUMBER: RS 0113(40)	
FILE NAME: ...z86c027wallde1.DGN	PLOT DATE: 3/13/2008
PROJECT LEADER:	DRAWN BY: G. BARRETT
DESIGNED BY: D. HOWEY	CHECKED BY: D. WOTRING
	SHEET 12 OF 14