SEE SHEET 2 FOR THE
INDEX OF SHEETS AND
LIST OF STANDARDS

STATE OF VERMONT
AGENCY OF TRANSPORTATION

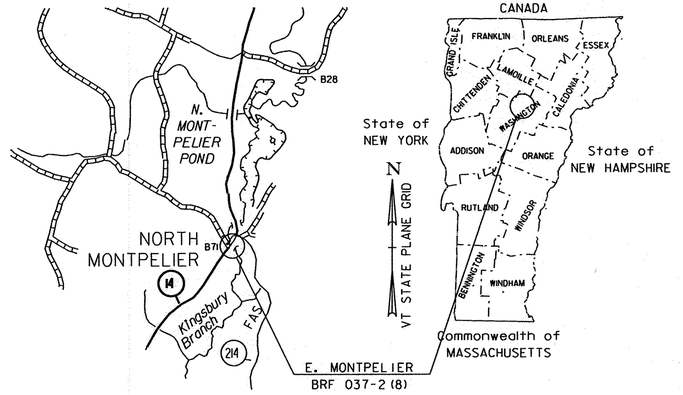

RECORD PLANS

CONTRACTOR: AL ST ONGE CONTRACTOR INC. – MONTGOMERY, VT

RESIDENT ENGINEER: CHRIS CRAIG

CONSTRUCTION BEGAN: MAY 9, 2011

CONSTRUCTION COMPLETE: OCTOBER 31, 2011

RECORD PLANS BY: CHRIS CRAIG & JENNA HYDE

I HEREBY CERTIFY THAT ALL THE CONSTUCTION REQUIRED BY THIS SET OF DRAWINGS HAS BEEN ACCOMPLISHED AS INDICATED HEREIN.

BY _____ RESIDENT ENGINEER

DATE 7-3-14

NOTE: Any further information concerning final quantities, amounts or other details relative to this project may be found at Central Files in the electronic archives.

PROPOSED IMPROVEMENT
BRIDGE PROJECT

TOWN OF EAST MONTPELIER

COUNTY OF WASHINGTON

ROUTE NO : VT RT 14, MINOR ARTERIAL BRIDGE NO: 71

PROJECT LOCATION : BEGINNING ON VT RT 14 APPROXIMATELY 0.085 KILOMETERS SOUTH OF THE INTERSECTION OF VT RT 214 AND VT RT 14 EXTENDING APPROXIMATELY 45 METERS IN A NORTHERLY DIRECTION.

PROJECT DESCRIPTION : REPLACEMENT OF BRIDGE NO. 71 ON THE EXISTING LOCATION AND NECESSARY APPROACH AND CHANNEL WORK.

LENGTH OF STRUCTURE :	19.600	METERS
LENGTH OF ROADWAY :	25.400	METERS
LENGTH OF PROJECT :	45.000	METERS

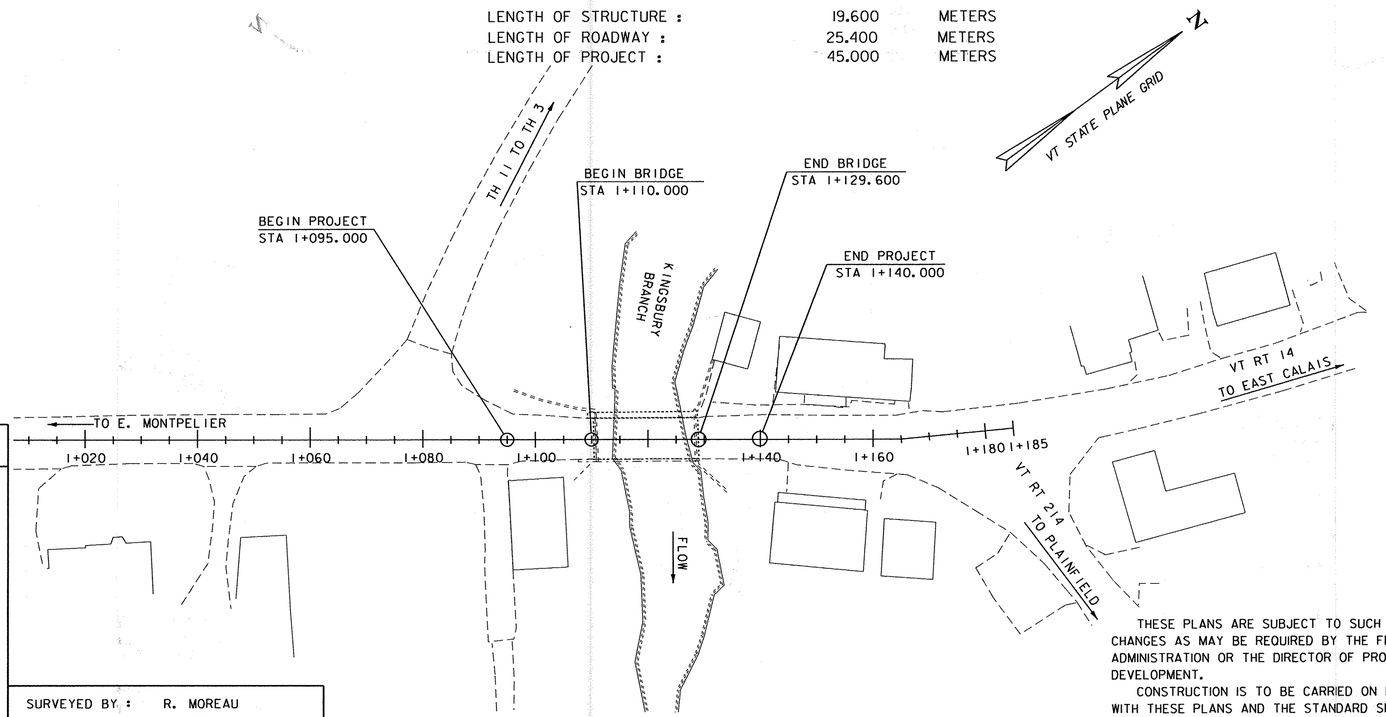

0 20 40 60

SCALE IN METERS
1 : 500

QUALITY ASSURANCE PROGRAM: LEVEL 2

CONVENTIONAL SYMBOLS

COUNTY LINE
TOWN LINE
LIMITS OF ACCESS
POINT OF ACCESS
FENCE LINE
STONE WALL
TRAVELED WAY
GUARD RAIL
RAILROAD
SURVEY LINE
CULVERT
POWER POLE
TELEPHONE POLE
TREES
CONTROL OF ACCESS
PROPERTY LINE
R.O.W. TAKING LINE
SLOPE RIGHTS SR SR SR
TOP OF CUT
TOE OF SLOPE

SURVEYED BY : R. MOREAU
SURVEYED DATE : 3/93

DATUM
VERTICAL USGS
HORIZONTAL ASSUMED

THESE PLANS ARE SUBJECT TO SUCH ENGINEERING CHANGES AS MAY BE REQUIRED BY THE FEDERAL HIGHWAY ADMINISTRATION OR THE DIRECTOR OF PROGRAM DEVELOPMENT.

CONSTRUCTION IS TO BE CARRIED ON IN ACCORDANCE WITH THESE PLANS AND THE STANDARD SPECIFICATIONS FOR CONSTRUCTION DATED 2006, AS APPROVED BY THE FEDERAL HIGHWAY ADMINISTRATION ON JUNE 15, 2006 FOR USE ON THIS PROJECT, INCLUDING ALL SUBSEQUENT REVISIONS AND SUCH REVISED SPECIFICATIONS AND SPECIAL PROVISIONS AS ARE INCORPORATED IN THESE PLANS.

86e054/structures/se054bdr.dgn se054tit.i

MADE Metric

UNLESS NOTED OTHERWISE
STATIONS ARE IN KILOMETERS
ELEVATIONS ARE IN METERS
DIMENSIONS ARE IN MILLIMETERS

DIRECTOR OF PROGRAM DEVELOPMENT
APPROVED Richard Fetcault DATE 8-18-10

PROJECT MANAGER : C.P. WILLIAMS

PROJECT NAME : EAST MONTPELIER
PROJECT NUMBER : BRF 037-2(8)
PLOTTED 17-AUG-2010
SHEET 1 OF 63 SHEETS