Metric

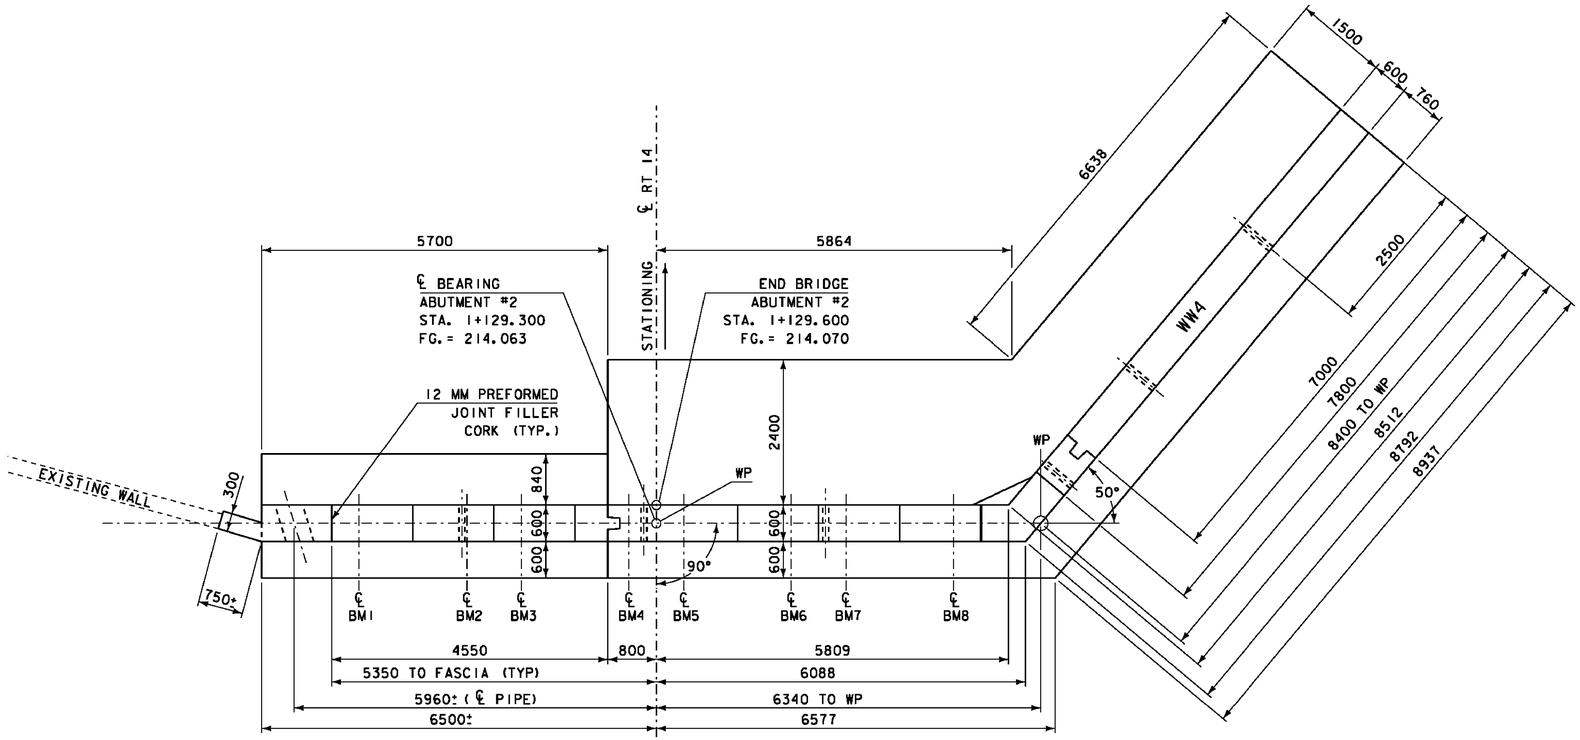

ABUTMENT #2 PLAN VIEW

SCALE 1:50

SEE REVISED SHEET 30A

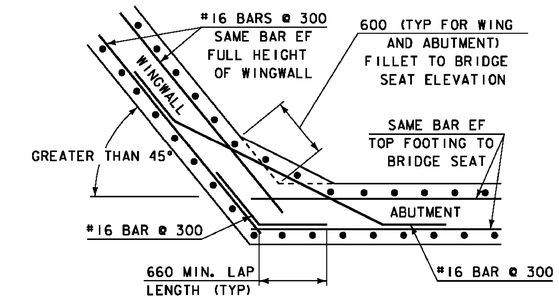

WINGWALL CORNER DETAIL FOR GREATER THAN 45°
BELOW BRIDGESEAT (TYP)

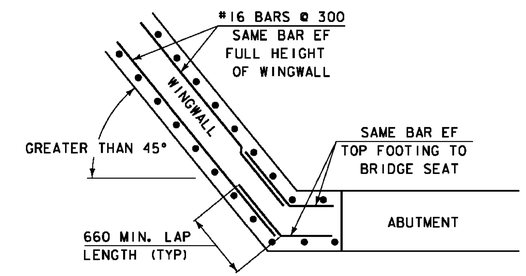

WINGWALL CORNER DETAIL FOR GREATER THAN 45°
ABOVE BRIDGESEAT (TYP)

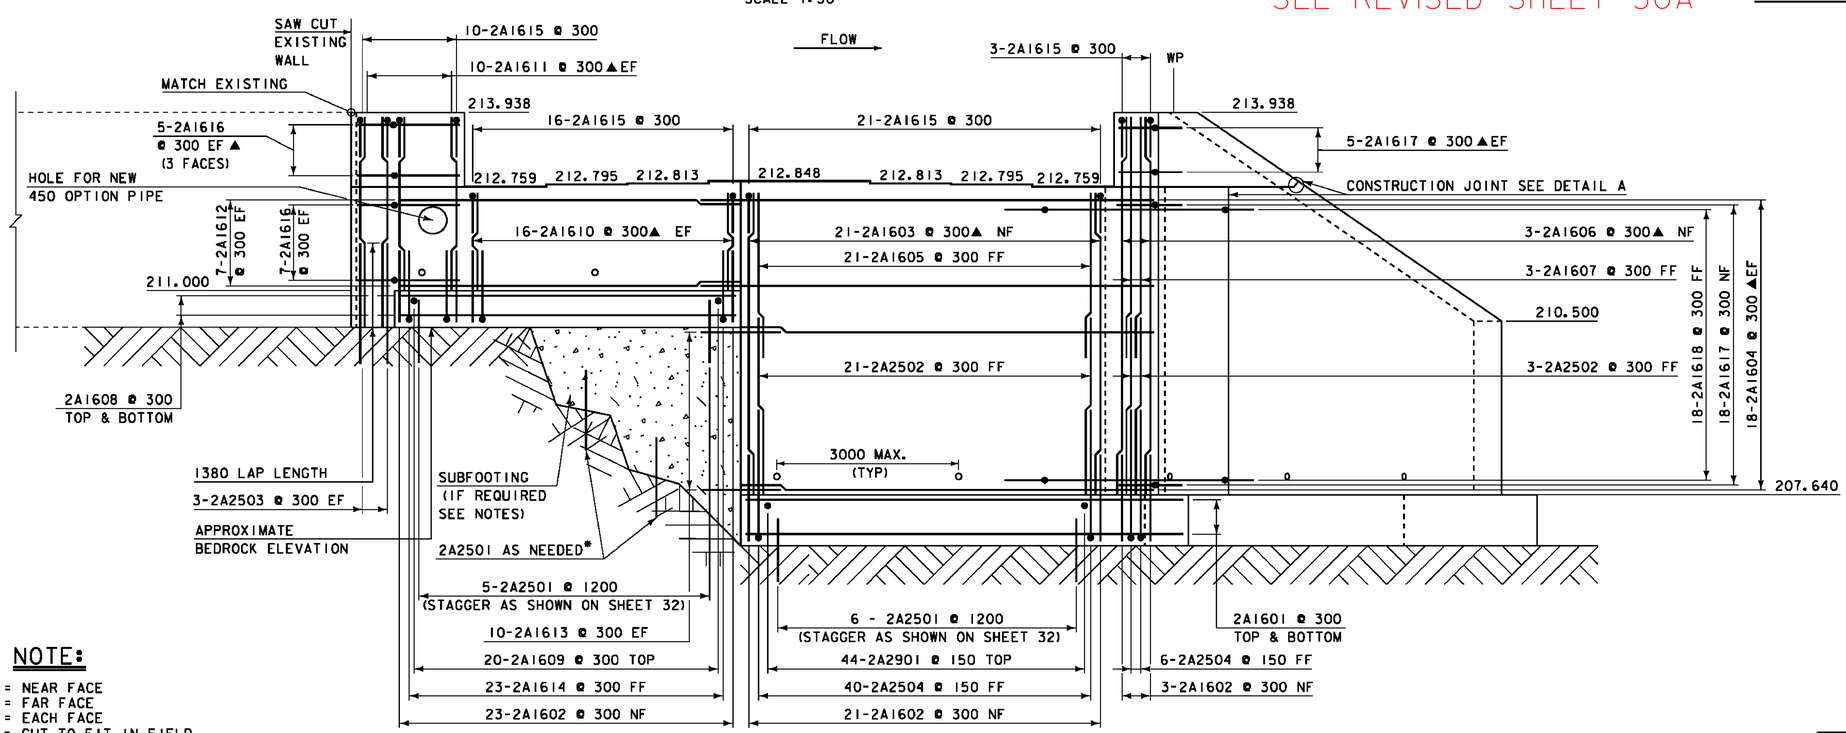

ABUTMENT #2 ELEVATION

SCALE 1:50

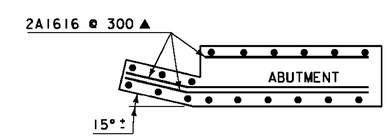

CORNER DETAIL FOR WINGWALL
#3 ABOVE BRIDGE SEAT

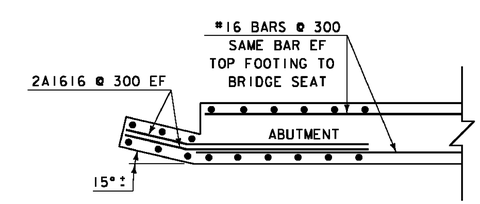

CORNER DETAIL FOR WINGWALL
#3 BELOW BRIDGE SEAT

0 1 2 3 4 5

SCALE = 1:50

NOTE:

NF = NEAR FACE
FF = FAR FACE
EF = EACH FACE
▲ = CUT TO FIT IN FIELD

80 CLR. UNLESS OTHERWISE
SPECIFIED ON THE PLANS.

ALL LAPS ARE 660 MIN
UNLESS OTHERWISE
SPECIFIED ON THE PLANS.

* 10 EXTRA 2501 BARS
INCLUDED FOR USE IN
SUBFOOTING

PROJECT: EAST MONTPELIER	PROJECT NO.: BRF 037-2 (8)
DESIGN FILE NAME: 86e054/Structures/se054sub.dgn	
IPARM FILE NAME: se054abut2.i	PLOT DATE: 18-AUG-2010
DESIGNED BY: L.J.STONE	DRAWN BY: D.D.BEARD
SQUAD LEADER: C.P.WILLIAMS	CHECKED BY: H.I.SALLS
ABUTMENT 2 DETAILS	SHEET: 30 OF 63