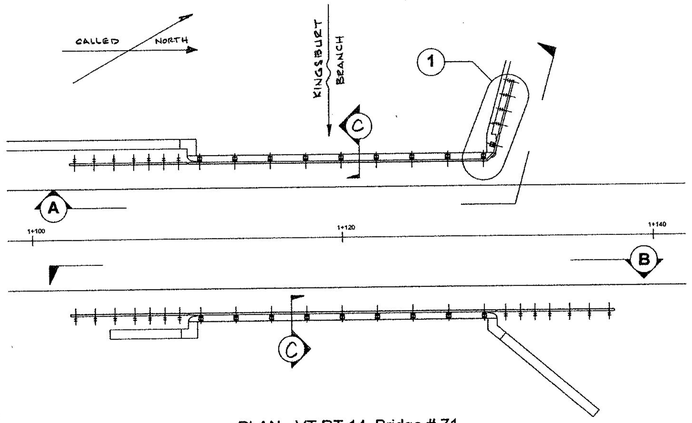

PLAN - VT RT 14, Bridge # 71

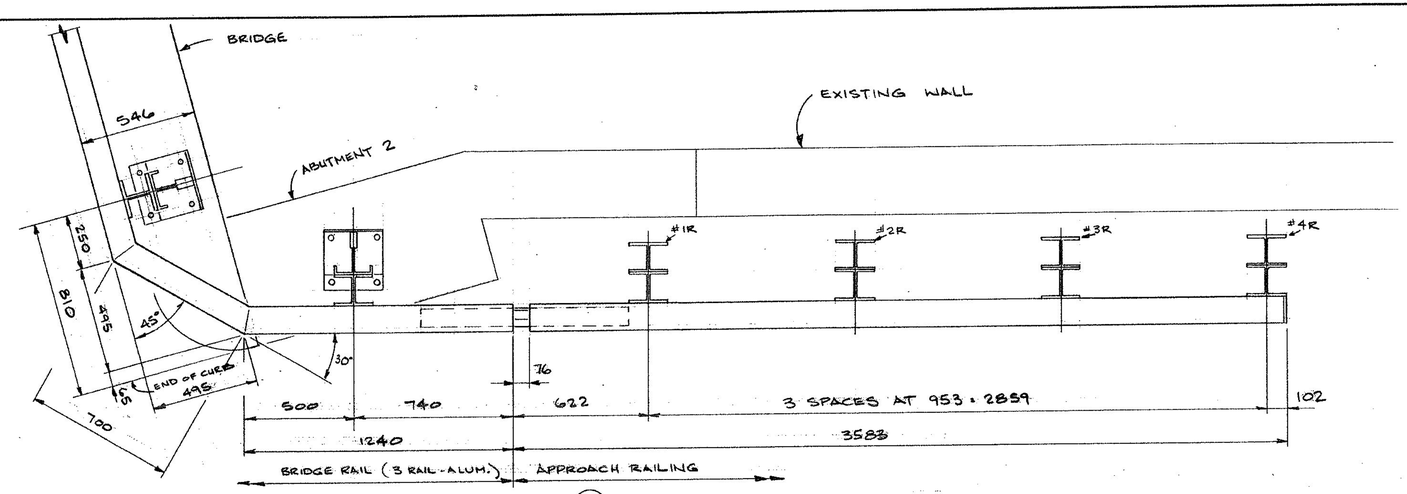

DETAIL 1 (HANDRAIL NOT SHOWN)

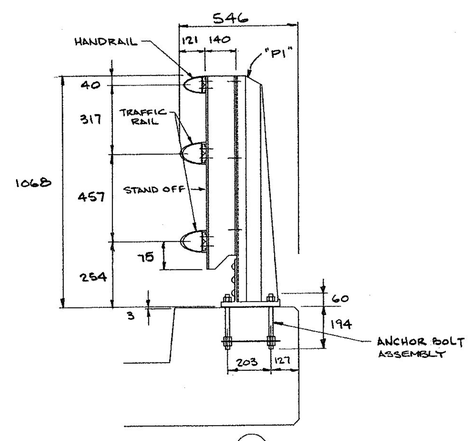

SECTION C

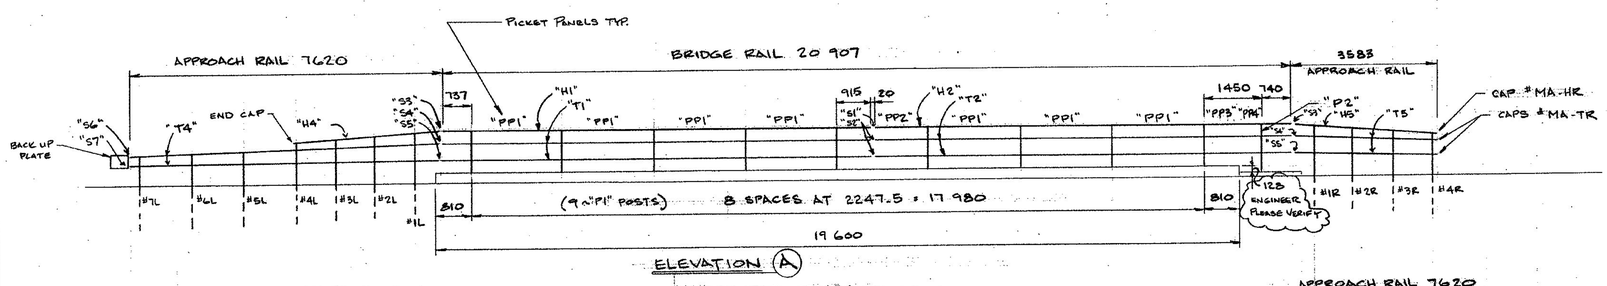

ELEVATION A

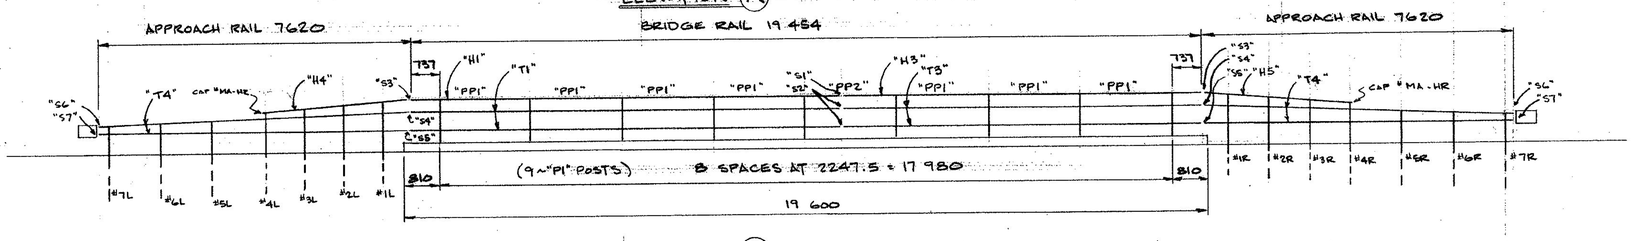

ELEVATION B

DIMENSIONS ARE IN MILLIMETERS

Recieved Date: 6/1/11
Checked By: Hiram Salls
Reviewed By: Rob Young
Approval Type: Approved
Approved By: Chris Williams
Date: 6/13/11

ISSUE	DATE	DESCRIPTION	BY
1	5-25-11	FOR APPROVAL	

AUCIELLO IRON WORKS INC
560 MAIN ST. HUDSON, MA (978) 568-8382

EAST MONTPELIER, VT
VT RT 14, BRIDGE # 17
BRF 037-2(8)

ALUM. BRIDGE AND APPROACH RAIL

SURFACE PREP: NONE	FINISH: MILL
FOR: E.R. LAFAYETTE, INC.	
DR: 5-12-2011	DWG. NO. BR-3006
CHK: 5-25-11	
JOB NO. A5T044-1001	SHEET 1-E1 OF

BL MAKEPEACE INC. 10918