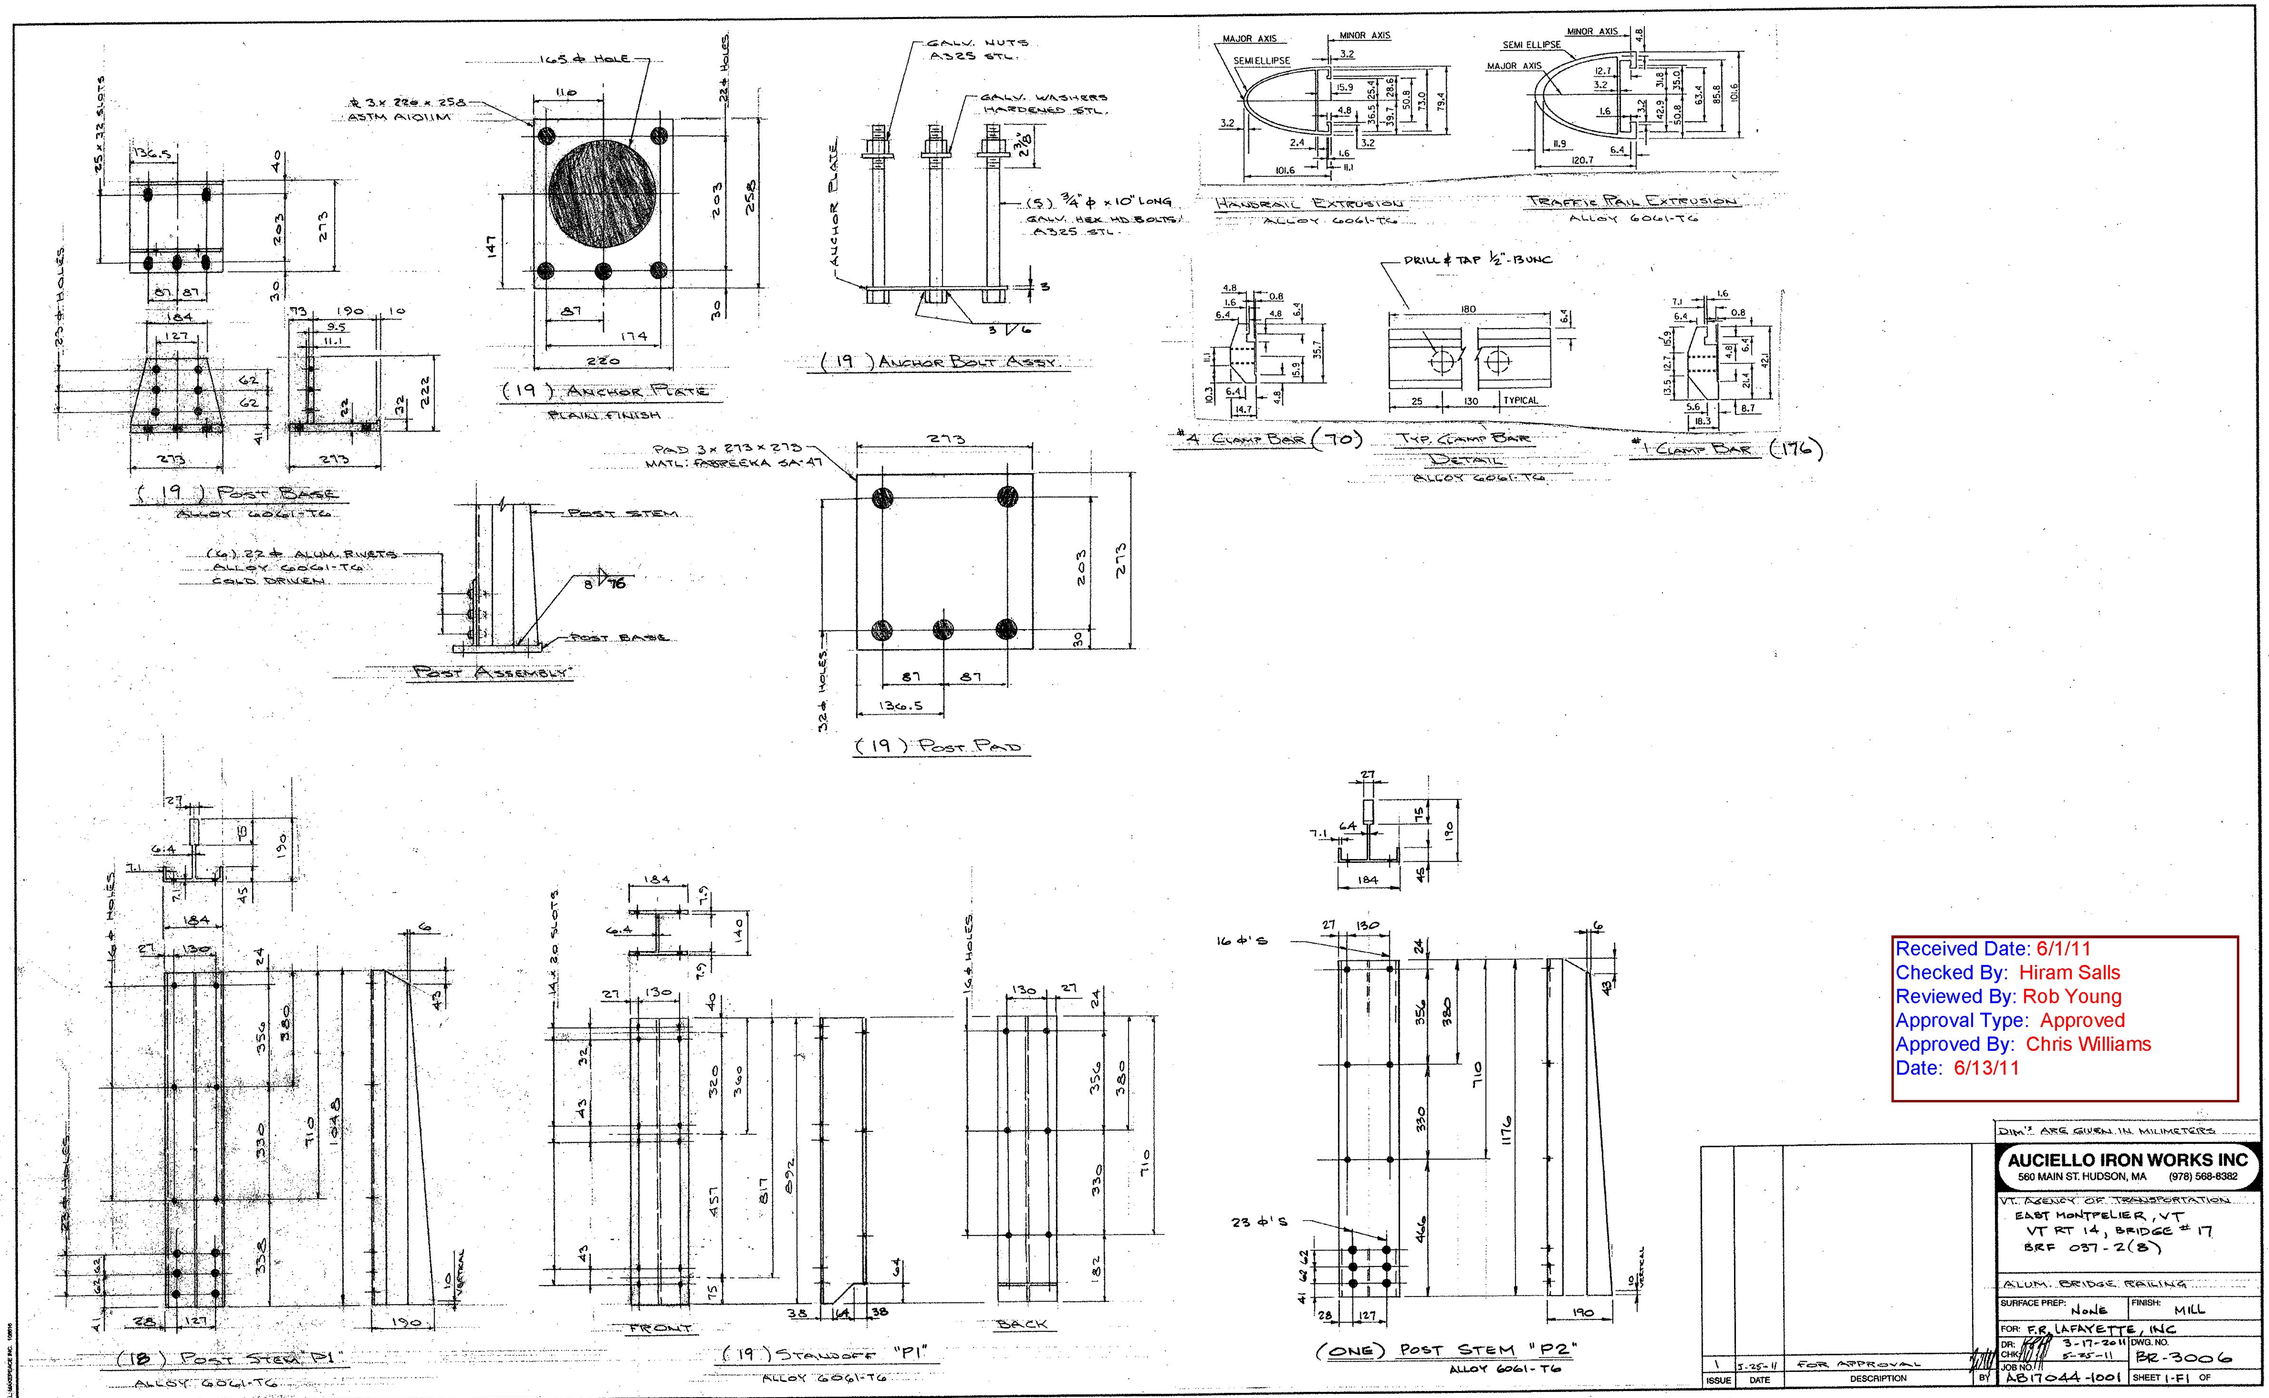

Received Date: 6/1/11
Checked By: Hiram Salls
Reviewed By: Rob Young
Approval Type: Approved
Approved By: Chris Williams
Date: 6/13/11

Dim's are given in millimeters

AUCIELLO IRON WORKS INC
560 MAIN ST. HUDSON, MA (978) 568-8382

VT. AGENCY OF TRANSPORTATION
EAST MONTPELIER, VT
VT RT 14, BRIDGE # 17
BRF 037-2(8)

ALUM. BRIDGE RAILING

SURFACE PREP: None	FINISH: MILL
FOR: F.R. LAFAYETTE, INC	
DR. 3-17-2011	DWG. NO.
CHK 5-25-11	BR-3006
JOB NO. AB17044-1001	SHEET 1-F1 OF

ISSUE	DATE	DESCRIPTION	BY
1	5-25-11	FOR APPROVAL	