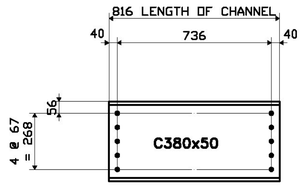

INT. DIAPH.~ 9D1

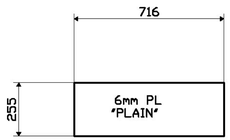

CURTAIN WALL PL~ 9P1

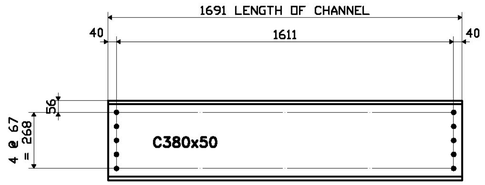

INT. DIAPH.~ MA9

SHIPPER BILL OF MATERIAL								
NO.	MARK	NO.	MARK	SIZE	LENGTH	REMARKS	ITEM	WEIGHT
	FIELD INSTALLED MATERIAL							
6	9D1			C380x50	816			
16	9P1			PL 6x255	716			
	SHOP INSTALLED DIAPHRAGMS							
		8	MA9	C380x50	1691			

Received Date: 3/25/11
Checked By: Hiram Salls
Approval Type: Approved
Approved By: Chris Williams
Date: 4/13/11

SHOP NOTES

HOLES 24ø ($\frac{15}{16}$ø)
BOLTS NONE
PAINT NONE
WELDS TO BE MADE USING ____ ELECTRODES
MATERIAL M270-345W

REV.NO	DATE	REVISION
3		
2		
1		

DIAPHRAGM & MISC. DETAILS

PROJECT No. BRF 037-2(8)
REPLACEMENT OF BRIDGE No. 71
TOWN OF EAST MONTPELIER, WASHINGTON COUNTY, VT

FOSTER . PRECISE
3 FARM LANE
GEORGETOWN, MA 01833-1843

OWNER: STATE OF VERMONT AGENCY OF TRANSPORTATION
CONTRACTOR: J.R. SLAW

DRAWN BY	CHECKED BY	APP.	SHOP	DIST.	CONTRACT NO.	SHEET NO.
PDC/WS 03-2011	PDC/SB 03-2011				3561	9