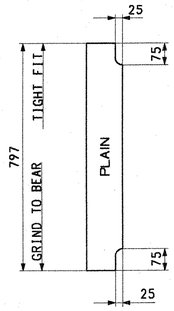

BRG. STIFF. MK. z1a

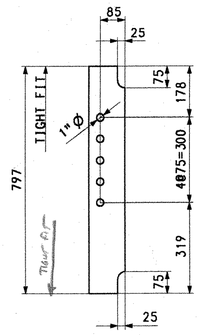

CONN. PLATE MK. z1b

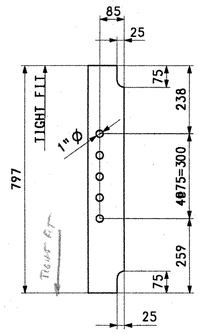

CONN. PLATE MK. z1c

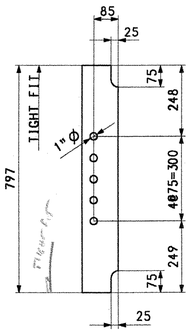

CONN. PLATE MK. z1d

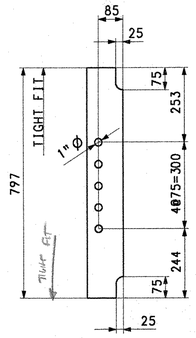

CONN. PLATE MK. z1f

BILL OF MATERIAL

SHIP.	QTY. EA.	MARK	COMM.	DESCRIPTION	LENGTH	SPEC	GRADE	TEST	REMARKS	GRP.	ITEM	SHIP WEIGHT EA. (KG)
1	20	z1a	PL	19 x 125	797	M270M	345W	T		8	1	14.86
1	12	z1b	PL	13 x 125	797	M270M	345W	T		8	2	10.17
1	4	z1c	PL	13 x 125	797	M270M	345W	T		8	2	10.17
1	4	z1d	PL	13 x 125	797	M270M	345W	T		8	2	10.17
1	4	z1f	PL	13 x 125	797	M270M	345W	T		8	2	10.17

NOTES:

HOLES: AS NOTED
BOLTS: NONE
PAINT: NONE
FOR GENERAL SHOP NOTES, SEE DWG. GN1.

CODE: 50

FED.ROAD DIV.NO.	STATE	FED.AID PROJ.NO.
	VT	

RECEIVED
CK'D BY WWS CK'D BY JTR
FEB 14 2006
RESUBMIT ____ APPROVED As Noted
BY WWS DATE 3/2/06

NO.	REVISION	BY	DATE
1			
2			
3			

HIGH STEEL STRUCTURES, INC.
1770 Hempstead Road
Lancaster, PA 17605-0008
Phone 717/299-5211
A Division of High Industries, Inc.

STRINGER JOB STANDARDS
VERMONT ROUTE 100 OVER DOWSVILLE BROOK
VERMONT ROUTE 100 STA. 0+239.930 TO STA. 0+260.070
TOWN OF DUXBURY, WASHINGTON COUNTY, VERMONT
STATE OF VERMONT
AGENCY OF TRANSPORTATION

STATE CONTRACT OR REF. NO.: BRIDGE NO. 187, DUXBURY STP 013-4 (24)
CONTRACTOR: AUSTIN CONSTRUCTION, INC.
IN CHARGE: BRITIGAN (IH) MADE BY: RC CHK'D BY: WBW DATE: 2/3/06
CONTRACT NUMBER: VT-05124-1 DRAWING NUMBER: Z1 OF Z2

072 SS

05124 X1 2/7/06 2/7/06Approval TO:Austin Construction,

PLOTTED: DATE5678901234567 BY: USERNAME