METRIC

METRIC 1. ALL DIMENSIONS ARE IN MILLIMETERS UNLESS OTHERWISE NOTED.
2. ALL WEIGHTS ARE IN KILOGRAMS.

FED. ROAD DIV. NO.	STATE	FED. AID PROJ. NO.
	VT	

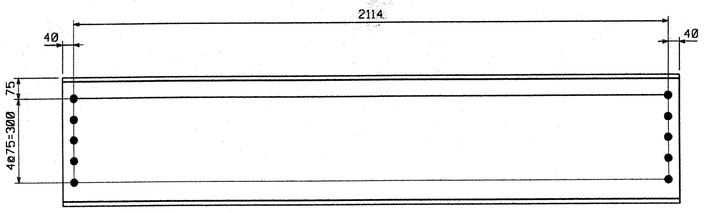

DIAPHRAGM ~ MK. D1

BILL OF MATERIAL

SHIP.	QTY EA.	MARK	COMMODITY	DESCRIPTION	LENGTH	SPEC	GRADE	TEST	REMARKS	GRP.	ITEM	SHIP WEIGHT EA.
				DIAPHRAGM								
1	12	D1	MC	460 x 63.5	2 194	M270M	345W		(MC18 x 42.7)	10	1	139.32

TOTAL WEIGHT THIS SHEET: 1671.83 kg

SHOP NOTE

HOLES: 15/16"ø
BOLTS: NONE
PAINT: NONE
FOR GENERAL SHOP NOTES, SEE DWG. GN1.

CODE:56

RECEIVED
OK'D BY LWSS OK'D BY JTR
FEB 14 2006
RESUBMIT ____ APPROVED ✓
BY WBW DATE 2/2/06

NO.	REVISION	BY	DATE
△			
△			
△			

HIGH STEEL STRUCTURES, INC.
1770 Hempstead Road
Lancaster, PA 17605-0008
Phone 717/299-5211
A Division of High Industries, Inc.

DIAPHRAGMS D1
VERMONT ROUTE 100 OVER DOWSVILLE BROOK
VERMONT ROUTE 100 STA. 0+239.930 TO STA. 0+260.070
TOWN OF DUXBURY, WASHINGTON COUNTY, VERMONT
STATE OF VERMONT
AGENCY OF TRANSPORTATION

STATE CONTRACT OR REF. NO. BRIDGE NO. 187, DUXBURY STP 013-4 (24)
CONTRACTOR AUSTIN CONSTRUCTION, INC.
IN CHARGE: BRITIGAN (IH) MADE BY: RC CHK'D BY: WBW DATE: 2/3/06
CONTRACT NUMBER: VT-05124-1 DRAWING NUMBER: 2 OF 7

076 55

PLOTTED: 02/07/06 08:47:36 AM BY: MKreutzel

05124 X1 2/7/06 2/7/06Approval TO:Austin Construction,