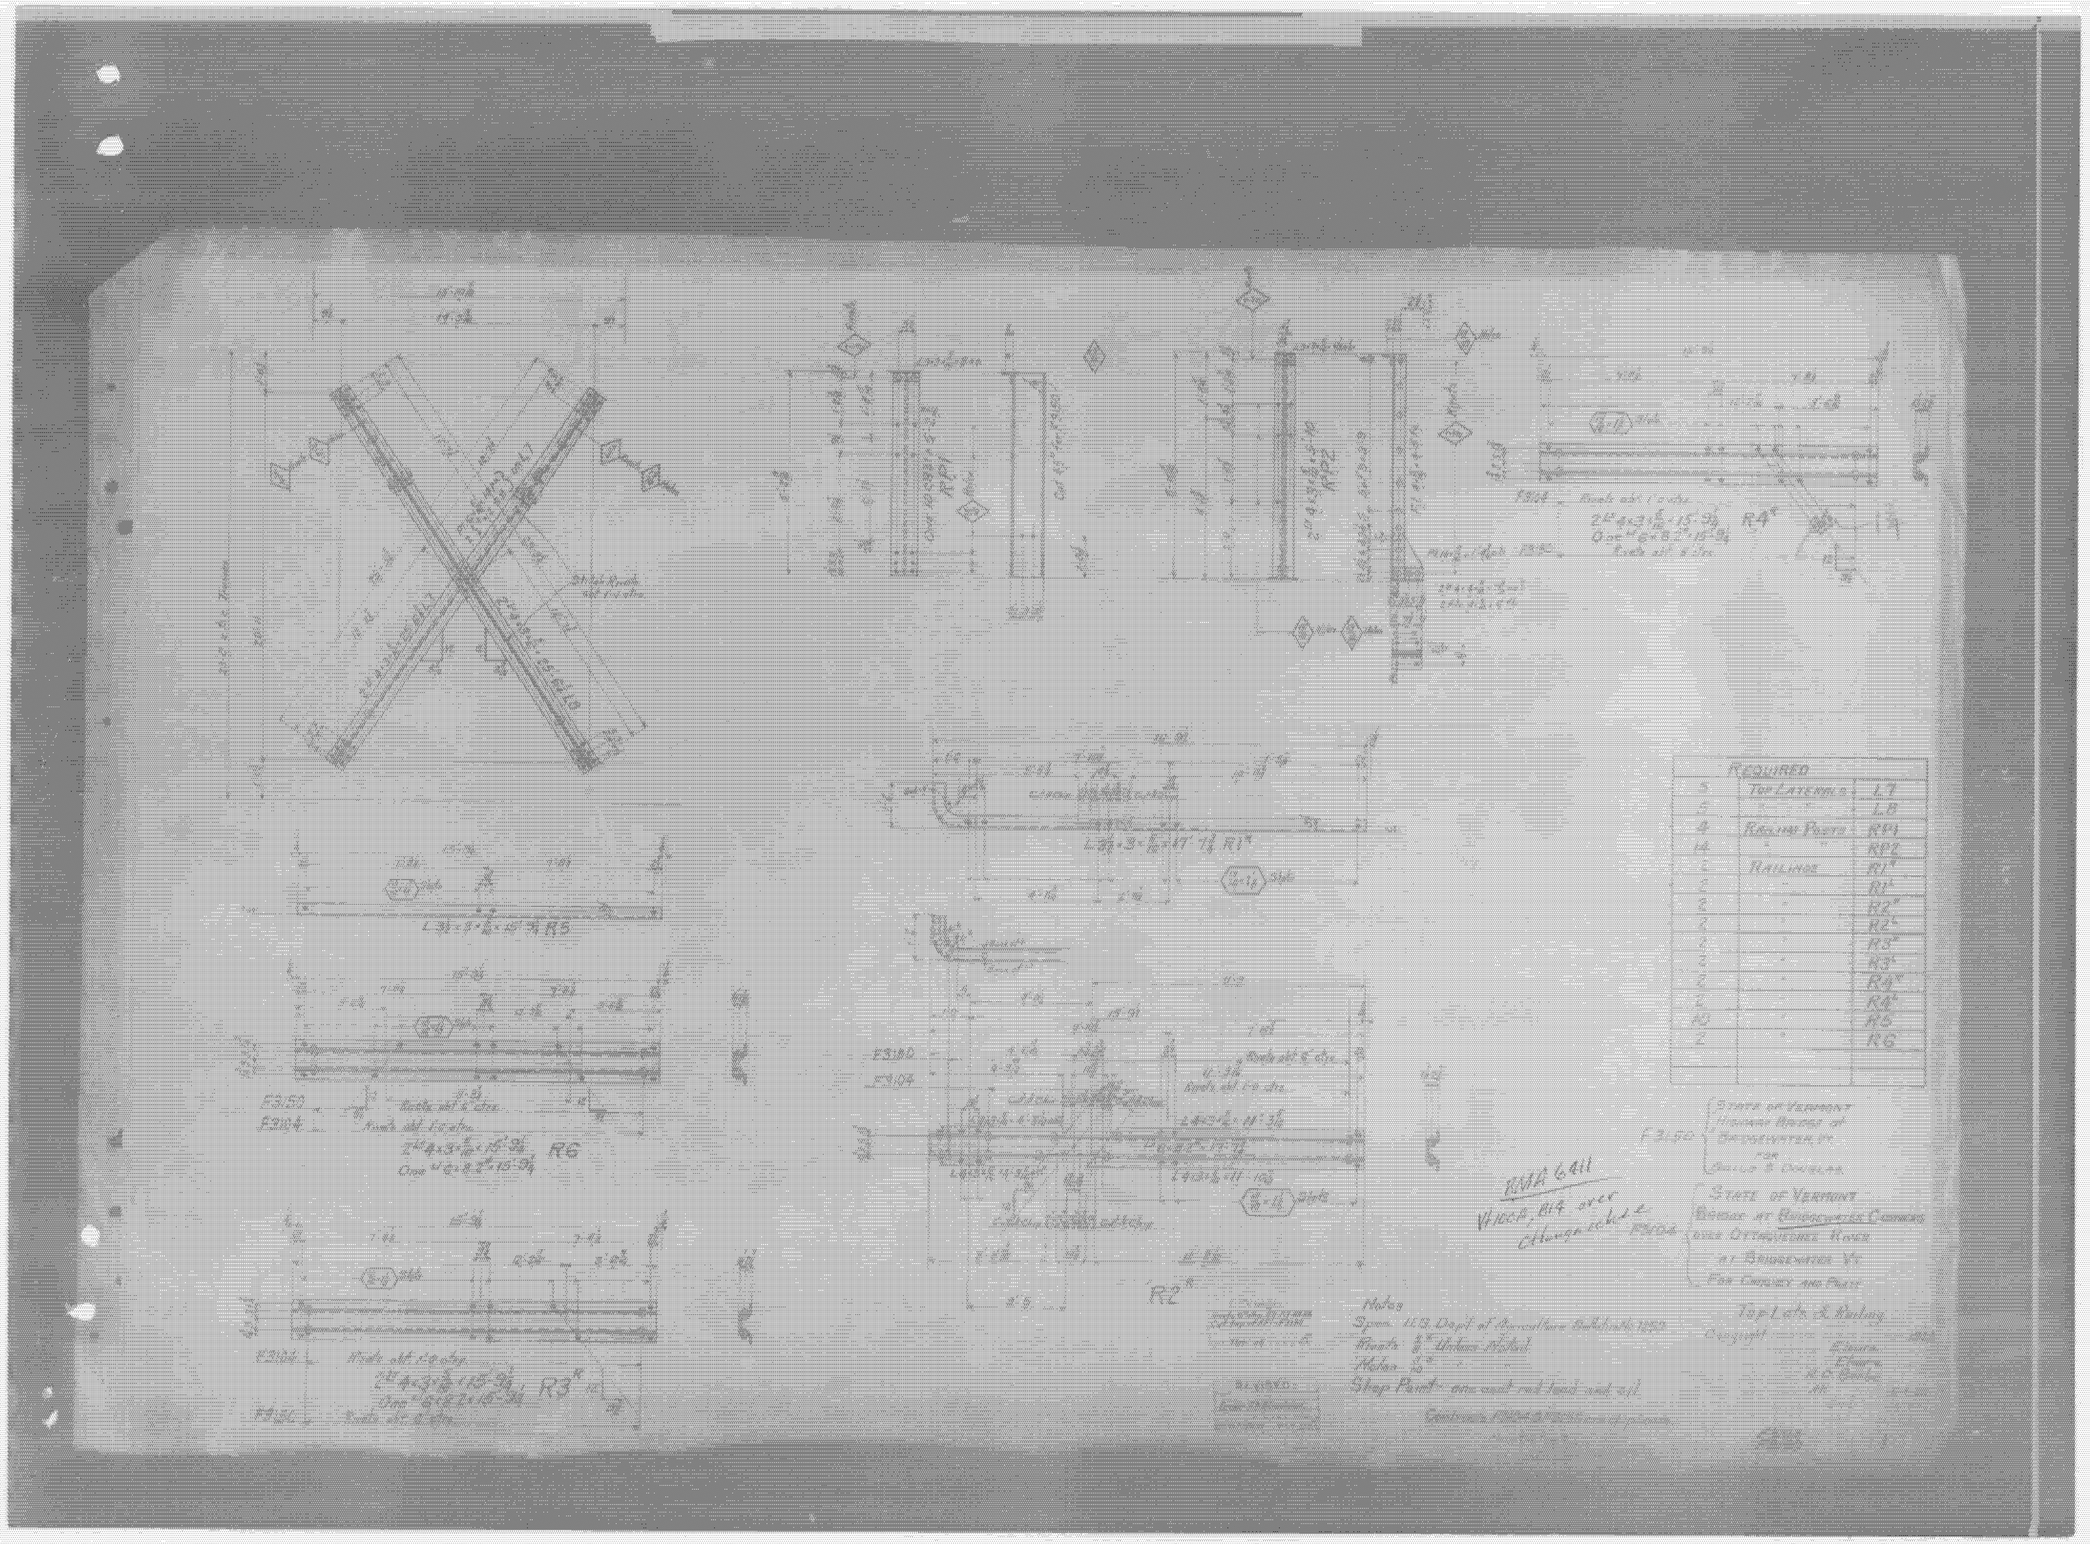
REQUIRED
TOP LATERALS
RAILING POSTS
RAILINGS
R4
R5
R6
R2
RMA 6411
Notes
Steel: U.S. Dept of Agriculture Bulletin 1022
Rivets: 3/4" Button Nickel
Holes: 13/16"
Shop Paint: one coat red lead and oil
STATE OF VERMONT
BRIDGE AT BRIDGEWATER CORNERS
OVER OTTAUQUECHEE RIVER
AT BRIDGEWATER VT.
FOR COUNTY AND TOWN
Top Lats & Railing
Copyright