



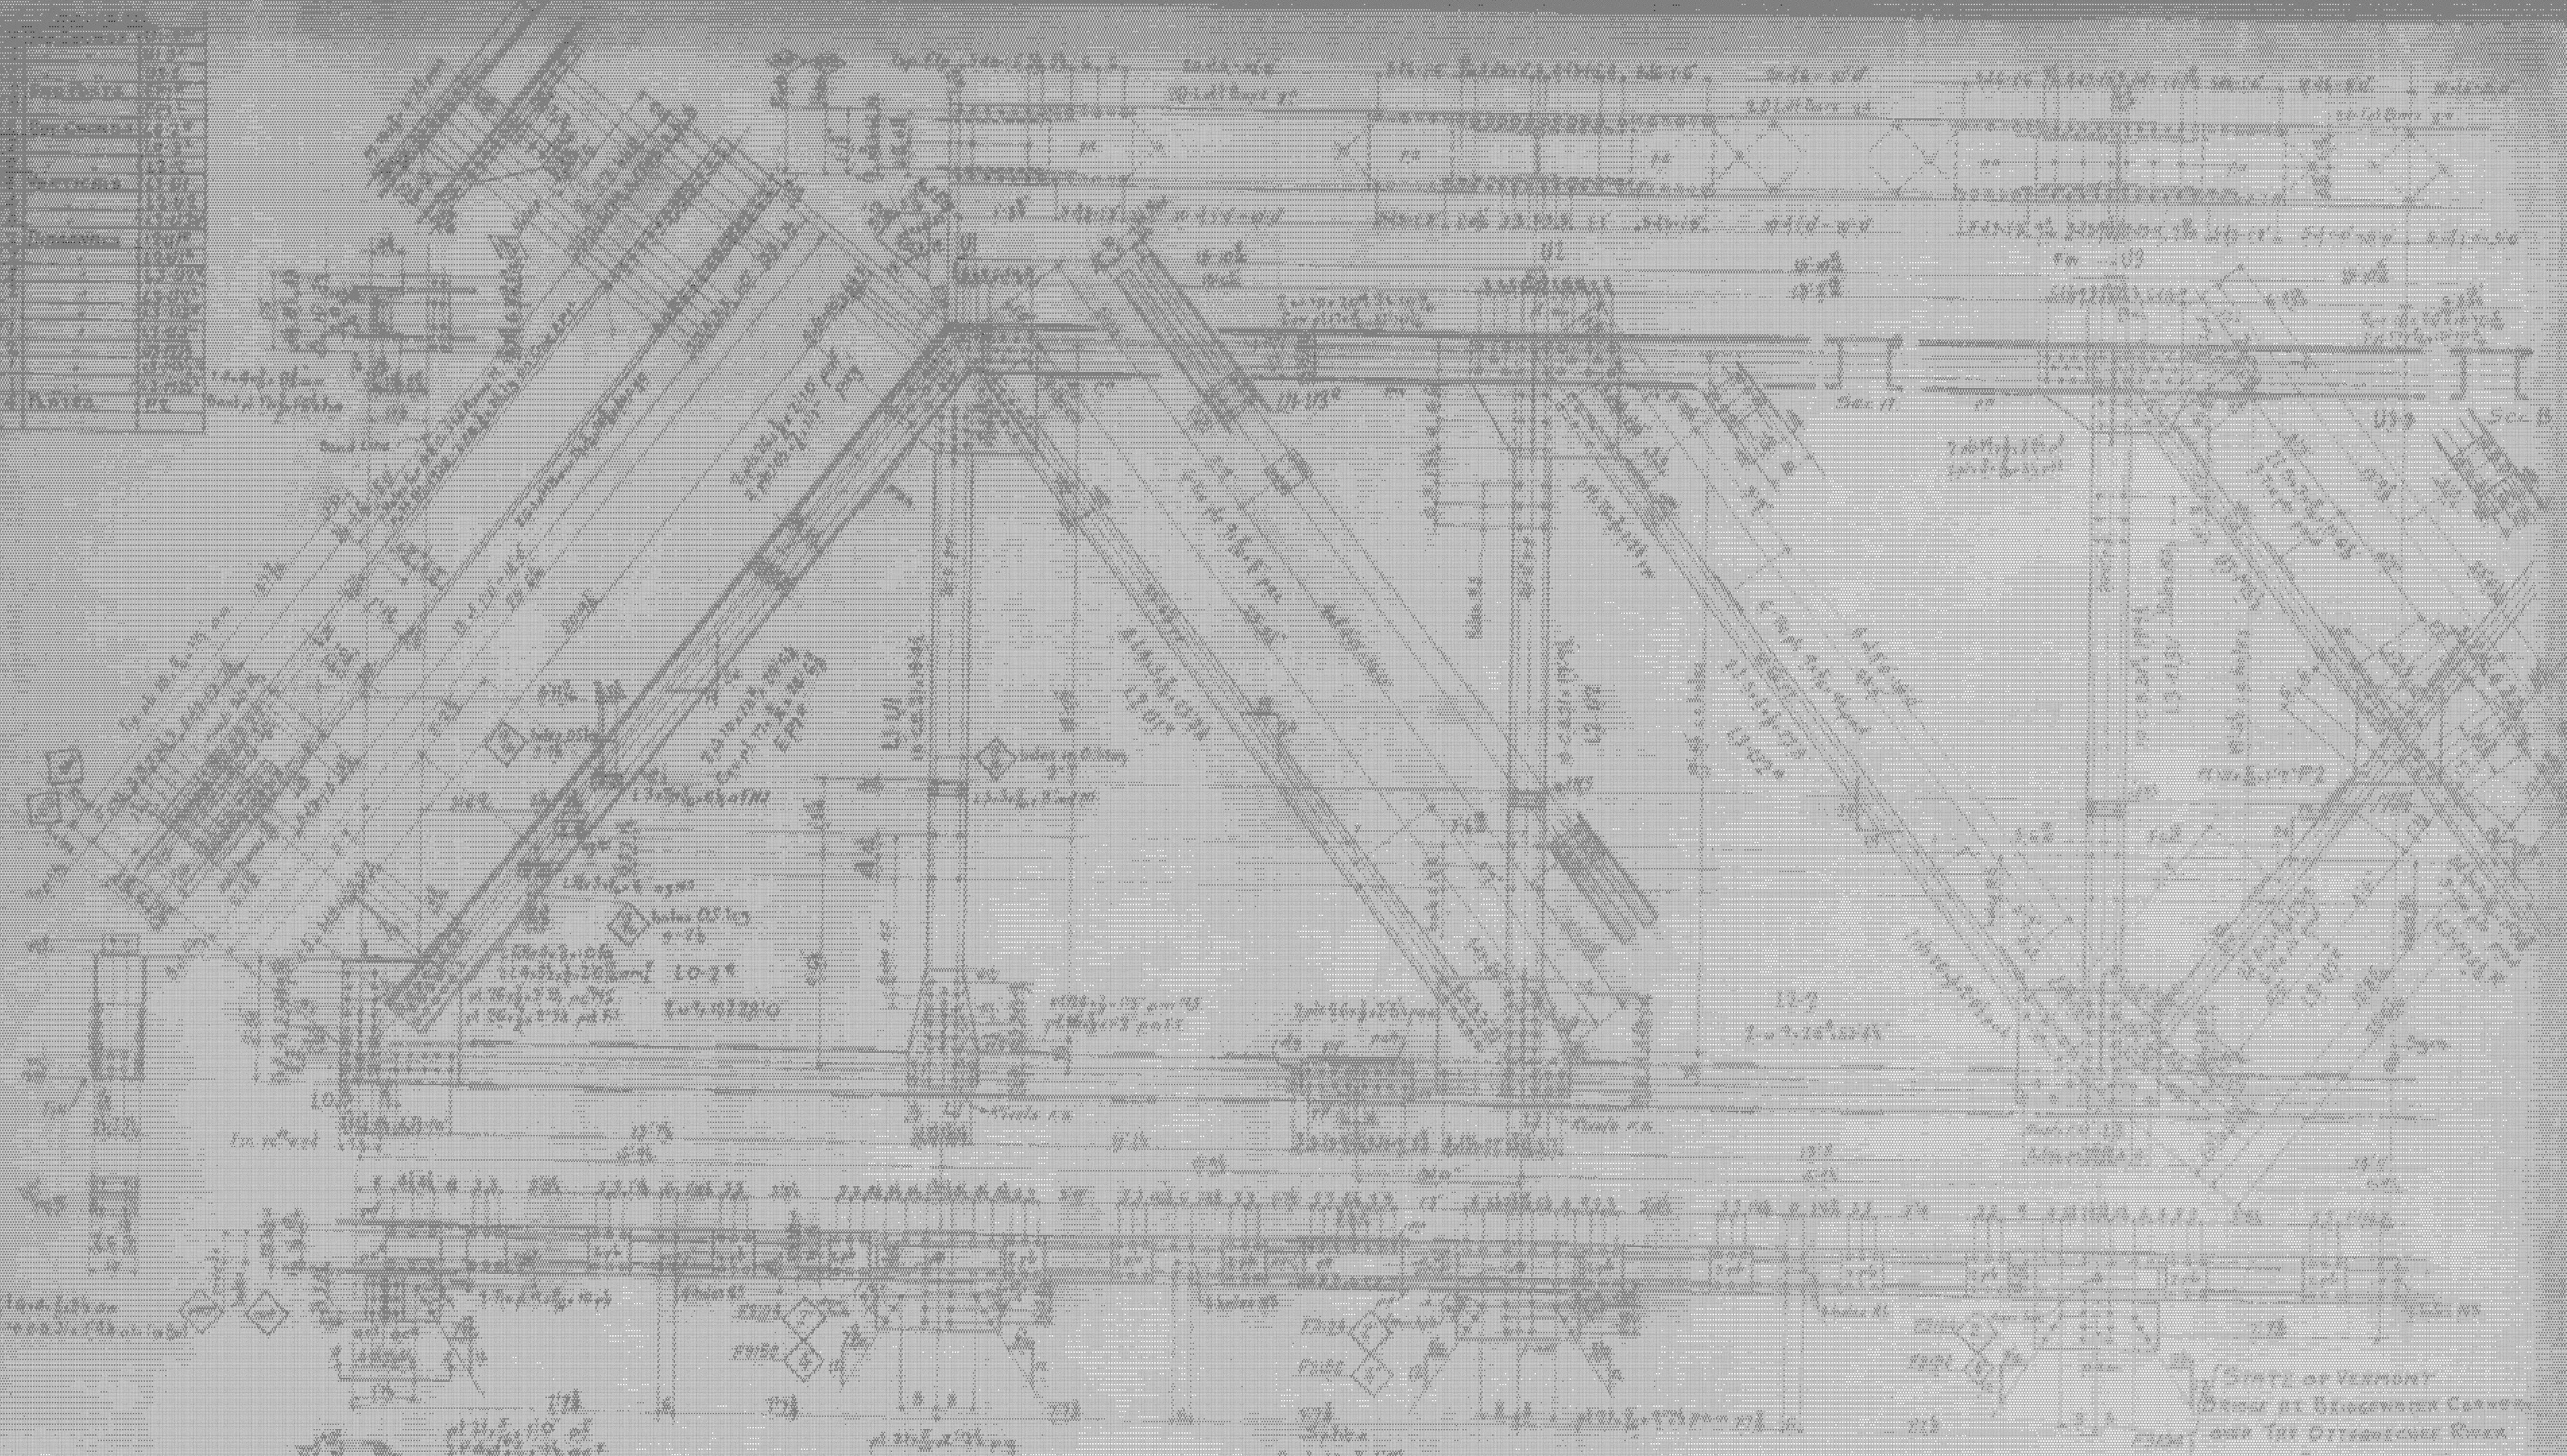

State of Vermont  
 State Engineer  
 Office at Waterbury  
 Vermont

