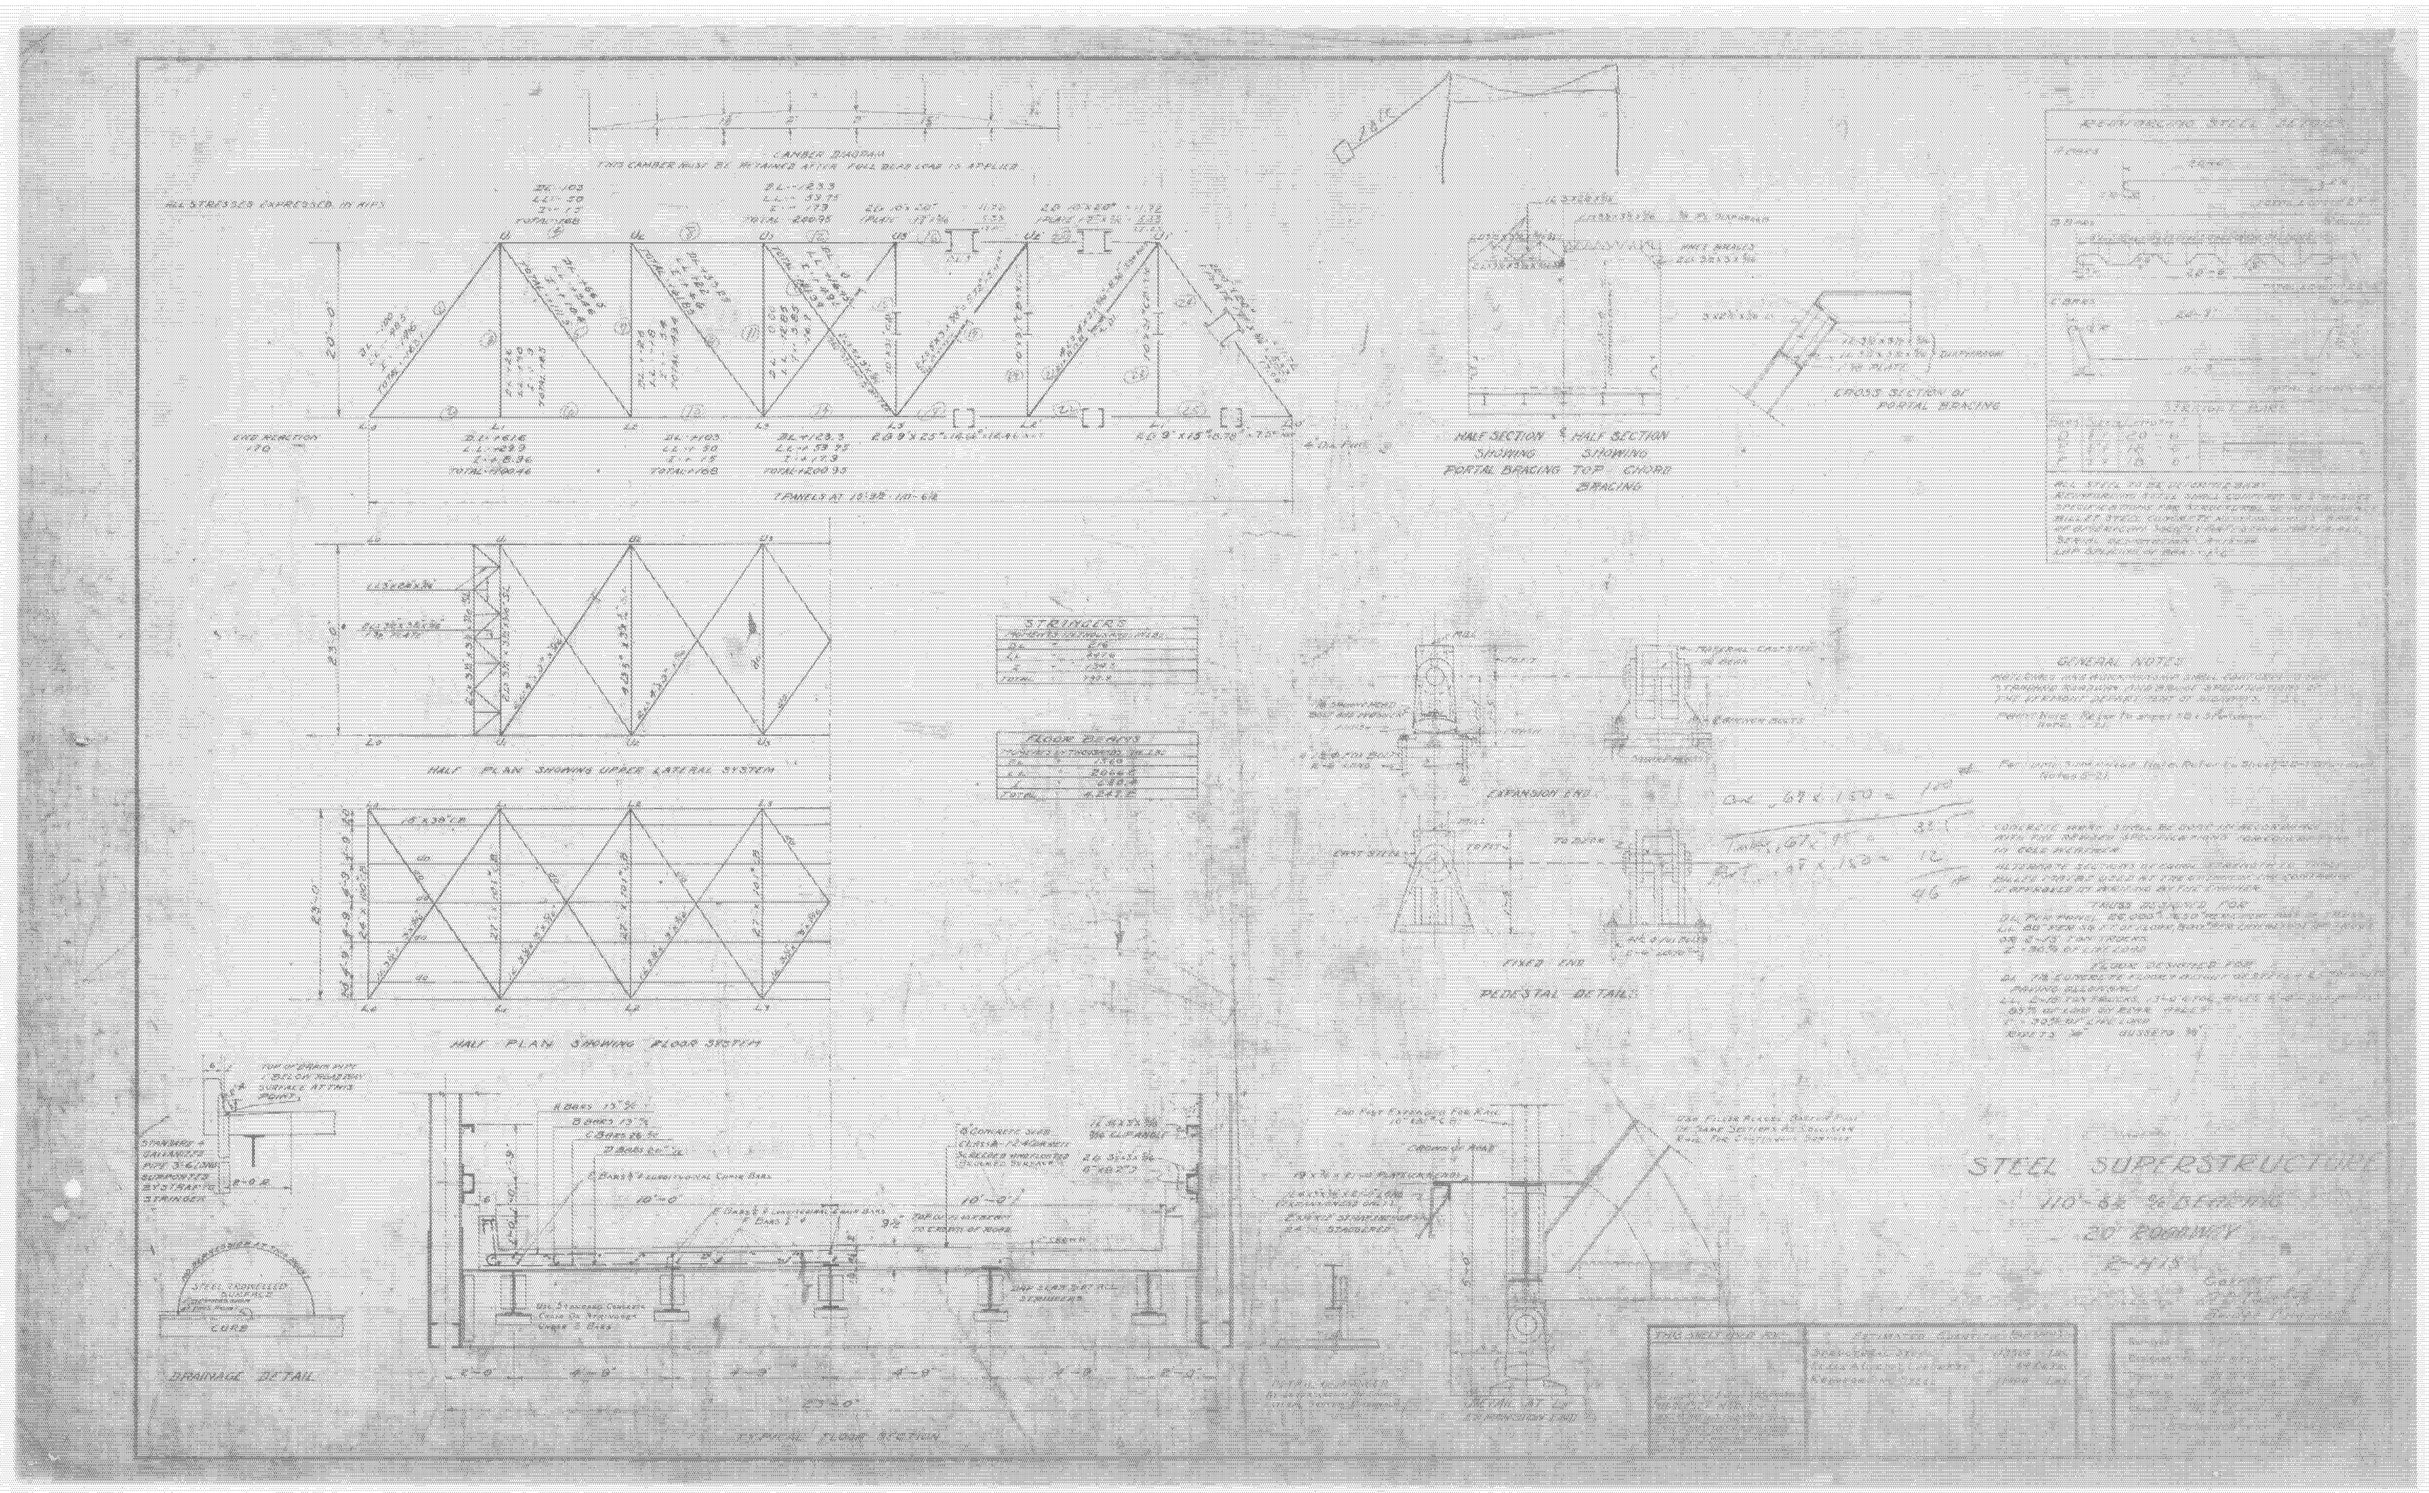
CAMBER DIAGRAM
THIS CAMBER MUST BE RETAINED AFTER FULL DEAD LOAD IS APPLIED
ALL STRESSES EXPRESSED IN KIPS
END REACTION
HALF SECTION SHOWING PORTAL BRACING
HALF SECTION SHOWING TOP CHORD BRACING
CROSS SECTION OF PORTAL BRACING
STRINGERS
FLOOR BEAMS
HALF PLAN SHOWING UPPER LATERAL SYSTEM
HALF PLAN SHOWING FLOOR SYSTEM
EXPANSION END
FIXED END
PEDESTAL DETAILS
GENERAL NOTES
DRAINAGE DETAIL
TYPICAL FLOOR SECTION
STEEL SUPERSTRUCTURE
110'-8½" SPAN LENGTH
20' ROADWAY
E-H15