128 STRUCTURAL STEEL

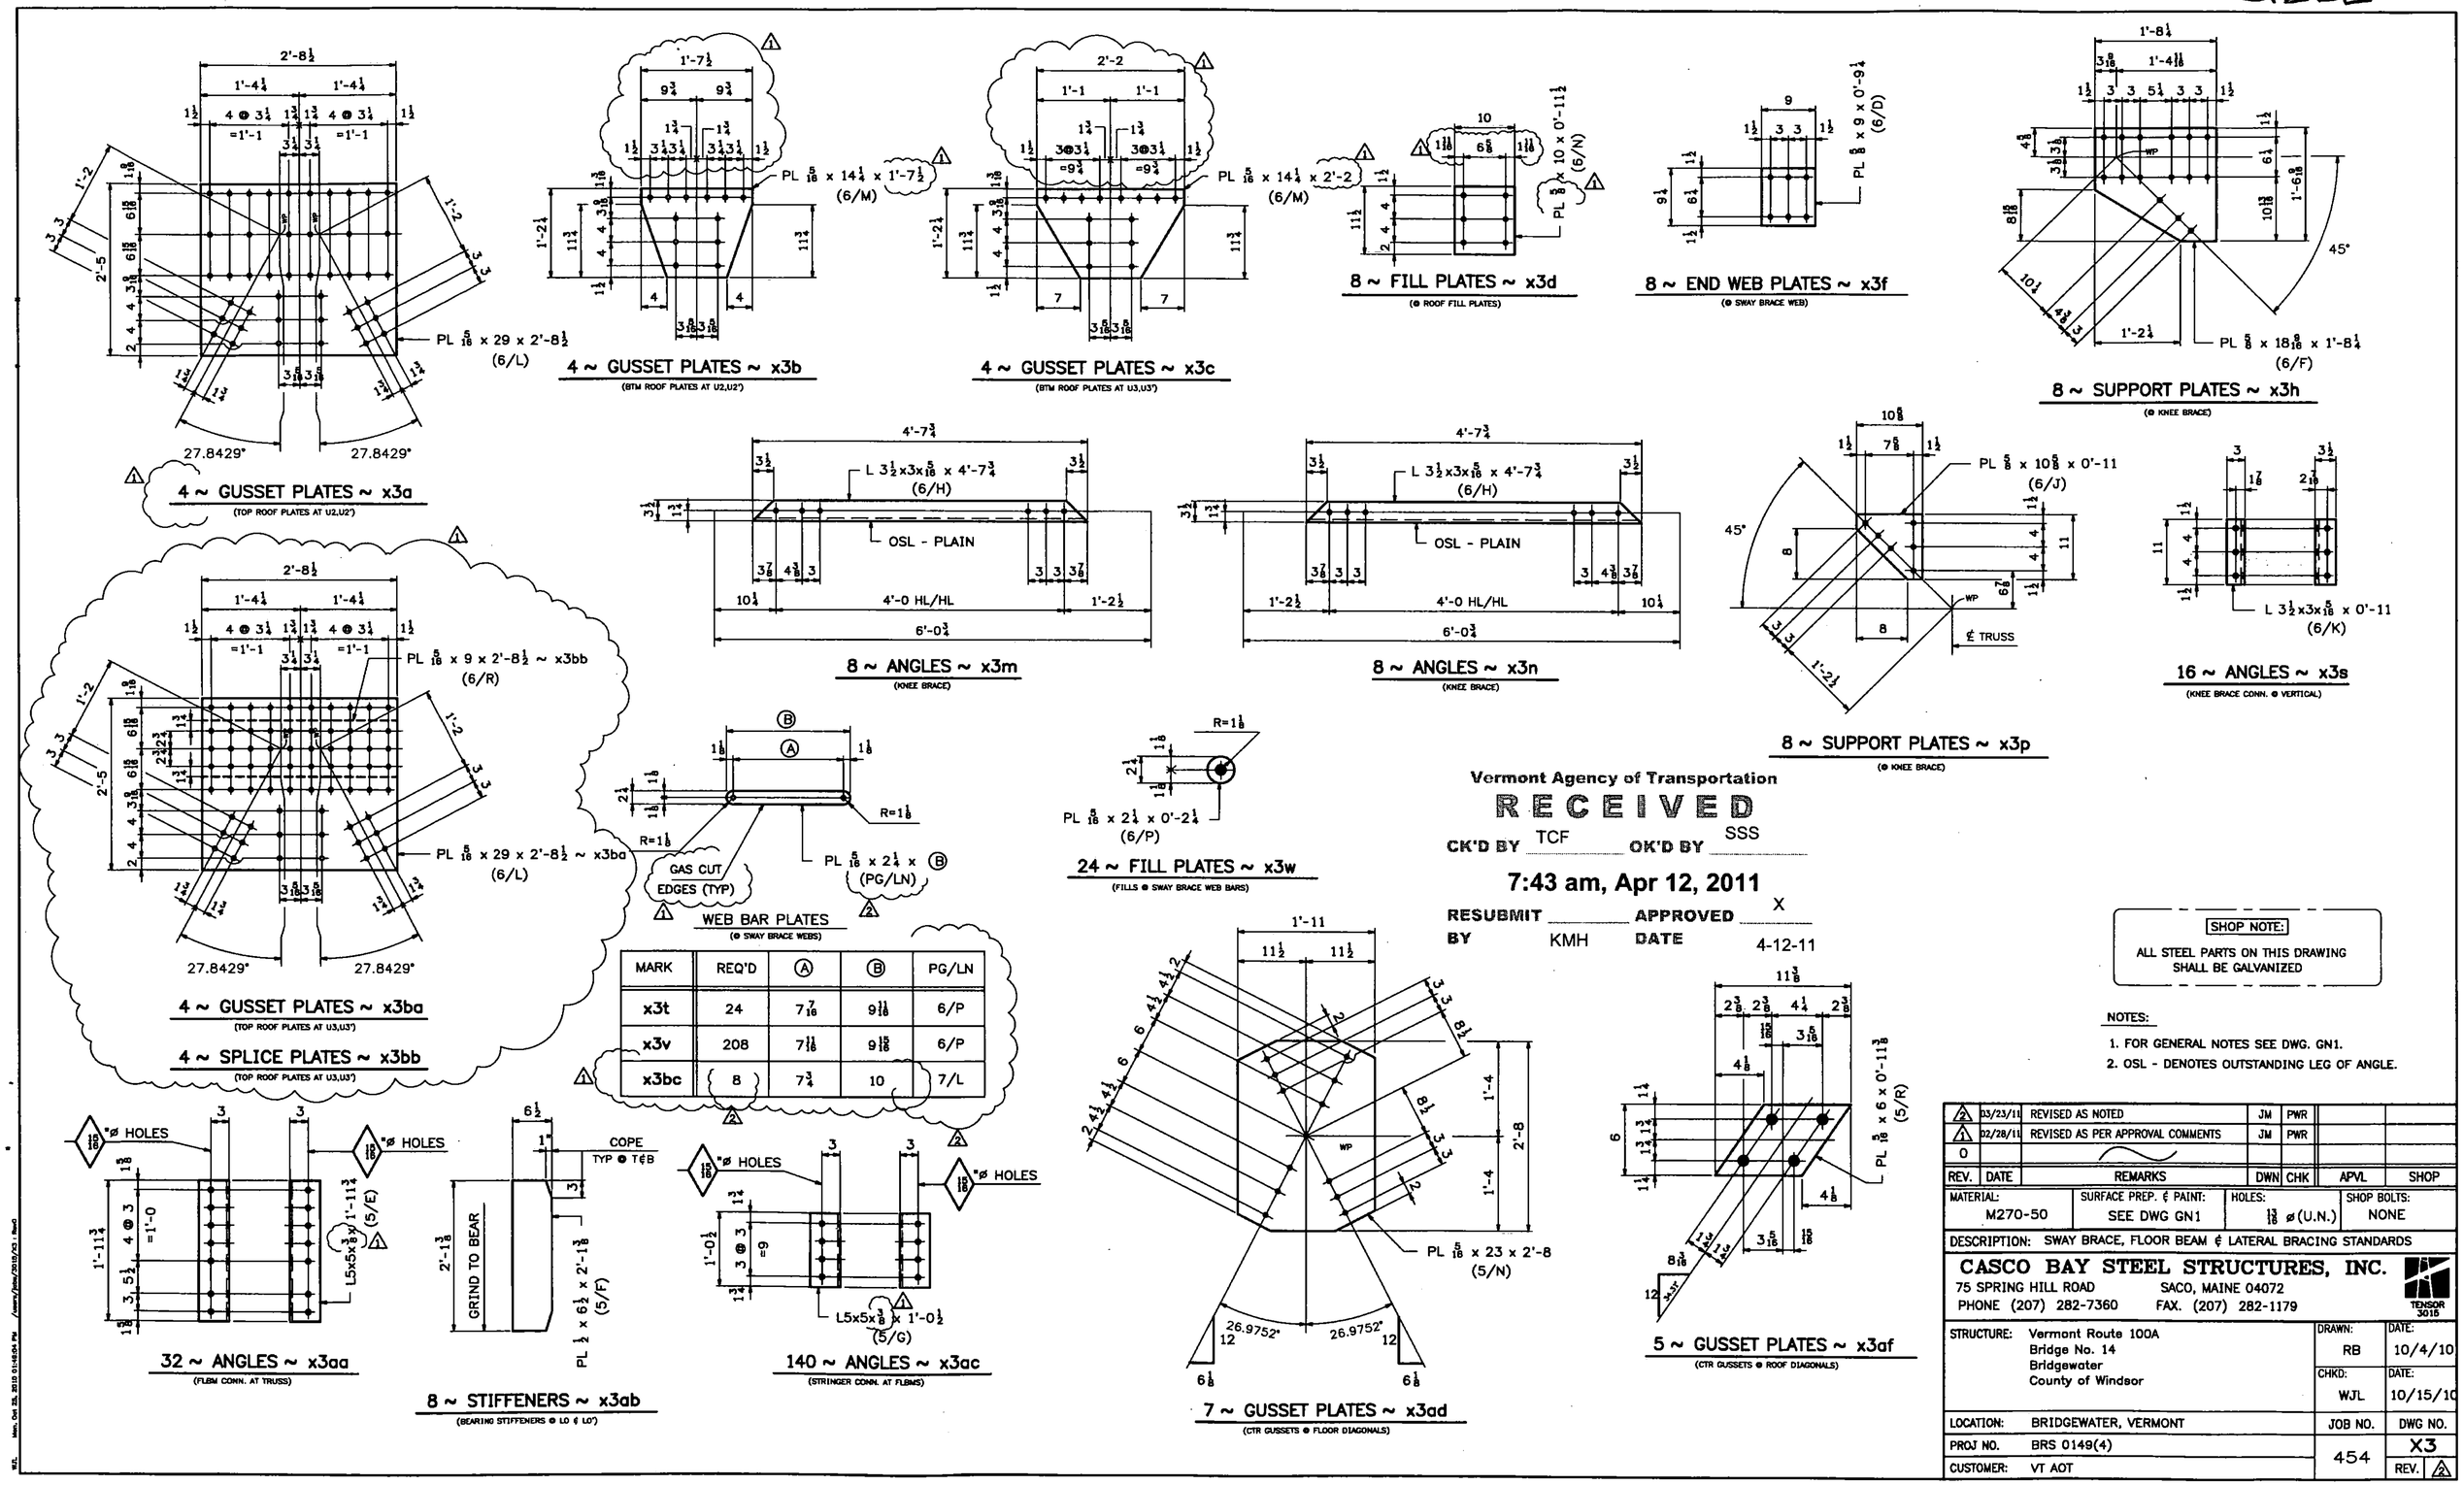


| MARK | REQ'D | Ⓐ | Ⓑ | PG/LN |
|---|---|---|---|---|
| x3t | 24 | 7 7/16 | 9 11/16 | 6/P |
| x3v | 208 | 7 11/16 | 9 15/16 | 6/P |
| x3bc | 8 | 7 3/4 | 10 | 7/L |

Vermont Agency of Transportation
RECEIVED
CK'D BY TCF OK'D BY SSS
7:43 am, Apr 12, 2011
RESUBMIT ____ APPROVED X
BY KMH DATE 4-12-11

SHOP NOTE:
ALL STEEL PARTS ON THIS DRAWING SHALL BE GALVANIZED

NOTES:
1. FOR GENERAL NOTES SEE DWG. GN1.
2. OSL - DENOTES OUTSTANDING LEG OF ANGLE.

| REV. | DATE | REMARKS | DWN | CHK | APVL | SHOP |
|---|---|---|---|---|---|---|
| 2 | 03/23/11 | REVISED AS NOTED | JM | PWR | | |
| 1 | 02/28/11 | REVISED AS PER APPROVAL COMMENTS | JM | PWR | | |
| 0 | | | | | | |

| MATERIAL: | SURFACE PREP. ℄ PAINT: | HOLES: | SHOP BOLTS: |
|---|---|---|---|
| M270-50 | SEE DWG GN1 | 13/16 ø (U.N.) | NONE |

DESCRIPTION: SWAY BRACE, FLOOR BEAM ℄ LATERAL BRACING STANDARDS


CASCO BAY STEEL STRUCTURES, INC.
75 SPRING HILL ROAD SACO, MAINE 04072
PHONE (207) 282-7360 FAX. (207) 282-1179
TENSOR 3015


| | | | |
|---|---|---|---|
| STRUCTURE: | Vermont Route 100A<br>Bridge No. 14<br>Bridgewater<br>County of Windsor | DRAWN: RB | DATE: 10/4/10 |
| | | CHKD: WJL | DATE: 10/15/10 |
| LOCATION: | BRIDGEWATER, VERMONT | JOB NO. | DWG NO. |
| PROJ NO. | BRS 0149(4) | 454 | X3 |
| CUSTOMER: | VT AOT | | REV. 2 |