140 STRUCTURAL STEEL

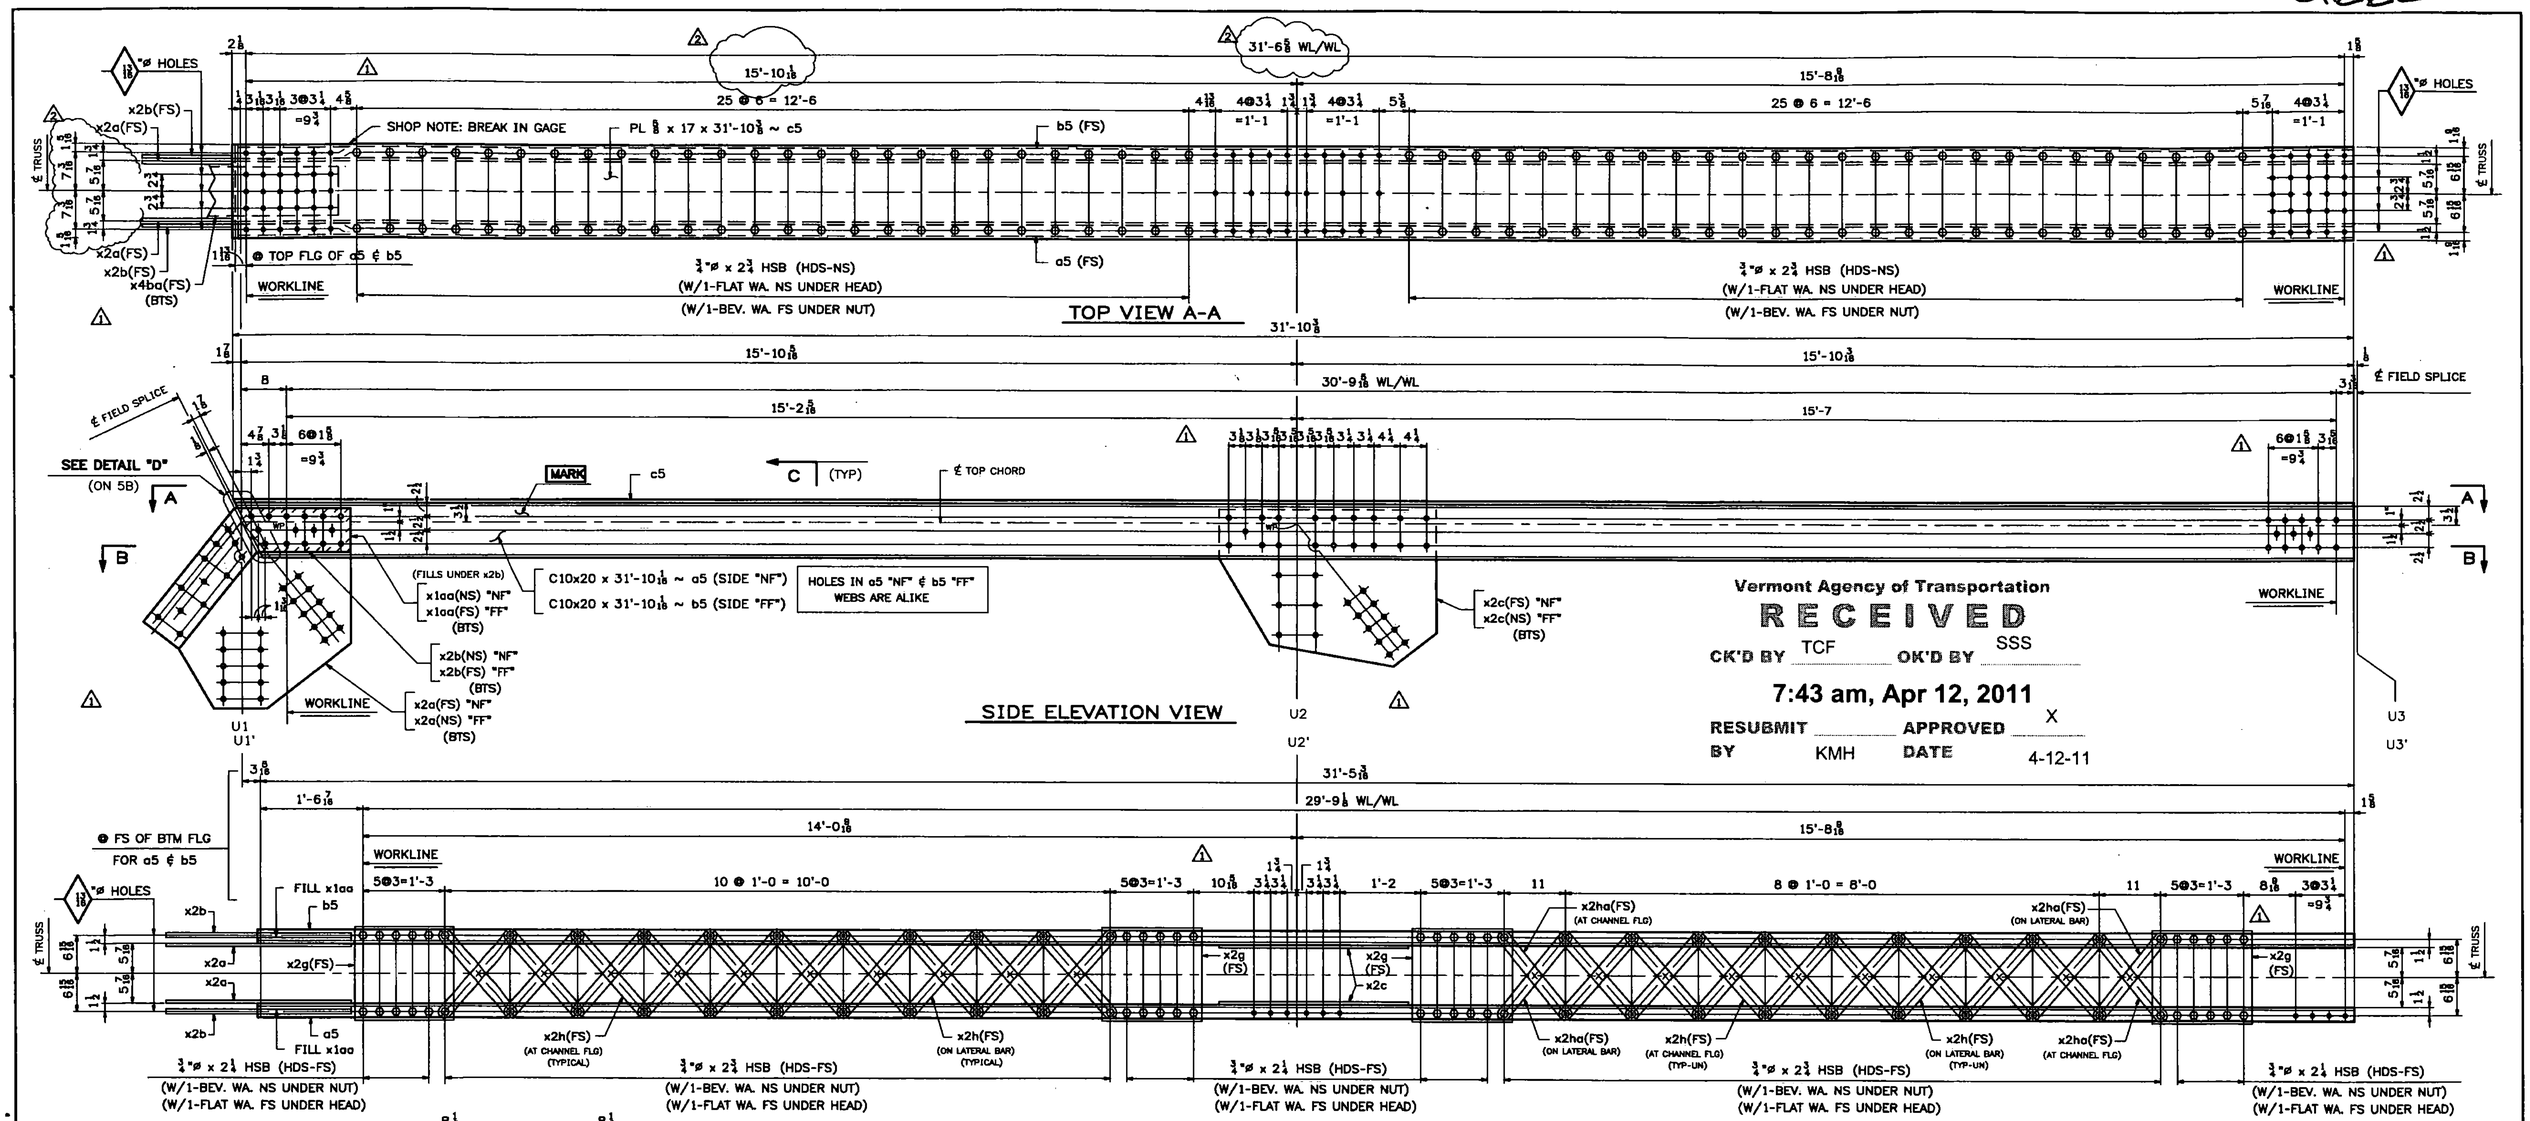

Vermont Agency of Transportation
RECEIVED
CK'D BY TCF OK'D BY SSS
7:43 am, Apr 12, 2011
RESUBMIT ____ APPROVED X
BY KMH DATE 4-12-11

ONE - TOP CHORD - 5TC1W
(U1-U3 WEST)

ONE - TOP CHORD - 5TC3E
(U1'-U3' EAST)

ALIKE EXCEPT FOR MARK

SHOP NOTE:
ALL STEEL FOR TOP CHORD ASSEMBLIES SHALL BE GALVANIZED

NOTES:

1. FOR GENERAL NOTES SEE DWG. GN1.
2. FOR STANDARD DETAILS SEE DWG. X1 ¢ X2.
3. "NF" - DENOTES NEAR FACE OF ASS'Y.
4. "FF" - DENOTES FAR FACE OF ASS'Y.
5. "BF" - DENOTES BOTH FACES OF ASSEMBLY.
6. ALL BOLTS SHALL BE FULLY TORQUED (UN).
7. BTS - DENOTES BOLT TO SHIP OR SECURE FOR SHIPMENT.
8. HDS - DENOTES BOLT HEADS.

WORK THIS DWG. WITH DWG. 5B.

REV.	DATE	REMARKS	DWN	CHK	APVL	SHOP
2	03/23/11	REVISED AS NOTED	JM	PWR		
1	03/01/11	REVISED AS PER APPROVAL COMMENTS	JM	PWR		
0						

MATERIAL:	SURFACE PREP. ¢ PAINT:	HOLES:	SHOP BOLTS:
M270-50 (U.N.)	SEE DWG GN1	15/16 ø(U.N.)	AS NOTED

DESCRIPTION: TOP CHORD 5TC1W ¢ 5TC3E

CASCO BAY STEEL STRUCTURES, INC.
75 SPRING HILL ROAD SACO, MAINE 04072
PHONE (207) 282-7360 FAX. (207) 282-1179
TENSOR 3015

STRUCTURE:	Vermont Route 100A Bridge No. 14 Bridgewater County of Windsor	DRAWN: RB	DATE: 9/28/10
		CHKD: WJL	DATE: 10/18/10
LOCATION:	BRIDGEWATER, VERMONT	JOB NO.	DWG NO.
PROJ NO.	BRS 0149(4)	454	5AB
CUSTOMER:	VT AOT		REV. 2