STRUCTURAL
146 STEEL

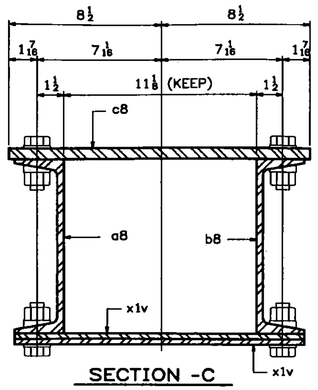

SECTION -C
(TYPICAL PORTAL TOP CHORD SECTION)
(ENLARGED)
(ON 8AB)

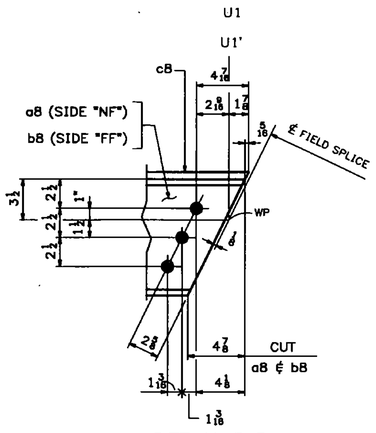

DETAIL "E"
(ENLARGED) (ON 8AB)
(WEB FILL PLATES NOT SHOWN FOR CLARITY)

ABM INFO		SHIP	BILL OF MATERIAL					JOB NO. 454	DRAWING NO. 8B	REV.
PAGE	LINE	MARK	QTY	MARK	MATERIAL	LENGTH FT	LENGTH INCHES	REMARKS	WT	PROCUREMENT NOTES
		BD1W	1		PORTAL TOP CHORD			ALIKE EXCEPT	2318	
		BD9E	1		PORTAL TOP CHORD			FOR MARK	2318	
3	B		2	a8	C 10x20	24	5 9/16	(GALVANIZED) M270-50T2		
3	B		2	b8	C 10x20	24	5 9/16	(GALVANIZED) M270-50T2		
3	C		2	c8	PL 5/8x17	24	5 7/8	(GALVANIZED) M270-50T2		
2	P		64	x1v	PL 5/16x2¼	1	8 13/16	(GALVANIZED)		
2	P		8	x1w	PL 5/16x2¼	1	8½	(GALVANIZED)		
3	M		4	x1y	PL ½x8 △1	2	0 5/8	(GALVANIZED)		
3	E		2	x2k	PL 5/16x13½ △2	2	2 13/16	(GALVANIZED)		
3	F		2	x2m	PL ½x18	2	2 13/16	(GALVANIZED)		
3	J		2	x2w	L 4x4x⅜	2	8¾	(GALVANIZED)		
3	J		2	x2y	L 4x4x⅜ △2	2	8¾	(GALVANIZED)		
3	K		2	x2ac	PL 5/16x17	1	6	(GALVANIZED)		
3	L		4	x2ad	PL ½x4 △2	1	4¼	(GALVANIZED)		
10	D		28		¾ ø HSB	0	2¼	(GALVANIZED) A325-1		
10	E		20		¾ ø HSB	0	2½	(GALVANIZED) A325-1		
10	F	△1	264		¾ ø HSB	0	2¾	(GALVANIZED) A325-1		
10	G		20		¾ ø HSB	0	3	(GALVANIZED) A325-1		
10	P		332		1 ø HSW			(GALVANIZED) F436		
10	Q		332		BEVEL WASH FOR ¾ ø HSB			(GALVANIZED) F436		

T2 - DENOTES MATERIAL SUBJECT TO CHARPY V-NOTCH TESTING

Vermont Agency of Transportation
RECEIVED
CK'D BY TCF OK'D BY SSS
7:43 am, Apr 12, 2011
RESUBMIT APPROVED X
BY KMH DATE 4-12-11

WORK THIS DWG. WITH DWG. 8AB.

REV.	DATE	REMARKS	DWN	CHK	APVL	SHOP
△2	03/23/11	REVISED AS PER APPROVAL COMMENTS	JM	PWR		
△1	03/02/11	REVISED AS PER APPROVAL COMMENTS	JM	PWR		
0						

MATERIAL:	SURFACE PREP. & PAINT:	HOLES:	SHOP BOLTS:
M270-50 (U.N.)	SEE DWG GN1	13/16 ø(U.N.)	AS NOTED

DESCRIPTION: PORTAL TOP CHORD 8D1W & 8D9E

CASCO BAY STEEL STRUCTURES, INC.
75 SPRING HILL ROAD SACO, MAINE 04072
PHONE (207) 282-7360 FAX. (207) 282-1179
TENSOR 3015

STRUCTURE:	Vermont Route 100A Bridge No. 14 Bridgewater County of Windsor	DRAWN: RB	DATE: 9/30/10
		CHKD: WJL	DATE: 10/19/10
LOCATION:	BRIDGEWATER, VERMONT	JOB NO. 454	DWG NO. 8B
PROJ NO.	BRS 0149(4)		REV. △2
CUSTOMER:	VT AOT		

WL Mon, Oct 25, 2010 01:03:37 PM //casco/jobs/2010/454 | Rev0