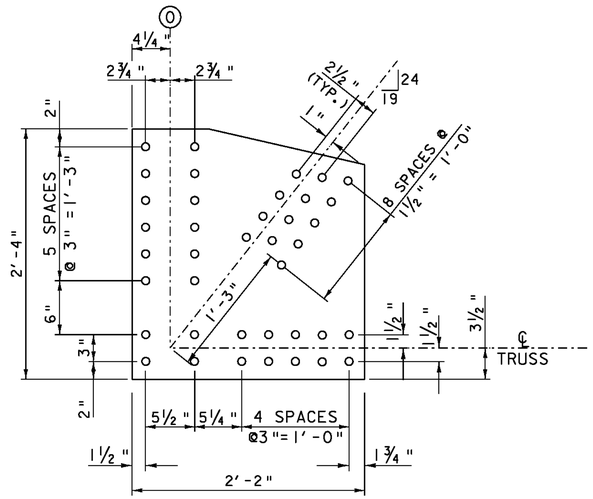

L0 PLATES DETAIL

PL½x26x2'-4"

SCALE 1½" = 1'-0"

9 6 3 0

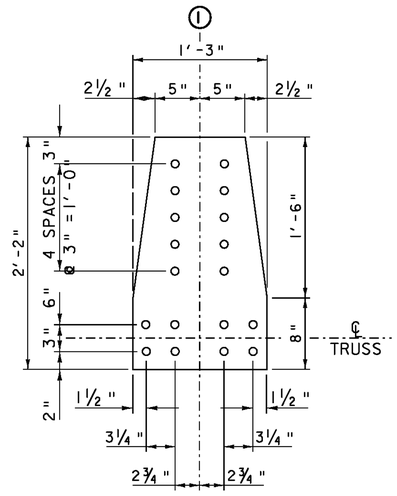

L1 PLATES DETAIL

PL½x15x2'-2"

SCALE 1½" = 1'-0"

9 6 3 0

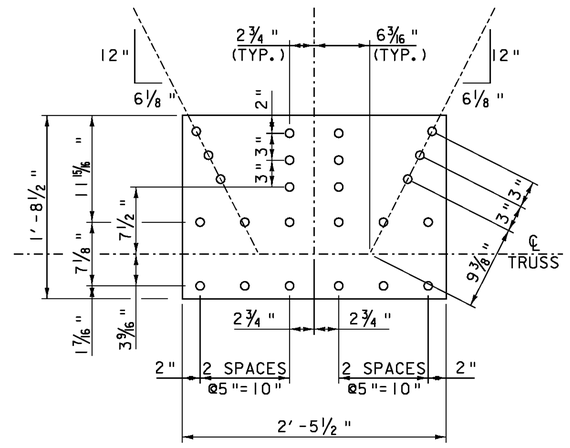

TYPICAL FLOOR PLATE

PL5⁄16x20½x2'-5½"

SCALE 1½" = 1'-0"

9 6 3 0

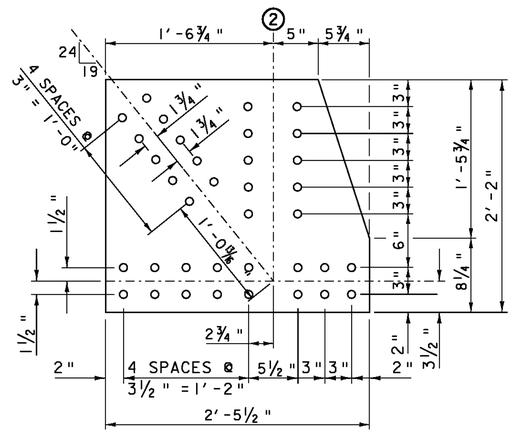

L2 PLATE DETAIL

PL½x26x2'-5½"

SCALE 1½" = 1'-0"

9 6 3 0

℄ TRUSS

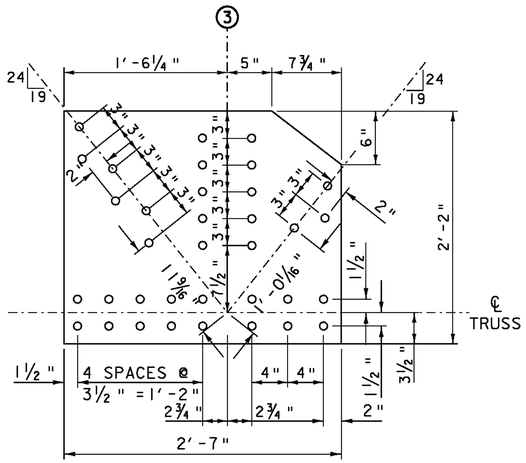

L3 PLATE DETAIL

PL½x26x2'-7"

SCALE 1½" = 1'-0"

9 6 3 0

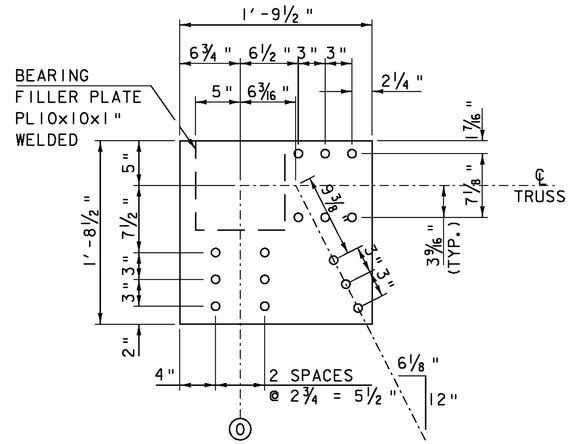

FLOOR END PLATE

PL5⁄16x20½x1'-9½"

SCALE 1½" = 1'-0"

9 6 3 0

ALL PLATES ON THIS SHEET SHALL BE CHARPY V-NOTCH (CVN) TESTED.

TYPICAL FLOOR PLATE AND FLOOR END PLATE SHALL USE 3/4" DIA. BOLTS IN 13/16" DIA. BOLT HOLES. MIN. BOLT HOLE END AND EDGE DISTANCE 1½" UNLESS NOTED
⅞" DIA. BOLTS UNLESS NOTED
15⁄16" DIA. HOLES UNLESS NOTED

PROJECT NAME: BRIDGEWATER
PROJECT NUMBER: BRS 0149(4)

FILE NAME: s86e062truss.dgn
PROJECT LEADER: K. HIGGINS
DESIGNED BY: T. FILLBACH
BOTTOM CHORD GUSSET PLATES

PLOT DATE: 31-DEC-2009
DRAWN BY: C. MOONEY
CHECKED BY: T. FILLBACH
SHEET 23 OF 58