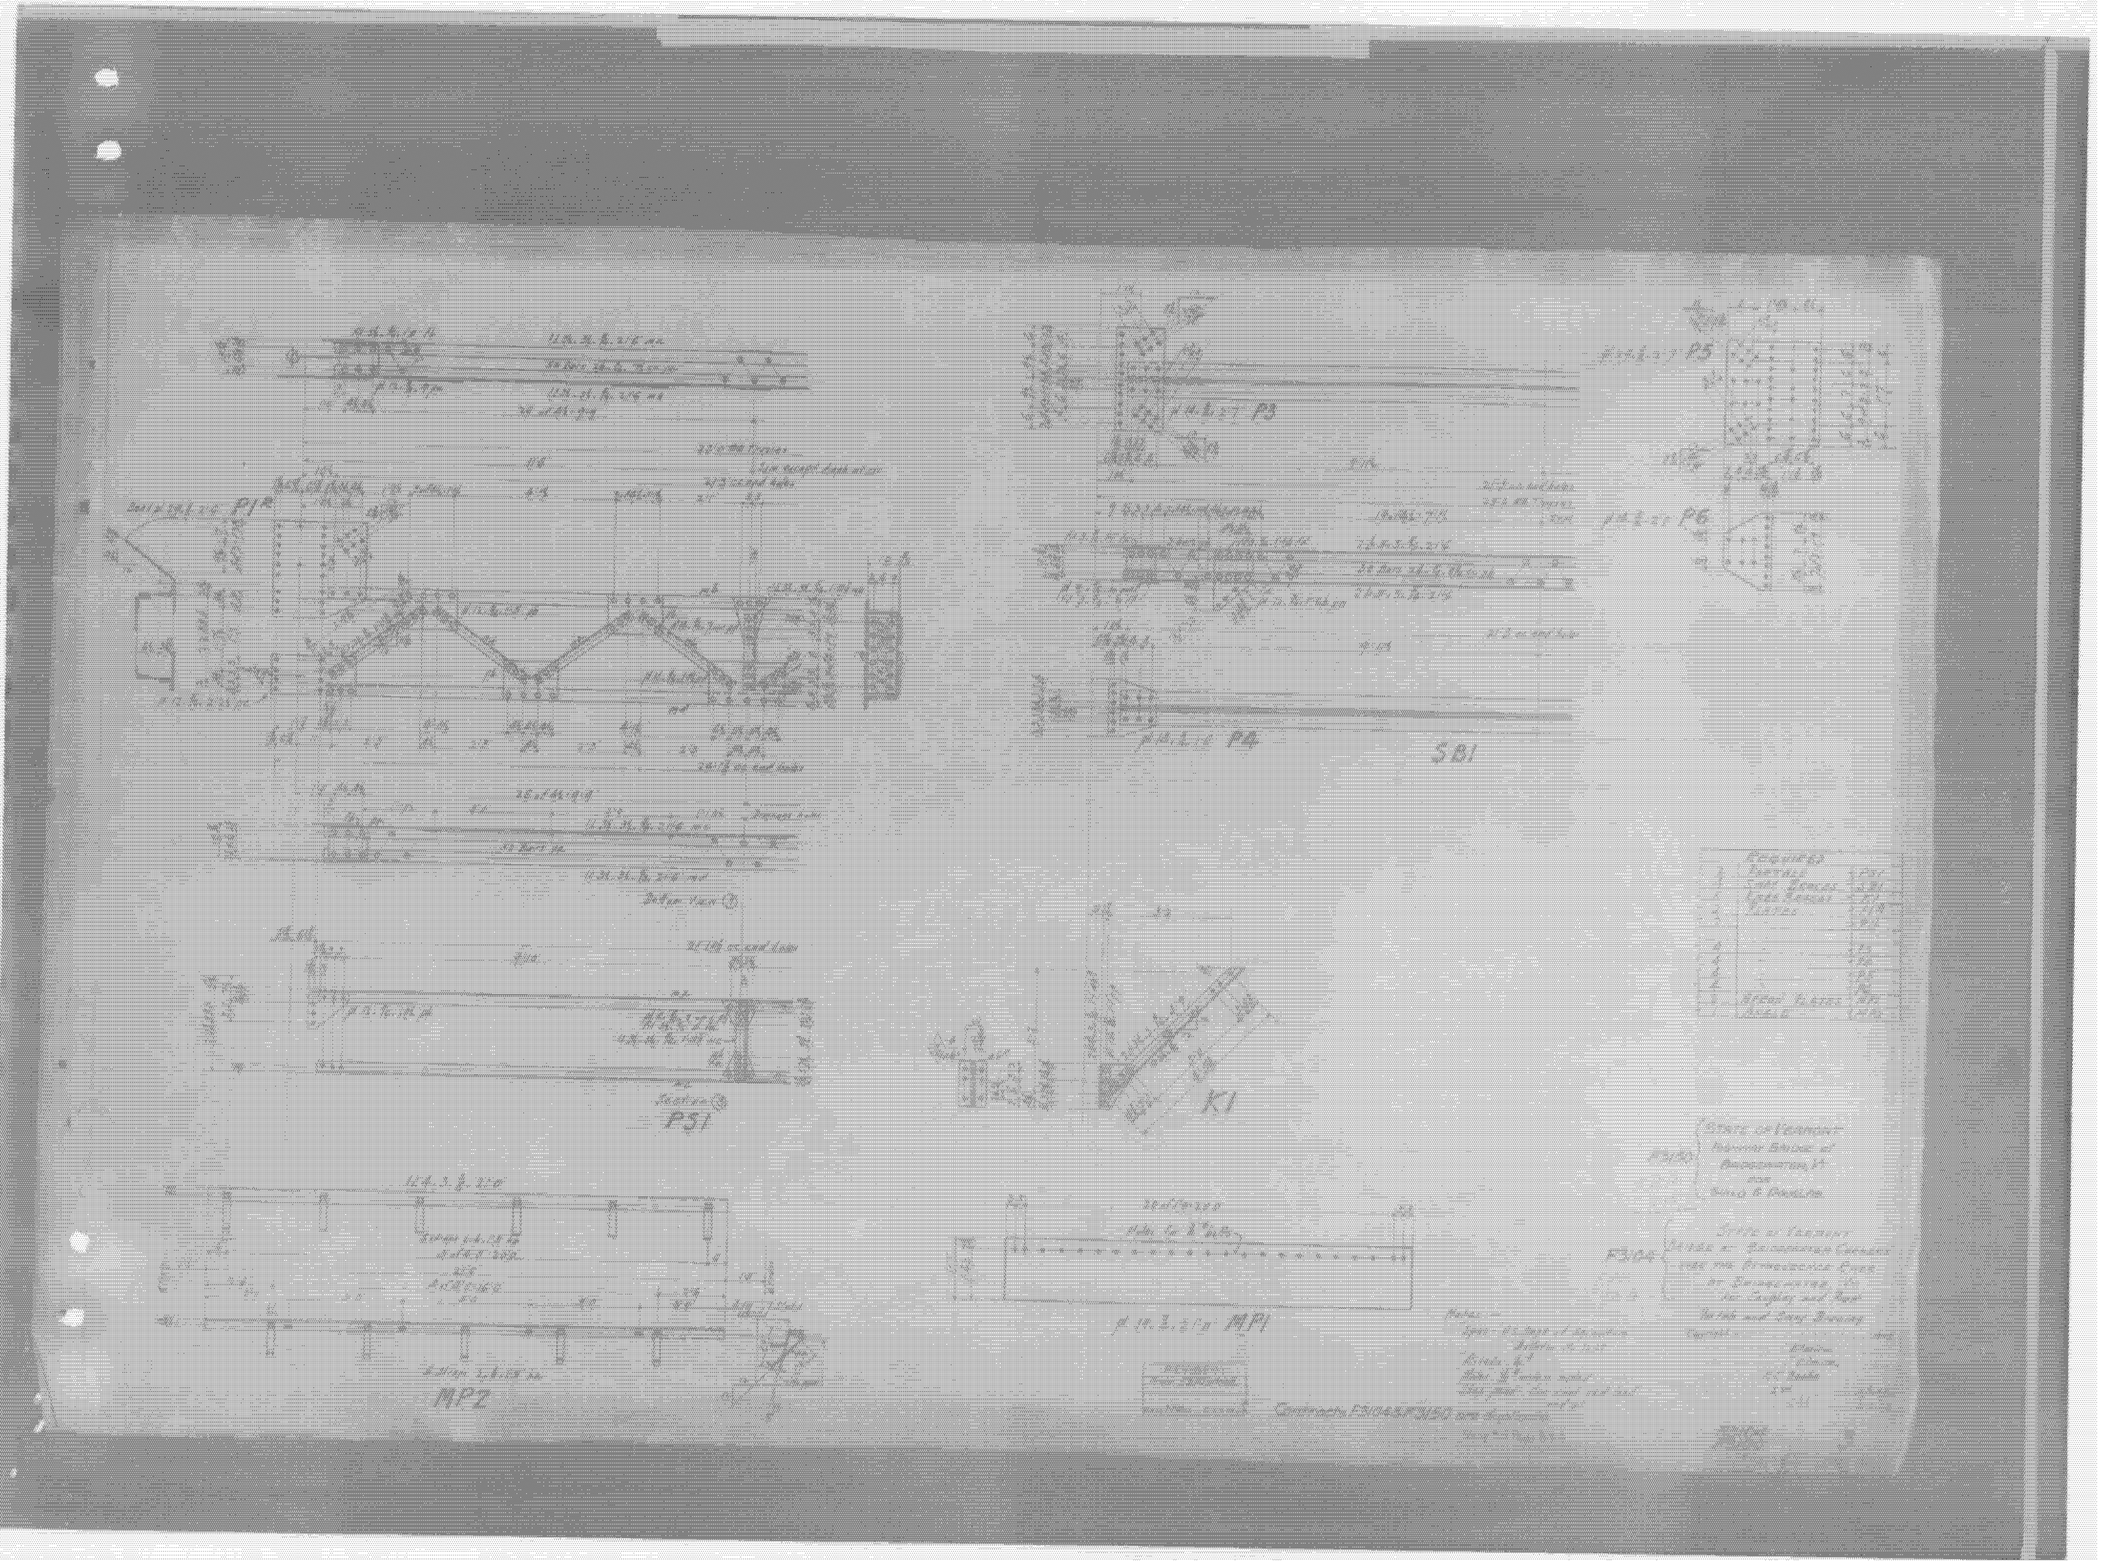
P1
P3
P5
P6
P4
SB1
P51
K1
MP1
MP2