138 STRUCTURAL STEEL

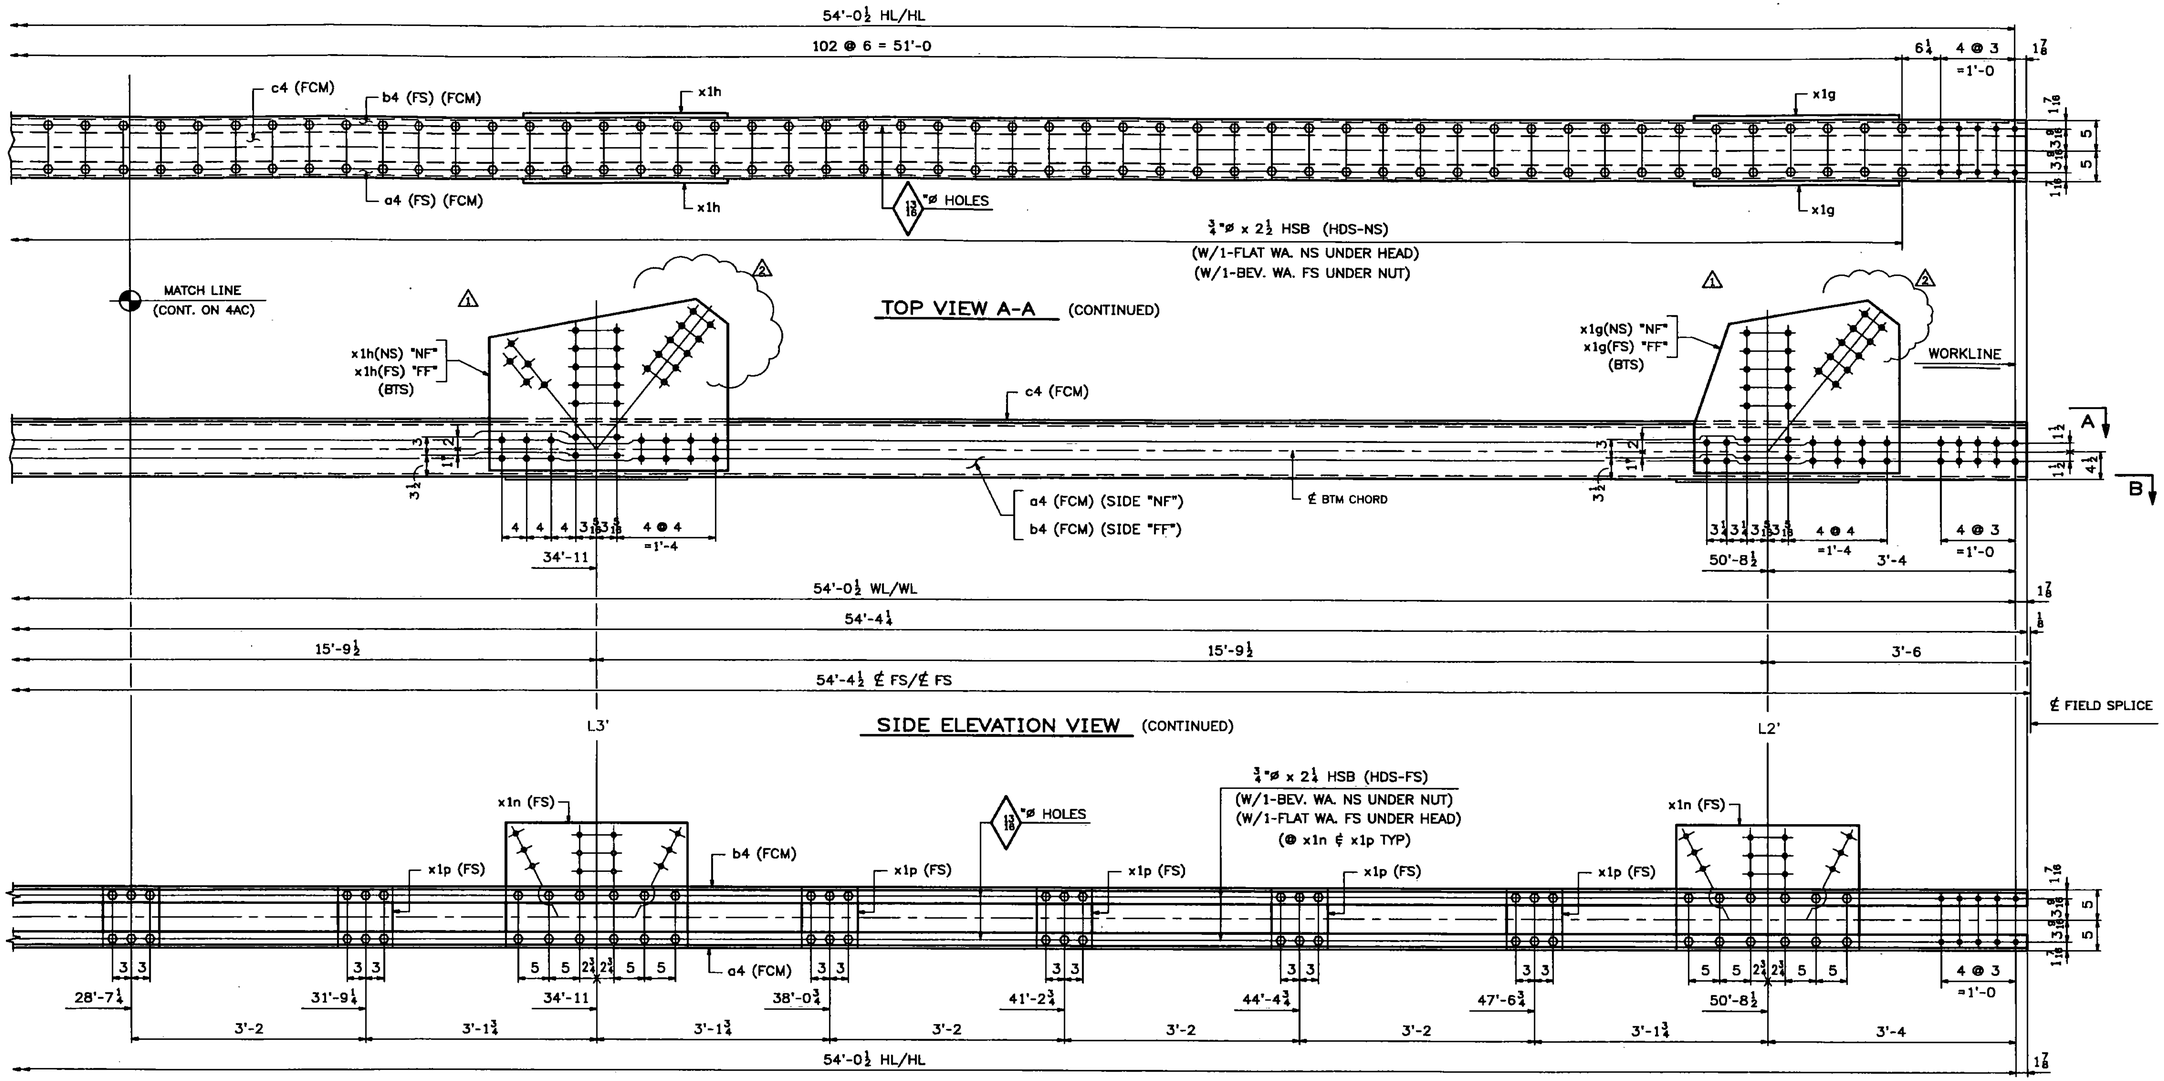

BOTTOM SECTION B-B (CONTINUED)

ONE - BOTTOM CHORD - 4BC2E (CONTINUED)
(L2-L2' EAST)

SHOP NOTE:
ALL STEEL FOR BOTTOM CHORD ASSEMBLY SHALL BE GALVANIZED

Vermont Agency of Transportation
RECEIVED
CK'D BY TCF OK'D BY SSS
7:43 am, Apr 12, 2011
RESUBMIT ____ APPROVED X
BY KMH DATE 4-12-11

WORK THIS DWG. WITH DWG. 4AC ℄ 4C.

REV.	DATE	REMARKS	DWN	CHK	APVL	SHOP
2	03/23/11	REVISED AS PER APPROVAL COMMENTS	JM	PWR		
1	03/01/11	REVISED AS PER APPROVAL COMMENTS	JM	PWR		
0						

MATERIAL:	SURFACE PREP. ℄ PAINT:	HOLES:	SHOP BOLTS:
M270-50 (U.N.)	SEE DWG GN1	13/16 ø(U.N.)	AS NOTED

DESCRIPTION: BOTTOM CHORD 4BC2E

CASCO BAY STEEL STRUCTURES, INC.
75 SPRING HILL ROAD SACO, MAINE 04072
PHONE (207) 282-7360 FAX. (207) 282-1179

TENSOR 3015

STRUCTURE:	DRAWN:	DATE:
Vermont Route 100A Bridge No. 14 Bridgewater County of Windsor	RB	9/27/10
	CHKD: WJL	DATE: 10/18/10
LOCATION: BRIDGEWATER, VERMONT	JOB NO.	DWG NO.
PROJ NO. BRS 0149(4)	454	4BC
CUSTOMER: VT AOT		REV. 2

Mon, Oct 25, 2010 01:05:57 PM /users/jobs/2010/454/ | Revit