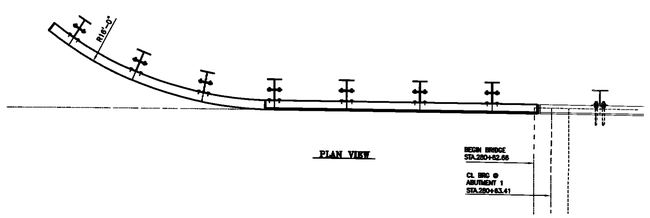

PLAN VIEW

BEGIN BRIDGE
STA.280+62.66

CL BRG @
ABUTMENT 1
STA.280+63.41

NOTE:
- RAIL LENGTHS DO NOT INCLUDE END CAPS AND/OR GAPS
- LENGTH OF APPROACH RAILING ON THIS SHEET IS 21.875 LF PAY LENGTH.
- LENGTHS SHOWN THUS ( ) ARE ACTUAL LENGTHS ALONG FRT FACE OF RAILING

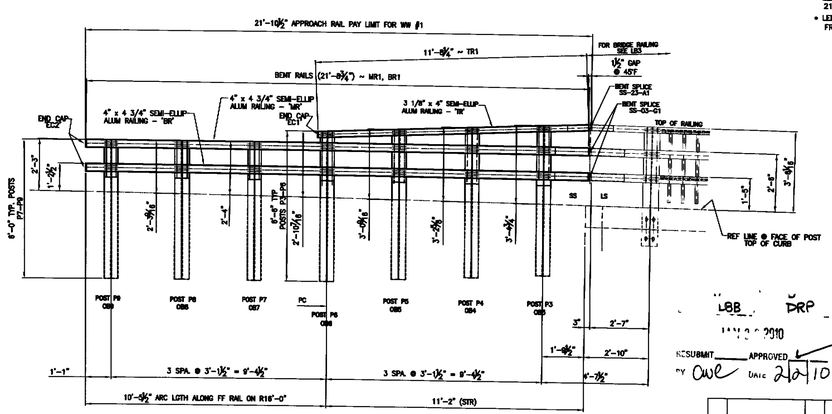

INSIDE ELEVATION OF WW #1 APPROACH RAIL

ANODIZED
(SEE LB1 FOR NOTES)

LBB DRP

RESUBMIT ____ APPROVED ✓
BY Owl DATE 2/2/10

REV	DESCRIPTION	BY	DATE

PROJECT No BHF 023-1(5) ITEM No: 900 840

APPROVED: ____ REC'D APPROVAL ____ DRAWING ____

L.B. FOSTER COMPANY
1016 GREENTREE ROAD
PITTSBURGH, PENNSYLVANIA 15220

FOR F.B. LAFAYETTE, INCORPORATED
VERMONT AGENCY OF TRANSPORTATION
TOWN OF FAIRFAX, COUNTY OF FRANKLIN
BRIDGE RAILING FOR BRIDGE #10, VT RTE 104 MINOR ARTERIAL
3L ALUMINUM APPROACH RAIL ELEVATIONS @ WW #1

MADE CMS DATE 11/08/08 JOB No. AR0600 CUST No.
CHECK Dd DATE 12/24/08 DRAWING LB9 REF No.