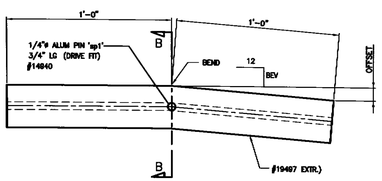

REAR ELEVATION VIEW

HANDRAIL SPLICES			
MK.	QTY.	OFFSET	BEV
SS-23-A1	2	11/16"	11/16
SS-23-A2	1	3/4"	3/4

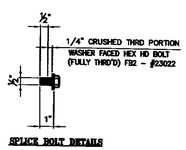

SPLICE BOLT DETAILS

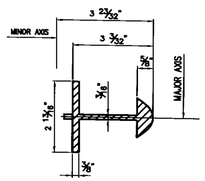

SECTION B-B

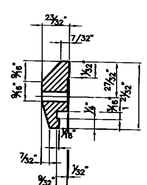

72 ~ REQ'D CLAMP
BAR CB-03-A
(BARRIER RAIL ~ 4 PER POST)
(#19447)

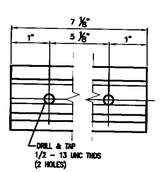

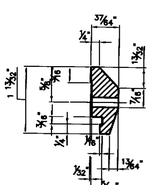

24 ~ REQ'D CLAMP
BAR CB-01-H
(HANDRAIL ~ 2 PER POST)
(#28596)

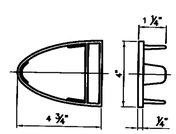

6 ~ REQ'D. ALUM
END CAPS EC2
#19345

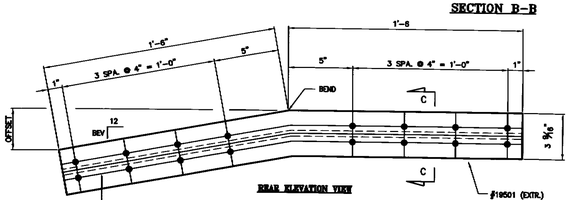

REAR ELEVATION VIEW

BARRIER RAIL SPLICES			
MK.	QTY.	OFFSET	BEV
SS-03-G1	4	3/16"	1/8
SS-03-G2	1	3/8"	1/4
SS-03-G3	1	5/16"	3/16

TYPICAL WELD DETAIL. ⚠1
● MITERED SPLICES (OPTIONAL IF REQ'D.)

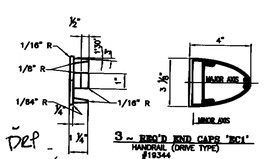

3 ~ REQ'D END CAPS 'EC1'
HANDRAIL (DRIVE TYPE)
#18344

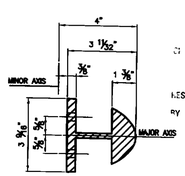

SECTION C-C

LBB DEP
2010
RESUBMIT ____ APPROVED ✓
BY OUC DATE 2/5/10

ANODIZED
(SEE NOTES ON LB1)

REV	DESCRIPTION	BY	DATE
⚠1	REVISED NOTATION FOR TYP. MITER WELD	CMS	01 22 10

PROJECT No. BHF 023-1(3) ITEM No: 900.5400
APPROVED ____ DATE APPROVAL ____
DRAWING ____

L.B. FOSTER COMPANY
1010 GREENSBURG ROAD
PITTSBURGH, PENNSYLVANIA 15220

FOR: F. R. LAFAYETTE, INCORPORATED
VERMONT AGENCY OF TRANSPORTATION
TOWN OF FAIRFAX, COUNTY OF FRANKLIN
BRIDGE RAILING FOR BRIDGE #10, VT RTE 104 MINOR ARTERIAL
3L ALUMINUM APPROACH RAIL ~ MISC DETAILS

DRWN CMS DATE 11/09/09 JOB No. #50600 CLIENT No. ____
CHECK RJL DATE 12/28/09 ORIGINAL 4218.04(4) SHT No. ONE