SEE SHEET 2 OF 79 FOR INDEX

STATE OF VERMONT
AGENCY OF TRANSPORTATION

CHESTER BRF 025-1(35)

THIS PROJECT WILL BEGIN ON VT 103 IN THE TOWN OF CHESTER APPROXIMATELY 3.807 MILES NORTH OF THE ROCKINGHAM - CHESTER TOWN LINE AND EXTEND NORTHEASTERLY 450' TO MM 3.892.
WORK TO BE PERFORMED INCLUDES REPLACEMENT OF BR 12 ON VT 103 AND IMPROVEMENT OF INTERSECTIONS, BRIDGE APPROACHES, GUARDRAILS, GRADING, DRAINAGE, AND SUBBASES.

LENGTH OF BRIDGE 12	110.03 FEET=	0.021 MILES
LENGTH OF ROADWAY	339.97 FEET=	0.064 MILES
LENGTH OF PROJECT	450.00 FEET=	0.085 MILES

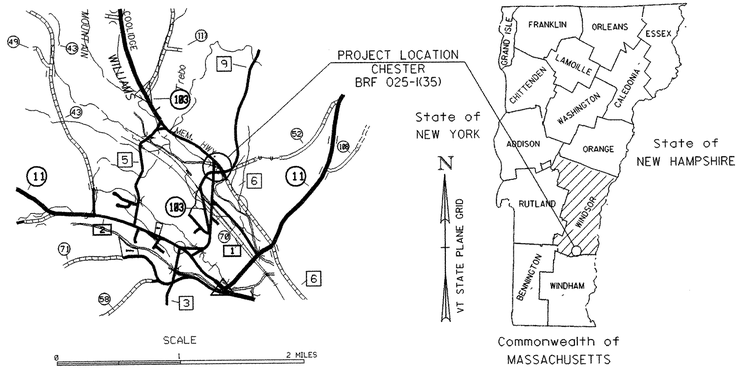

PROPOSED IMPROVEMENT
TOWN OF CHESTER
COUNTY OF WINDSOR
VT. ROUTE 103 - TH 1
PRINCIPAL ARTERIAL ON THE NATIONAL HIGHWAY SYSTEM
CLASS I TOWN HIGHWAY

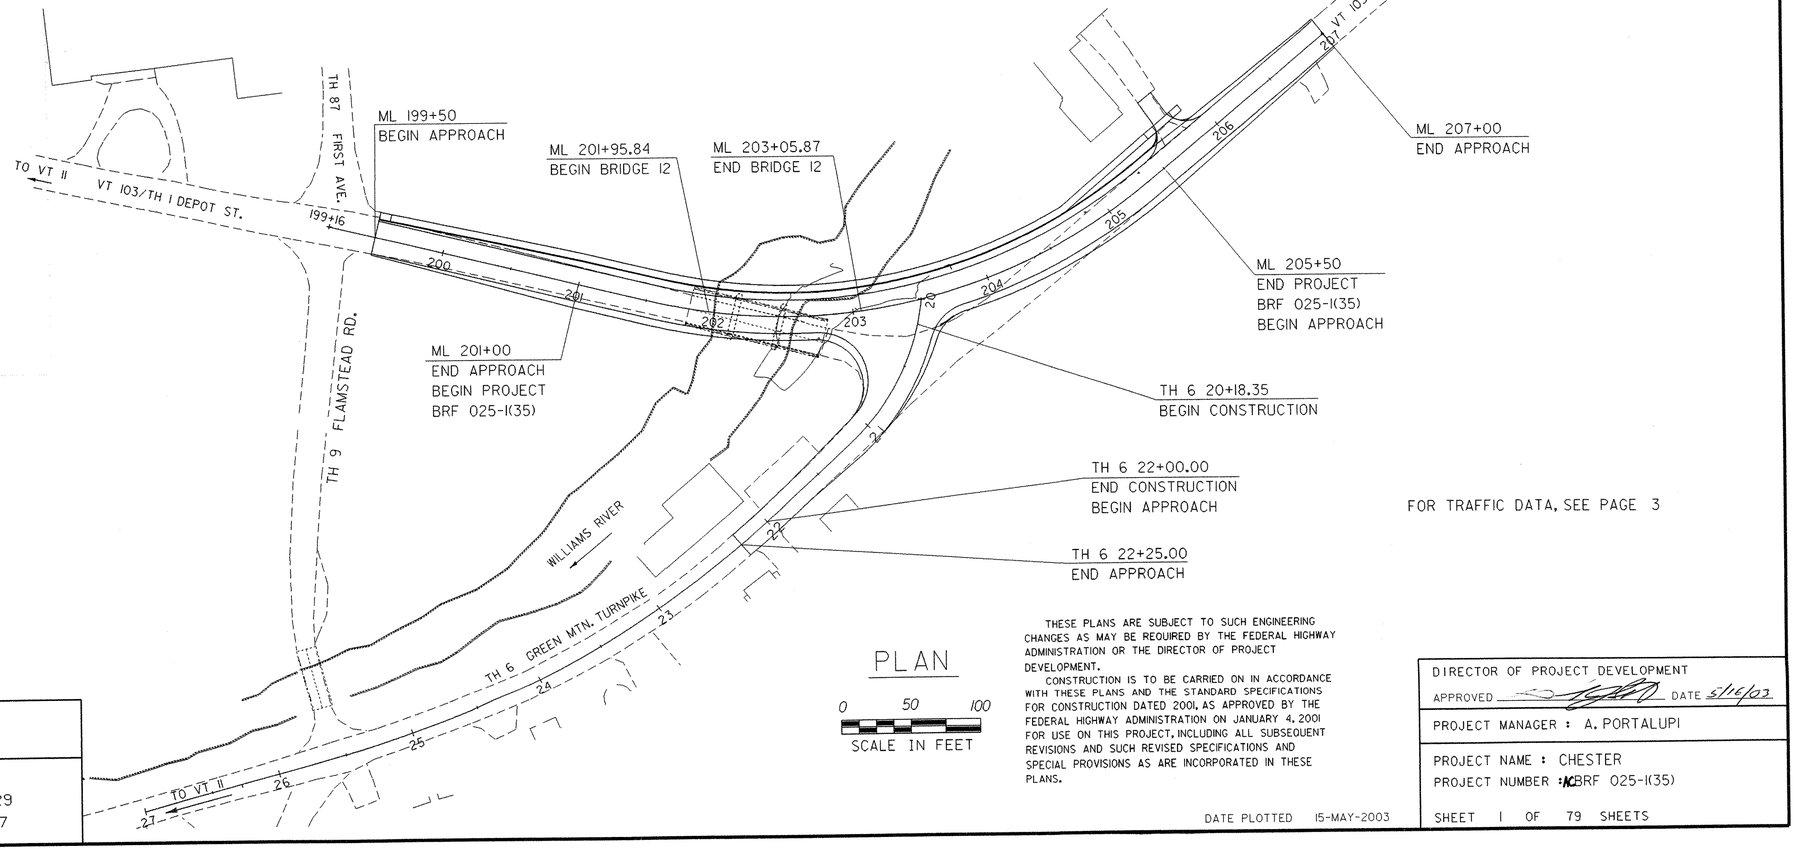

FOR TRAFFIC DATA, SEE PAGE 3

PLAN
0 50 100
SCALE IN FEET

RECORD PLANS

CONTRACTOR: FW WHITCOMB CONSTRUCTION CORP. – WALPOLE, NH
RESIDENT ENGINEER: WILL STODDARD
CONSTRUCTION BEGAN: AUGUST 11, 2003
CONSTRUCTION COMPLETE: JUNE 1, 2005
RECORD PLANS BY: WILL STODDARD & JUDY. GILMORE

I HEREBY CERTIFY THAT ALL THE CONSTUCTION REQUIRED BY THIS SET OF DRAWINGS HAS BEEN ACCOMPLISHED AS INDICATED HEREIN.

BY _____ RESIDENT ENGINEER
DATE 5-24-07

NOTE: Any further information concerning final quantities, amounts or other details relative to this project may be found at Central Files in the electronic archives.

COUNTY LINE
TOWN LINE
LIMITS OF ACCESS
POINT OF ACCESS
FENCE LINE
STONE WALL
TRAVELED WAY
GUARD RAIL
RAILROAD
SURVEY LINE
CULVERT
POWER POLE
TELEPHONE POLE
TREES
CONTROL OF ACCESS
PROPERTY LINE
R.O.W. TAKING LINE
SLOPE RIGHTS
TOP OF CUT
TOE OF SLOPE

SURVEYED BY : SHERIDAN
SURVEYED DATE : 8/90

DATUM
VERTICAL NGVD 1929
HORIZONTAL NAD 1927

THESE PLANS ARE SUBJECT TO SUCH ENGINEERING CHANGES AS MAY BE REQUIRED BY THE FEDERAL HIGHWAY ADMINISTRATION OR THE DIRECTOR OF PROJECT DEVELOPMENT.
CONSTRUCTION IS TO BE CARRIED ON IN ACCORDANCE WITH THESE PLANS AND THE STANDARD SPECIFICATIONS FOR CONSTRUCTION DATED 2001, AS APPROVED BY THE FEDERAL HIGHWAY ADMINISTRATION ON JANUARY 4, 2001 FOR USE ON THIS PROJECT, INCLUDING ALL SUBSEQUENT REVISIONS AND SUCH REVISED SPECIFICATIONS AND SPECIAL PROVISIONS AS ARE INCORPORATED IN THESE PLANS.

DATE PLOTTED 15-MAY-2003

DIRECTOR OF PROJECT DEVELOPMENT
APPROVED _____ DATE 5/16/03
PROJECT MANAGER : A. PORTALUPI
PROJECT NAME : CHESTER
PROJECT NUMBER : BRF 025-I(35)
SHEET 1 OF 79 SHEETS