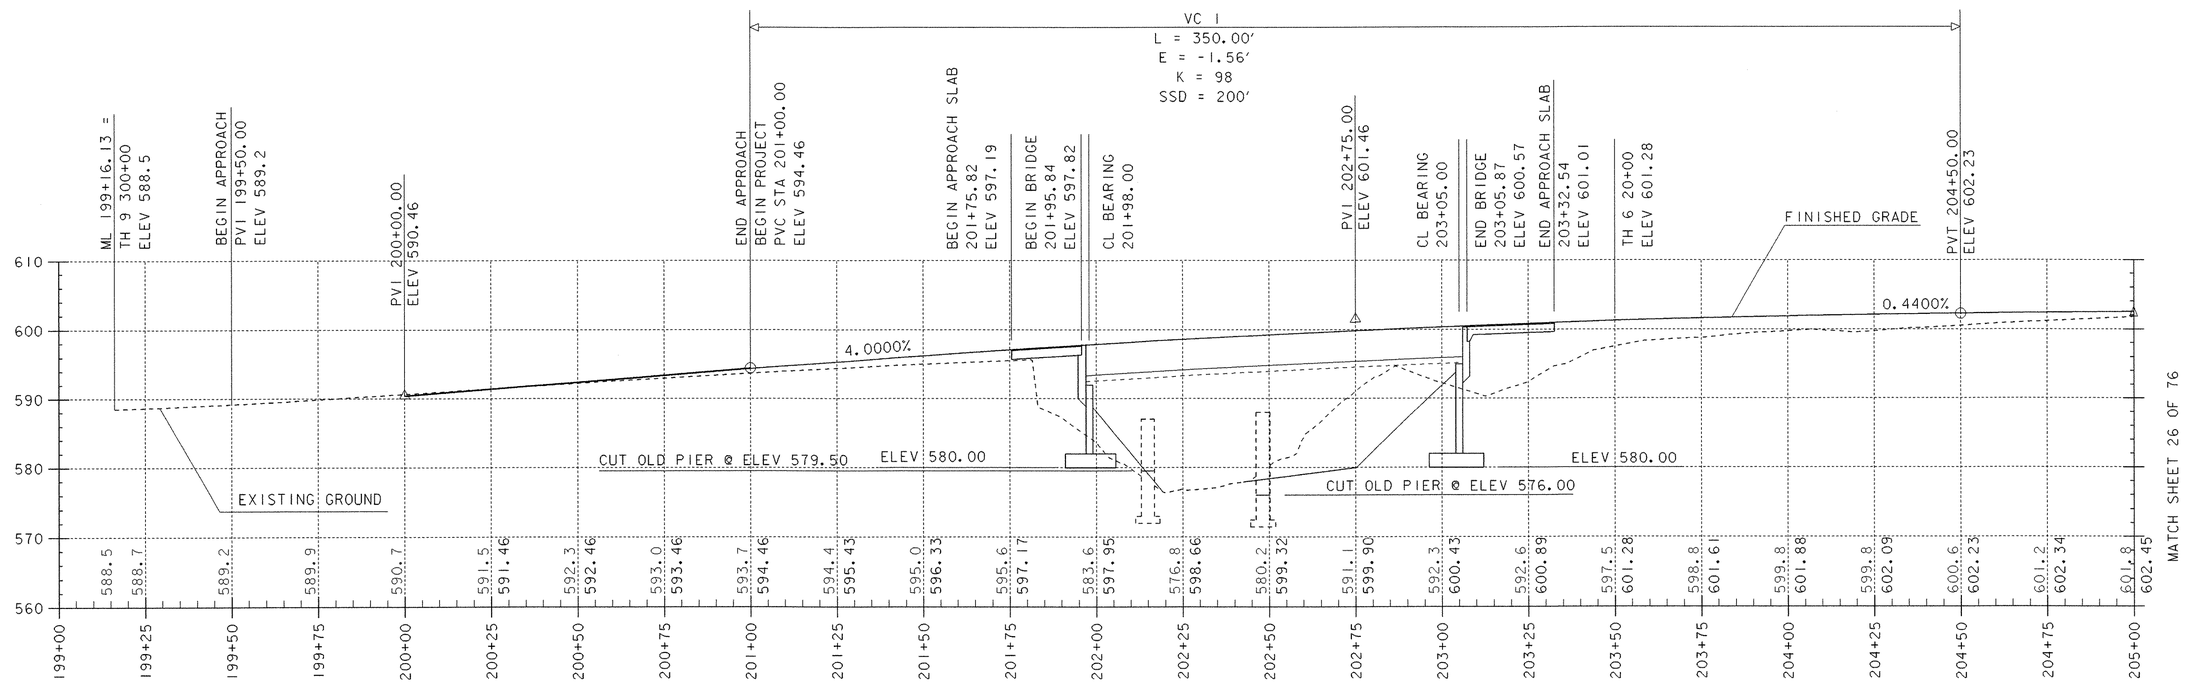

VT 103 PROFILE 1

1" = 10' V
1" = 20' H

10 FT 0
20 FT 0

DATUM

VERTICAL	NGVD 1929
HORIZONTAL	NAD 1927

PROJECT: CHESTER	PROJECT NO.: BRF 025-1(35)

DESIGN FILE NAME: M:\ 1549101VAOT Chester Curv\HWY\DRAW\zfl34xs5.dgn
IPARM FILE NAME: zfl34pfl.i
SURVEYED BY: SHERIDAN
SQUAD LEADER: PORTALUPI
PLOT DATE: 28-MAY-2003
SURVEY DATE: 8/90
DRAWN BY: T. LACKEY
SHEET: 24 OF 79