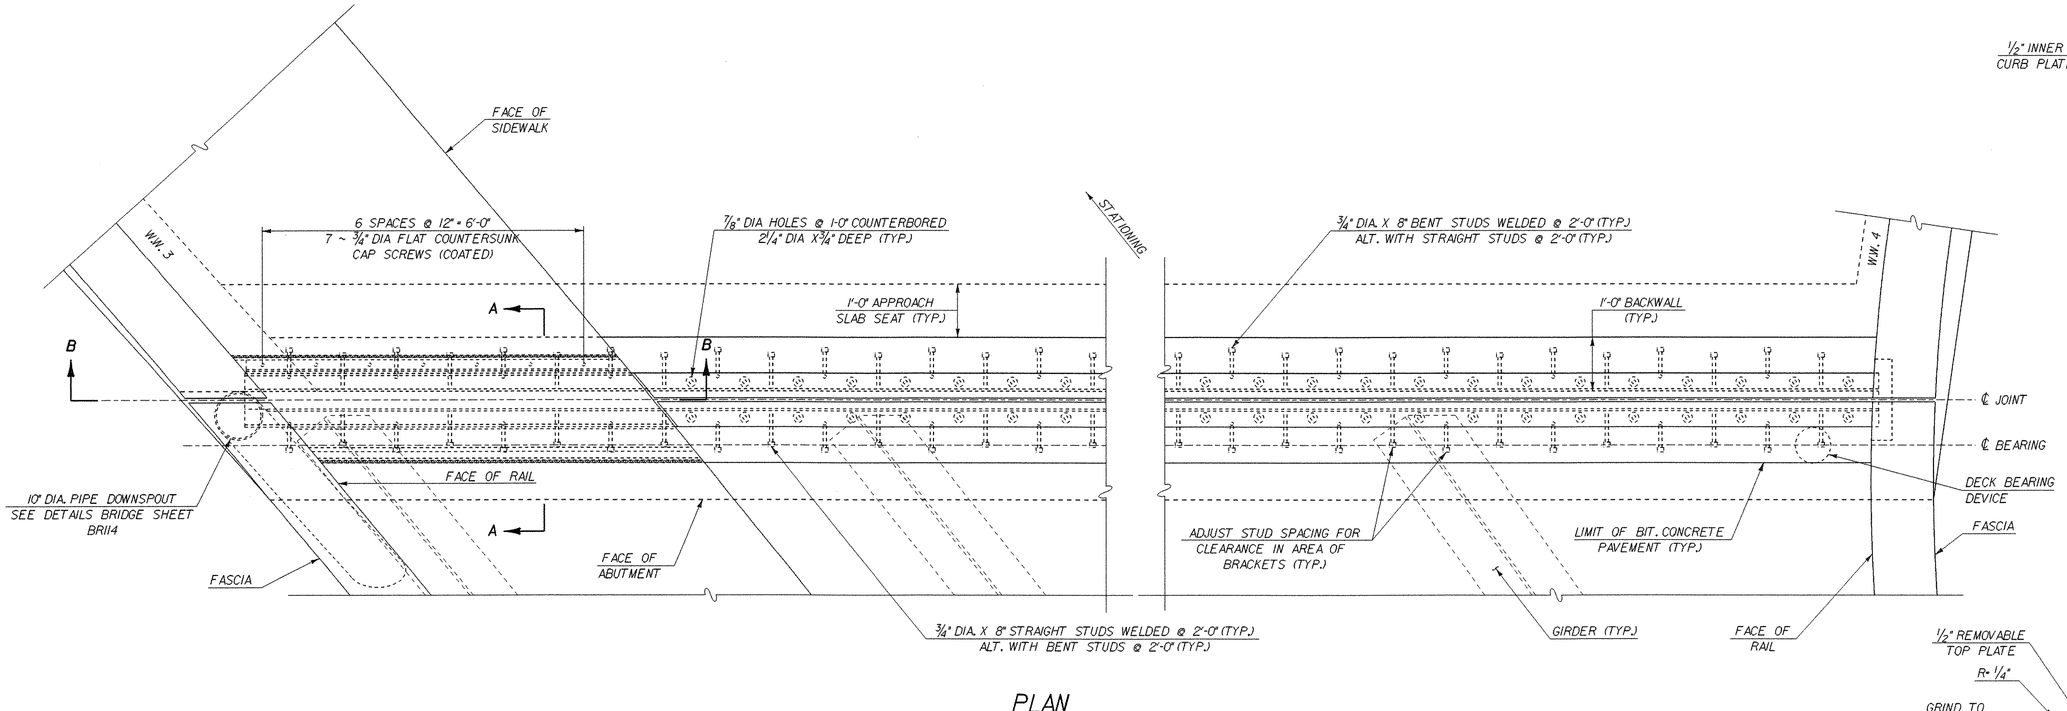

PLAN

SCALE: 3/4" = 1'-0

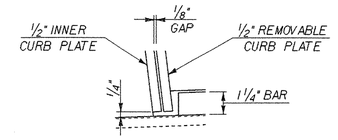

DETAIL B

SCALE: 3" = 1'-0"

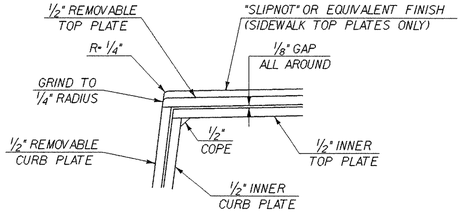

DETAIL A

SCALE: 3" = 1'-0"

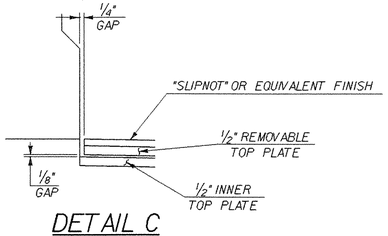

DETAIL C

SCALE: 3" = 1'-0"

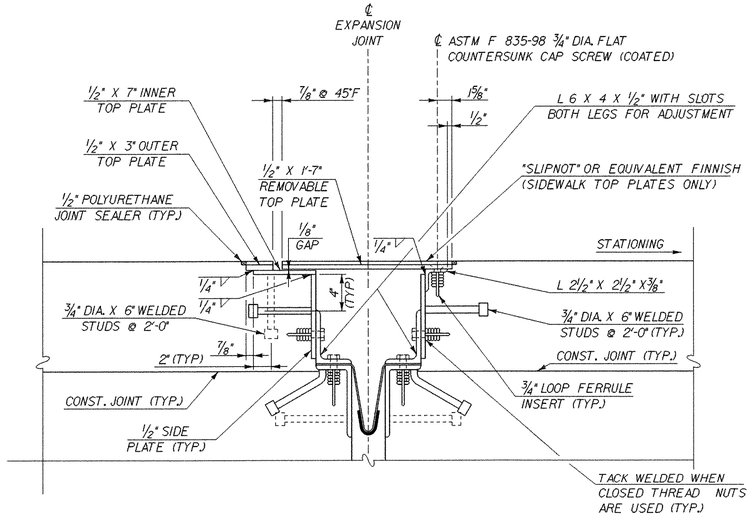

SECTION A-A

SCALE: 1/2" = 1'-0"
(NORMAL TO BEARING)
(REINFORCING NOT SHOWN)

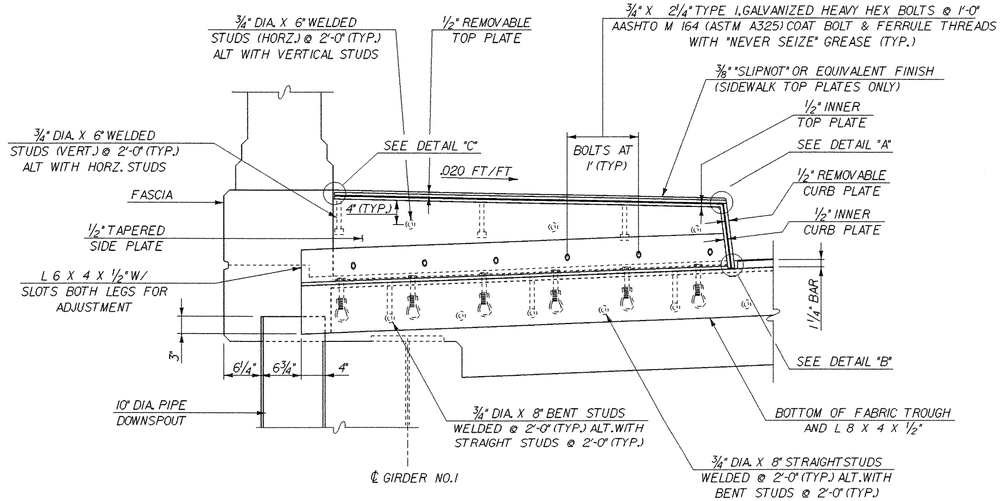

SECTION B-B

SCALE: 1" = 1'-0"

McFARLAND - JOHNSON, INC.

STATE OF VERMONT
AGENCY OF TRANSPORTATION

Town Of CHESTER	Bridge No. 12
Highway No. VT 103	Log Sta. / Surv. Sta.

VT 103 OVER THE WILLIAMS RIVER

EXPANSION JOINT PLAN

Designed By L.WIXSON	Drawn By P.DUSTIN
Checked By T. GRANT — Date 10/00	Bridge Design Supervisor M. ZYDEL — Date
PROJECT CHESTER	PROJECT NO. BRF 025-1(35)
I.G.C. Info. M:\87bl34\Structures\zbl34cjp.dgn	zbl34cjpj
Bridge Sheet No. BRI13	Sheet 57 of 79

PLOTTED 28-MAY-2003