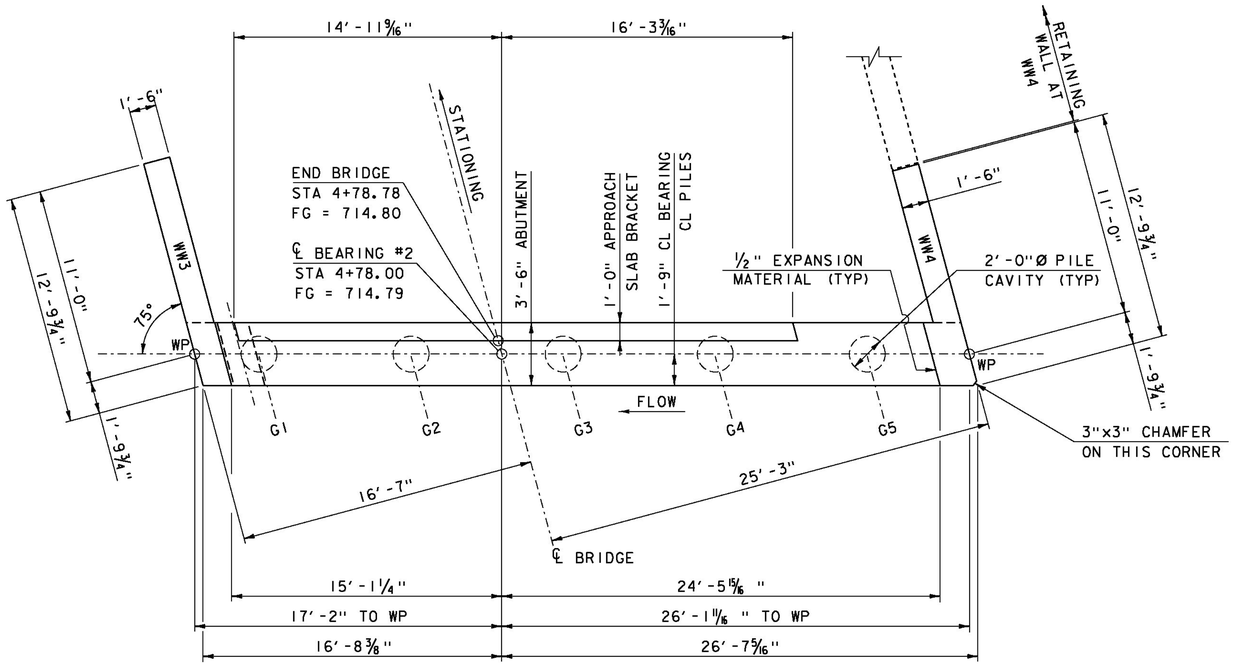

ABUTMENT 2 - PLAN

SCALE: 1/4" = 1'-0"

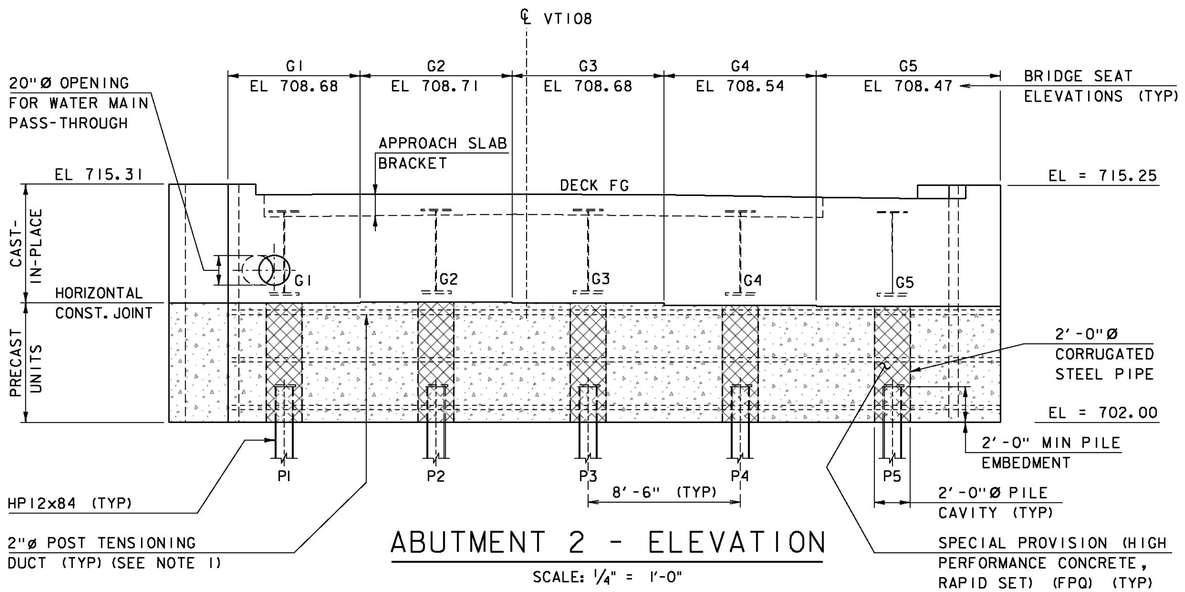

ABUTMENT 2 - ELEVATION

SCALE: 1/4" = 1'-0"

1) POST TENSIONING AND ASSOCIATED ITEMS ONLY REQUIRED IF PILE CAP IS CONSTRUCTED OF MORE THAN ONE UNIT.

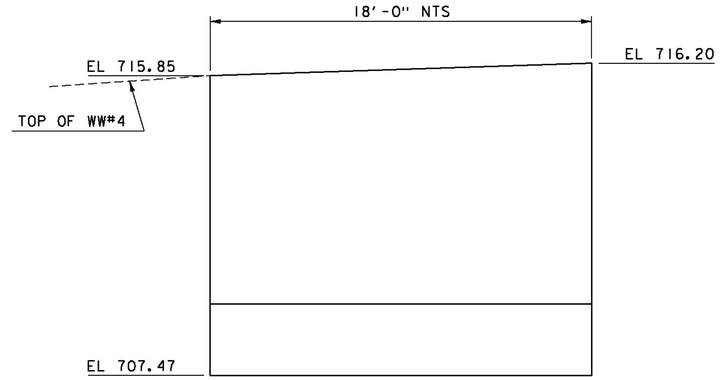

RETAINING WALL ELEVATION

SCALE: 1/2" = 1'-0"

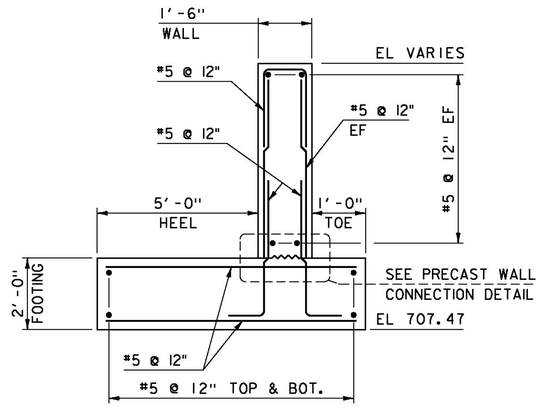

RETAINING WALL TYPICAL

SCALE: 1/2" = 1'-0"

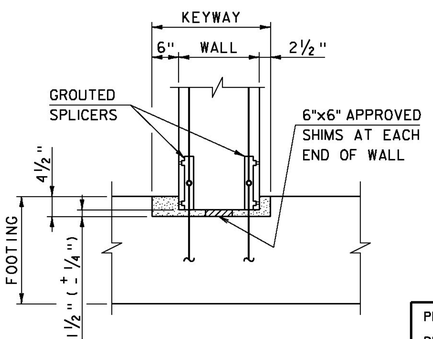

PRECAST WALL CONNECTION DETAIL

SCALE: 3/4" = 1'-0"

NOTE:

NF = NEAR FACE
FF = FAR FACE
EF = EACH FACE
▲ = CUT TO FIT IN FIELD
3" CLEAR, UNLESS OTHERWISE SPECIFIED ON THE PLANS.
2'-2" BAR LAP UNLESS OTHERWISE SPECIFIED ON THE PLANS.

PROJECT NAME:	STOWE
PROJECT NUMBER:	BRF 0235 (11)
FILE NAME: s87e052sub.dgn	PLOT DATE: 28-JUL-2014
PROJECT LEADER: C. CARLSON	DRAWN BY: D. KARABEGOVIC
DESIGNED BY: D. PETERSON	CHECKED BY: M. LONGSTREET
ABUTMENT #2 PLAN & ELEVATION	SHEET 39 OF 64