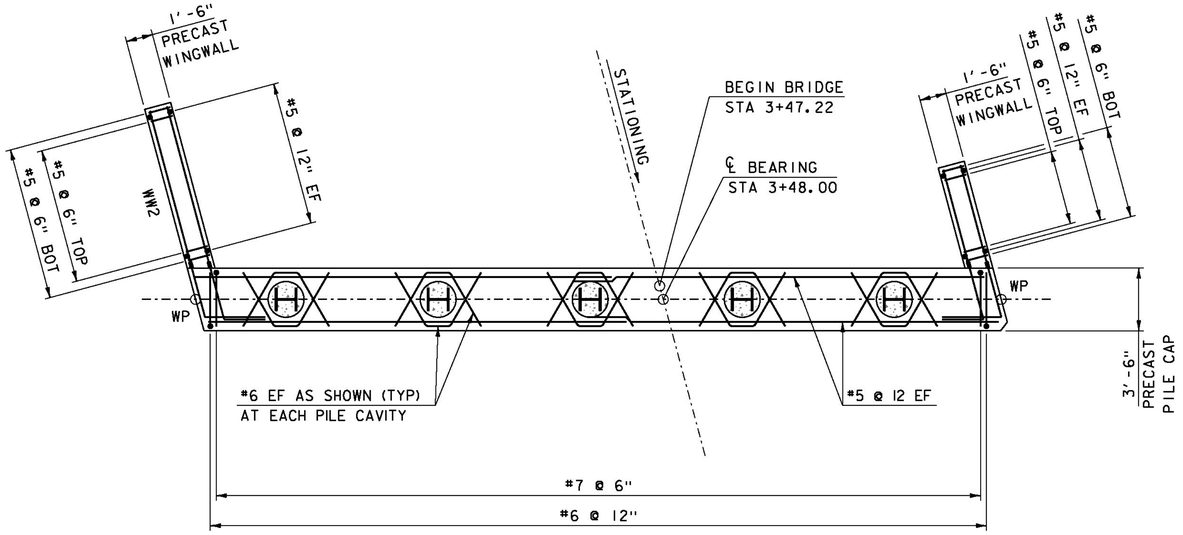

ABUTMENT 1 PRECAST - REINFORCING PLAN

SCALE: 1/4" = 1'-0"

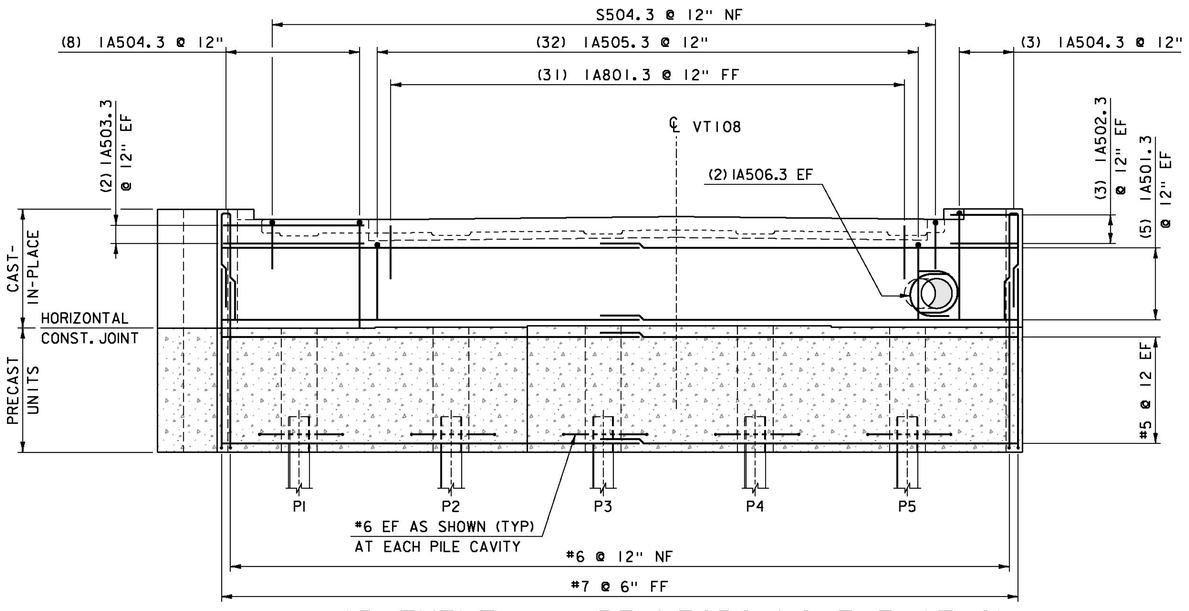

ABUTMENT 1 - REINFORCING ELEVATION

SCALE: 1/4" = 1'-0"

1) FIELD CUTTING ABUTMENT #1 & #2 REINFORCING STEEL SHALL BE PERMITTED AS REQUIRED TO FIT 20" DIA WATER MAIN PASS-THROUGH.

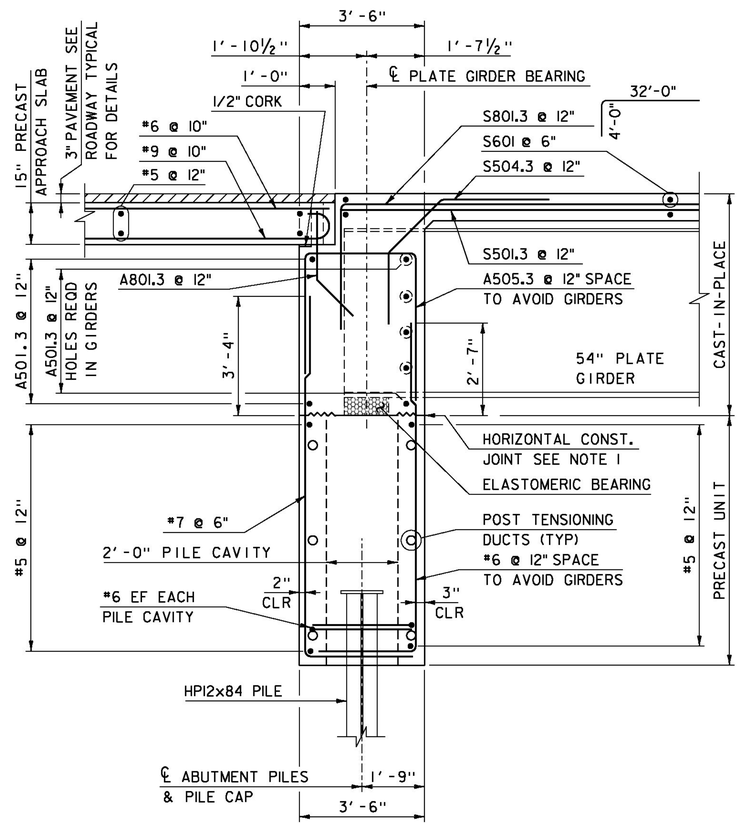

ABUTMENT 1 & 2 - TYPICAL

SCALE: 1/2" = 1'-0"

1) HORIZONTAL CONSTRUCTION JOINT SHALL BE ROUGHENED AS SHOWN IN SD-501.00. SURFACE SHALL BE ROUGHENED TO WITHIN 3" OF EACH FACE OF CONCRETE AND WITHIN 3" OF ELASTOMERIC BEARING PADS. SURFACE UNDER EACH BEARING PAD SHALL REMAIN SMOOTH.

NOTE:

NF = NEAR FACE
FF = FAR FACE
EF = EACH FACE
▲ = CUT TO FIT IN FIELD
3" CLEAR, UNLESS OTHERWISE SPECIFIED ON THE PLANS.
2'-2" BAR LAP UNLESS OTHERWISE SPECIFIED ON THE PLANS.

PROJECT NAME: STOWE
PROJECT NUMBER: BRF 0235 (11)

FILE NAME: s87e052sub.dgn
PROJECT LEADER: C. CARLSON
DESIGNED BY: D. PETERSON
ABUTMENT #1 REINFORCING DETAILS

PLOT DATE: 28-JUL-2014
DRAWN BY: M. LONGSTREET
CHECKED BY: C. BURRALL
SHEET 40 OF 64