Per email, blockout dimensions will follow contract plan dimensions which are the same as below. Ensure additional dimension provides clearance for box.




AS #1 Details




AS #2 Details

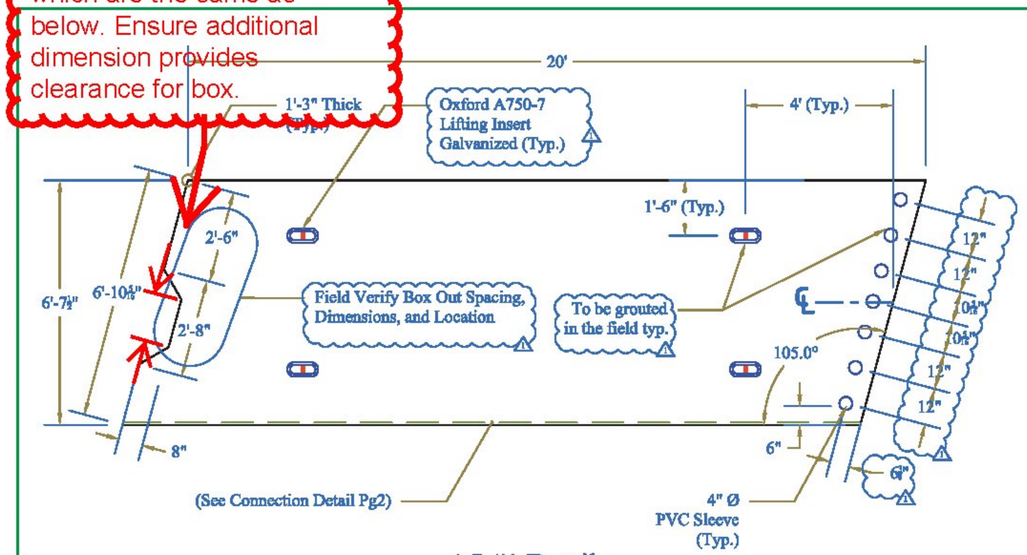


AS #3 Details

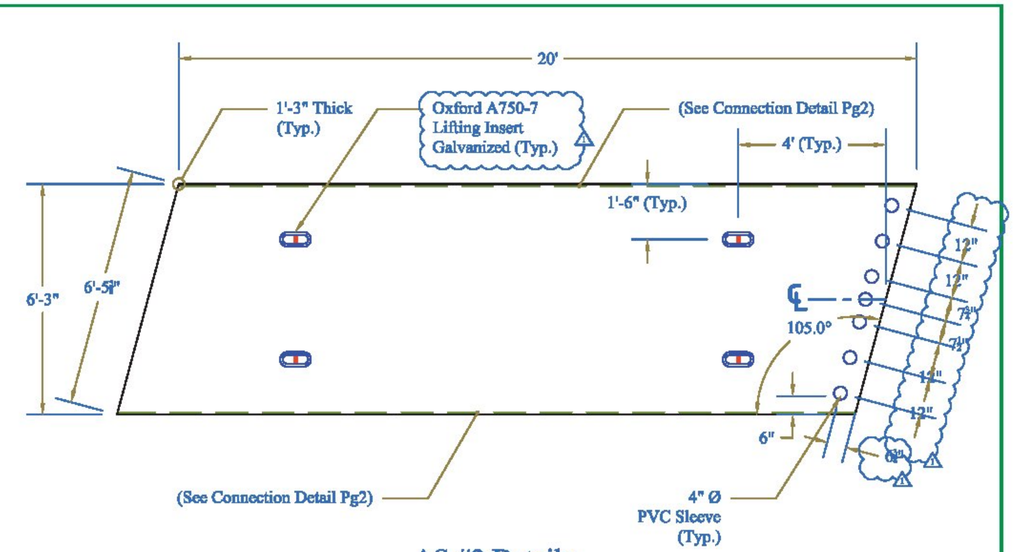


AS #4 Details

Vermont Agency of Transportation
RECEIVED
Approach Slab Submittal 201126_Markup.pdf

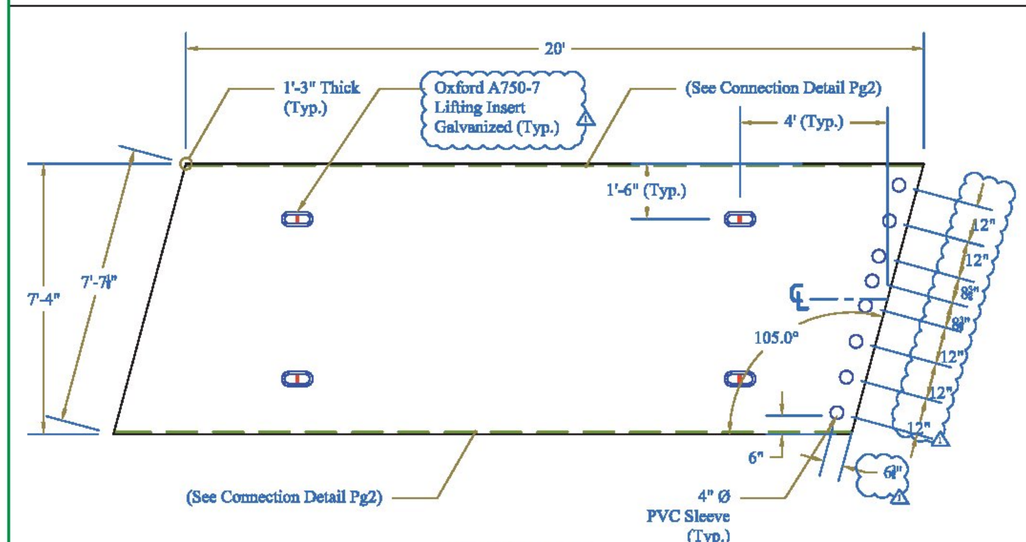CK'D BY CLB OK'D BY DRP

January 13, 2015

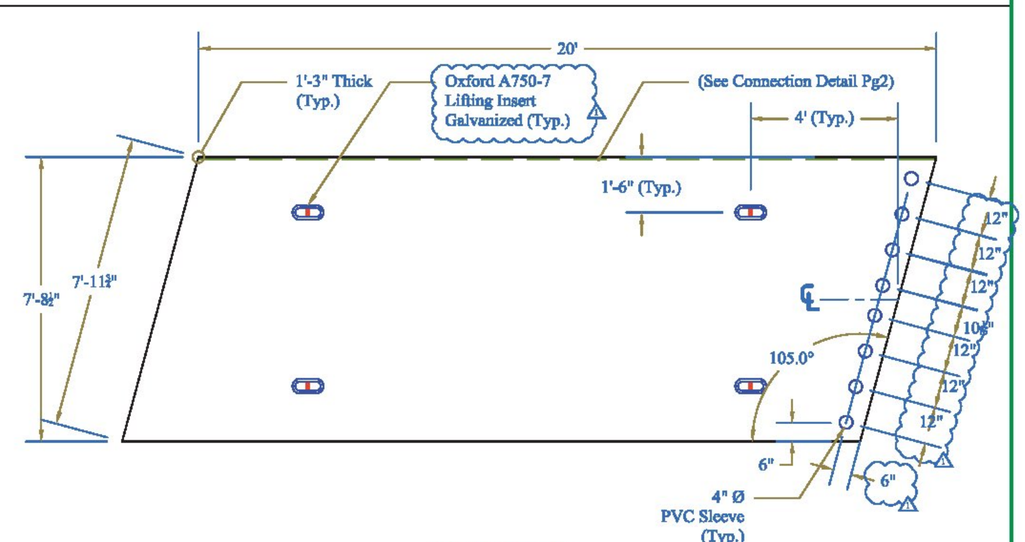RESUBMIT NO Approved AsNoted

BY C. CARLSON DATE 01/15/15

| | | | |
|---|---|---|---|
| PRECAST CONCRETE APPROACH SLAB SHOP DRAWINGS (SDI JOB #15163) | | INSTALLER: CCS Construction, 138 Munson Ave, Morrisville, VT 05661, PH: 802-888-7701 | FABRICATOR: 193 INDUSTRIAL AVE. WILLISTON, VT 05495 Ph: (802) 658-0201 SD Ireland Precast Division |
| SUPERVISOR: M. WHEELER | PROJECT NAME: Stowe BRF 0235 (II) | | |
| DETAILER: I. ADAMS | PROJECT #: 0235 (II) | | |
| CHECKER: E. Barendse | LOCATION: Stowe, VT | | |
| ENGINEER: | | 11/20/14 | South Approach Slabs — 3 of 4 |