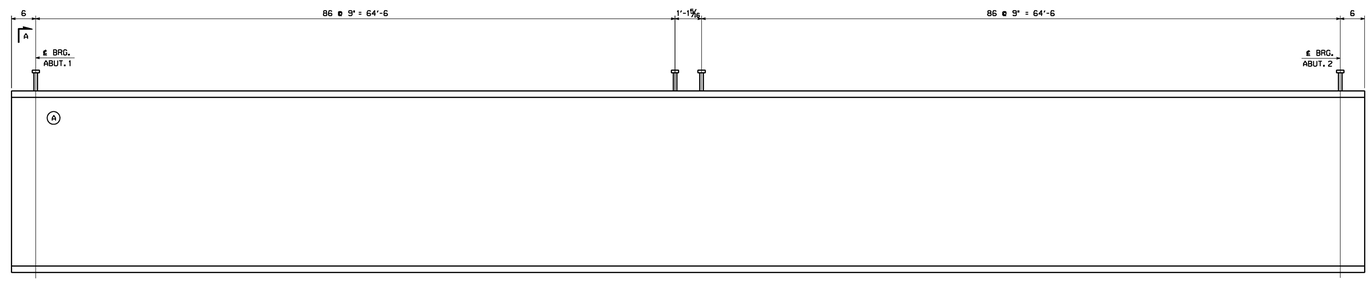

SHEAR STUD CONNECTOR LOCATION LAYOUT

DIMENSIONS GIVEN ALONG TOP OF GIRDER

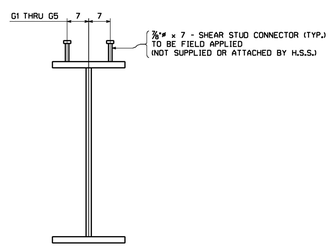

SECTION A

NOTES:

FOR NOTES, SEE DRAWING E1.
WORK THIS DRAWING WITH DRAWING E1.
(A) INDICATES SUFFIX MARK OF SHIPPING PIECE.

Vermont Agency of Transportation
RECEIVED
Structure Dept. Approved 12.5.14.pdf
CK'D BY CLB OK'D BY DRP
November 25, 2014
RESUBMIT NO Approved
BY C. CARLSON DATE 12/5/14

NO.	REVISION	BY	CHK'D	DATE
△				
△				
△				

HOLES
BOLTS
COATING
CODE(S)
SCALE N.T.S.

An ISO 9001:2000 Certified Company

HIGH STEEL STRUCTURES LLC
An Affiliate of High Industries Inc.

Lexington Facility
175 Old Prospect Hill Road
Lexington, KY 40511-1000
Phone (859) 255-1021

Williamsport Facility
300 N. 4th Street
Williamsport, PA 17701
Phone (570) 326-5131
www.highsteel.com

ERECTION PLAN - STUD LAYOUT
VT RT 100 OVER LITTLE RIVER
VT RT 100 STA. 3+48.00 TO STA. 4+78.00
TOWN OF STOWE, LAMOILLE COUNTY, VERMONT
STATE OF VERMONT
AGENCY OF TRANSPORTATION

STATE CONT. OR REF. NO.	BRF 0235 (11)	FED. AID PROJ. NO.	
GENERAL CONTRACTOR	CCS CONSTRUCTORS LLC	HSS PROJ. MGR	KEN GLIDDEN
DRAWING MANAGER	DAVE PAINTER (IH)	MADE BY: MGK	CHK'D. BY: SSL DATE 11-19-14
HSS PROJECT NUMBER	S-1140166A-1	DRAWING NUMBER	E2 OF E2

VT

PLOTTED: 11/21/2014
SHEAR.dgn

BY: mkrenzel

SHIPMENT BY PM&ENG.5835222 PRO.5835235 SHP&ERECT.5835235

62