ENGLISH

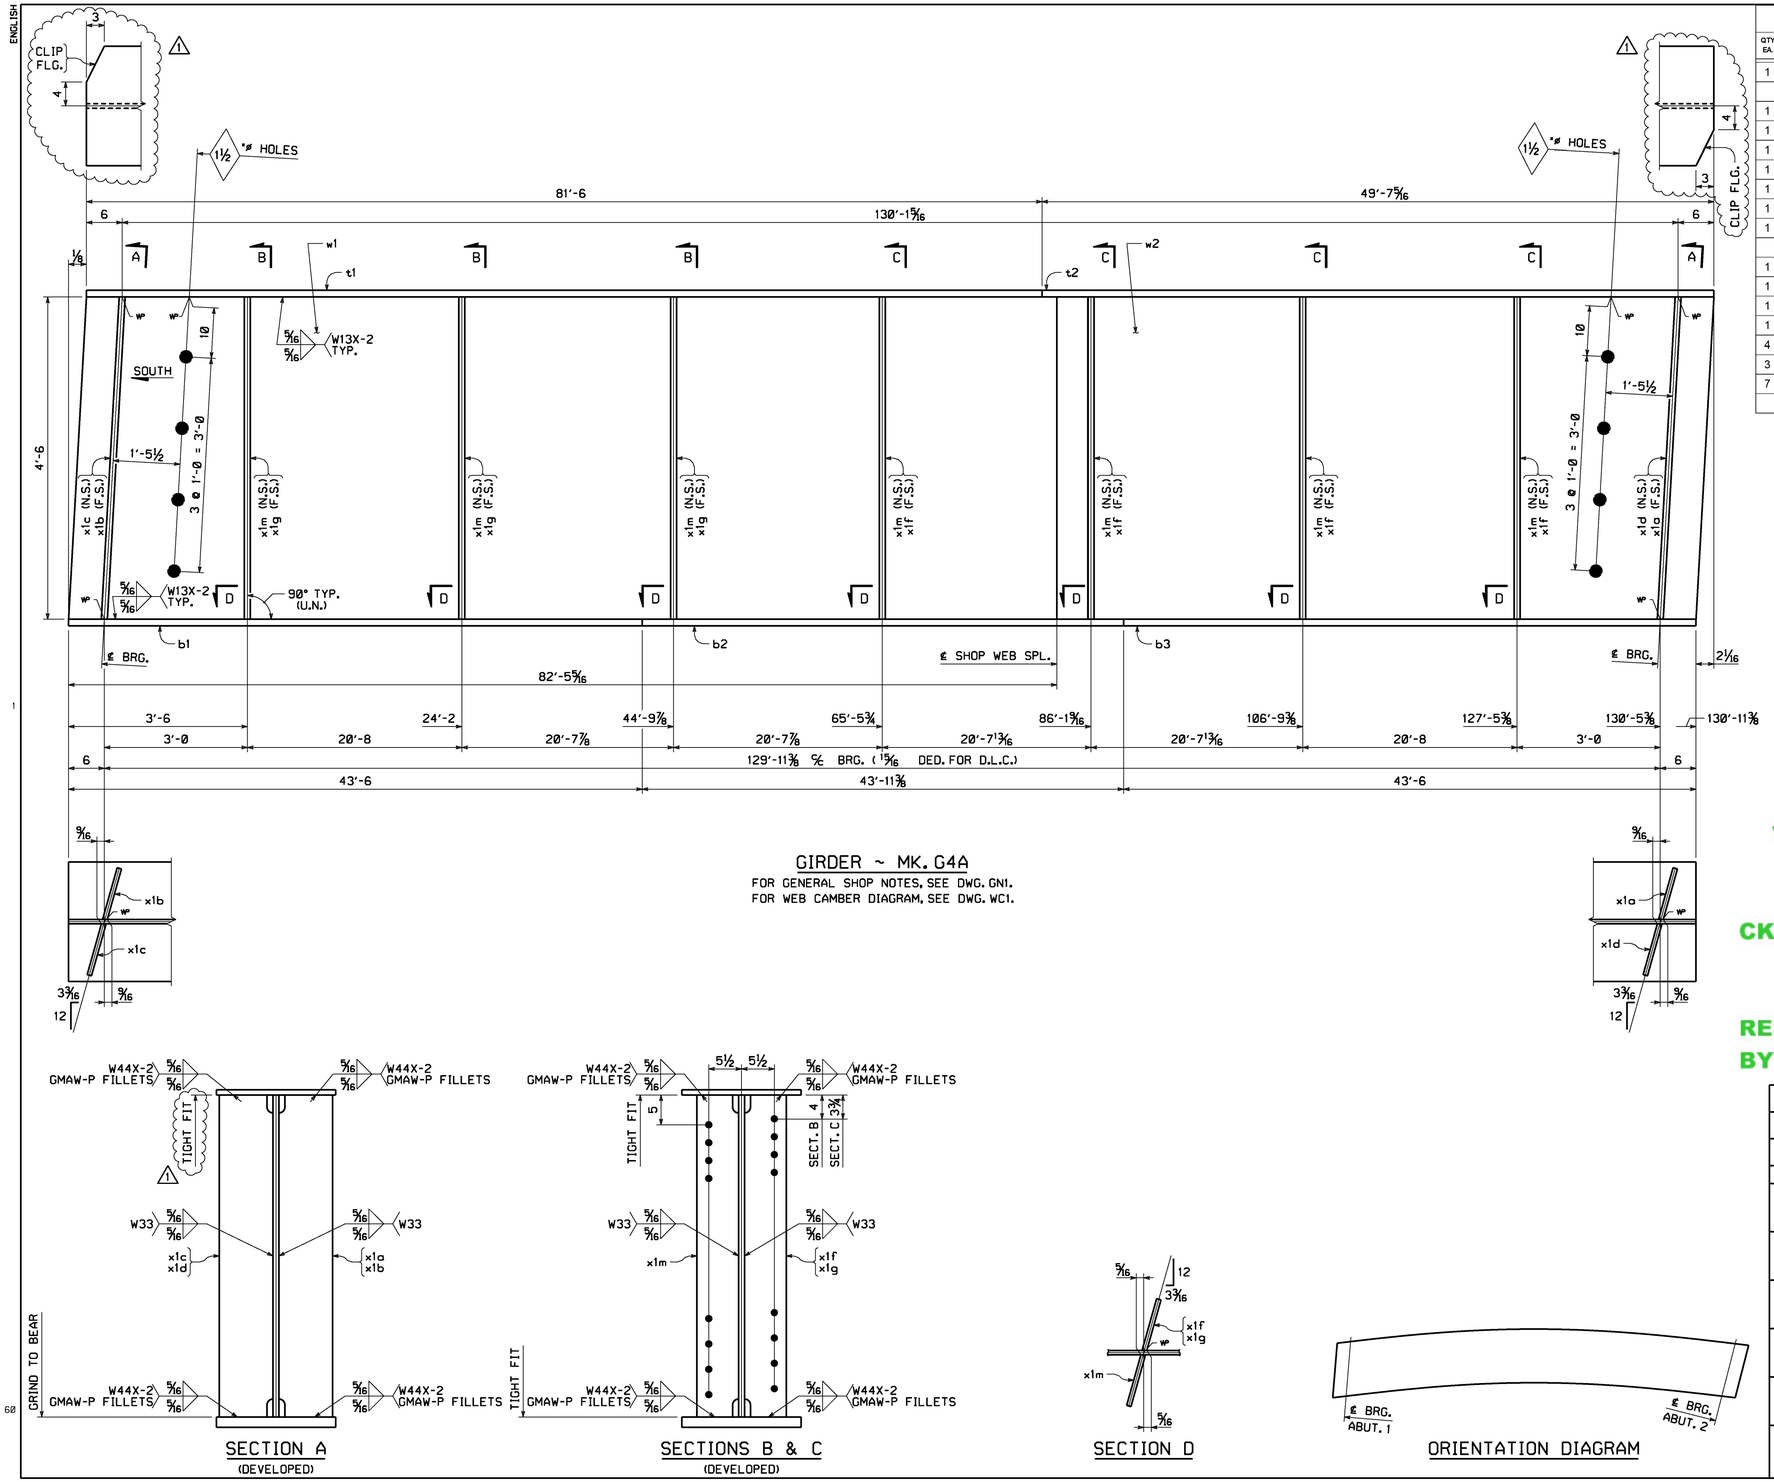

GIRDER ~ MK. G4A

FOR GENERAL SHOP NOTES, SEE DWG. GN1.
FOR WEB CAMBER DIAGRAM, SEE DWG. WC1.

BILL OF MATERIAL

QTY EA.	MARK	COMM	DESCRIPTION	LENGTH	SPEC	GRADE	TEST	REMARKS	ITEM	SHIP WT. EA. (LBS)
1	G4A		GIRDER							39703
1	w1	PL	5/8 x 54	82 5 7/8	M270	50W	T		03001	
1	w2	PL	5/8 x 54	48 8 3/16	M270	50W	T		03002	
1	t1	PL	7/8 x 20	81 6 1/8	M270	50W	T		04003	
1	t2	PL	7/8 x 20	49 7 3/8	M270	50W	T		04004	
1	b1	PL	1 3/4 x 20	43 6 1/16	M270	50W	T		04002	
1	b2	PL	1 3/4 x 20	43 11 7/16	M270	50W	T		04001	
1	b3	PL	1 3/4 x 20	43 6 1/16	M270	50W	T		04002	
1	x1a	PL	7/8 x 9	4 6	M270	50W			07001	
1	x1b	PL	7/8 x 9	4 6	M270	50W			07001	
1	x1c	PL	7/8 x 9	4 6 1/16	M270	50W			07001	
1	x1d	PL	7/8 x 9	4 6 1/16	M270	50W			07001	
4	x1f	PL	1/2 x 7	4 6	M270	50W			07002	
3	x1g	PL	1/2 x 7	4 6	M270	50W			07002	
7	x1m	PL	1/2 x 7	4 6	M270	50W			07002	

Vermont Agency of Transportation

RECEIVED

Structural Steel_Approved 1.23.15.pdf

CK'D BY CLB OK'D BY DRP

January 23, 2015

RESUBMIT NO Approved

BY C. CARLSON DATE 01/23/15

NO.	REVISION	BY	CHK'D	DATE
1	APPROVAL CHANGE: ADDED TIGHT FIT & TOP FLANGE CLIP.	MJD	MGK	1/12/15

HOLES: 15/16"ø (U.N.)
BOLTS: NONE
COATING: NONE
CODE(S): 30
SCALE: N.T.S.

HIGH STEEL STRUCTURES LLC
An ISO 9001:2000 Certified Company
An Affiliate of High Industries Inc.
Lancaster Facility: 1915 Old Philadelphia Pike, Lancaster, PA 17605-0008, Phone (717) 299-5211
Williamsport Facility: 3501 W. 4th Street, Williamsport, PA 17701, Phone (570) 326-9051
www.Highsteel.com

GIRDER G4A
VT RT 108 OVER LITTLE RIVER
VT RT 108 STA. 3+48.00 TO STA. 4+78.00
TOWN OF STOWE, LAMOILLE COUNTY, VERMONT
STATE OF VERMONT
AGENCY OF TRANSPORTATION

STATE CONT. OR REF. NO.	BRF 0235 (11)	FED. AID PROJ. NO.	
GENERAL CONTRACTOR	CCS CONSTRUCTORS LLC	HSSL PROJ. MGR	KEN GLIDDEN
DRAWING MANAGER	DAVE PAINTER (IH)	MADE BY	MJD
CHK'D. BY	MGK	DATE	11/18/14
HSSL PROJECT NUMBER	S-1140166A-1	DRAWING NUMBER	4 OF 6

VT

PLOTTED: 1/12/2015 2:19:20 PM
BY: mkreidel
SHIPMENT 01
PM&ENG: 58035274 PRD: 58035275 SHIP&RECT.: 58035275