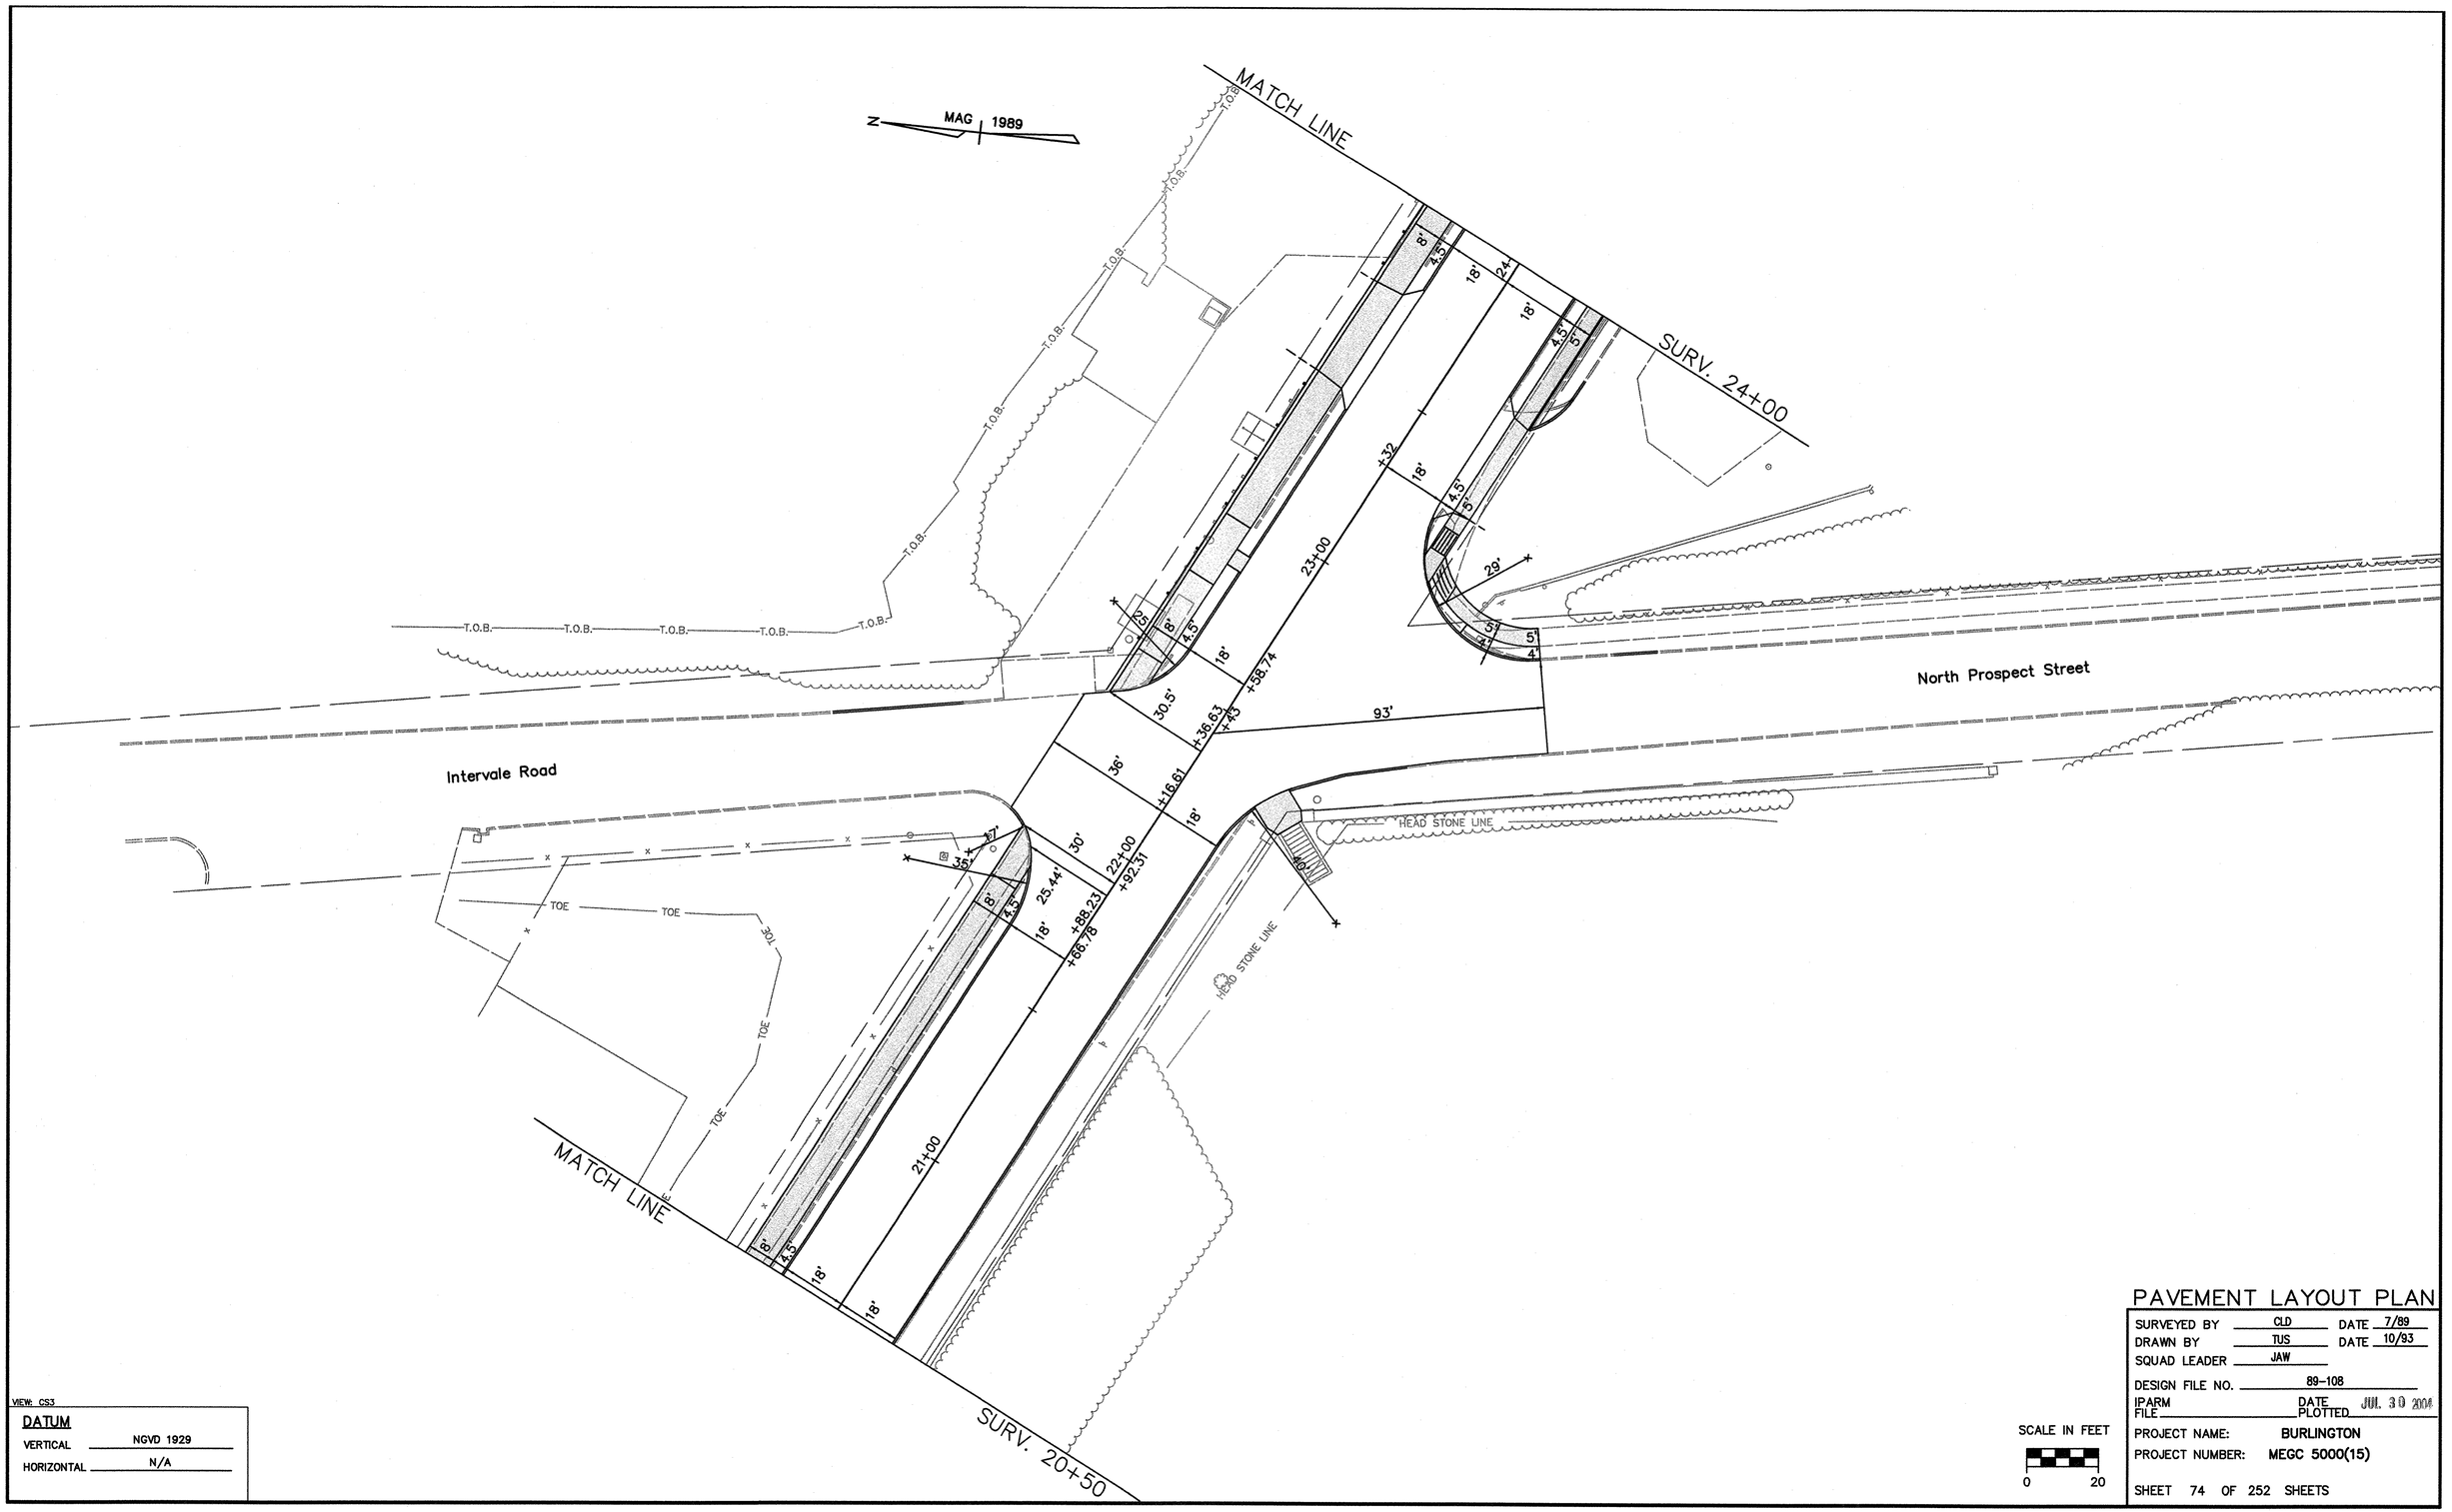

VIEW: CS3

DATUM

VERTICAL NGVD 1929

HORIZONTAL N/A

PAVEMENT LAYOUT PLAN

SURVEYED BY CLD DATE 7/89

DRAWN BY TUS DATE 10/93

SQUAD LEADER JAW

DESIGN FILE NO. 89-108

IPARM FILE

DATE PLOTTED JUL. 30 2004

PROJECT NAME: BURLINGTON

PROJECT NUMBER: MEGC 5000(15)

SHEET 74 OF 252 SHEETS