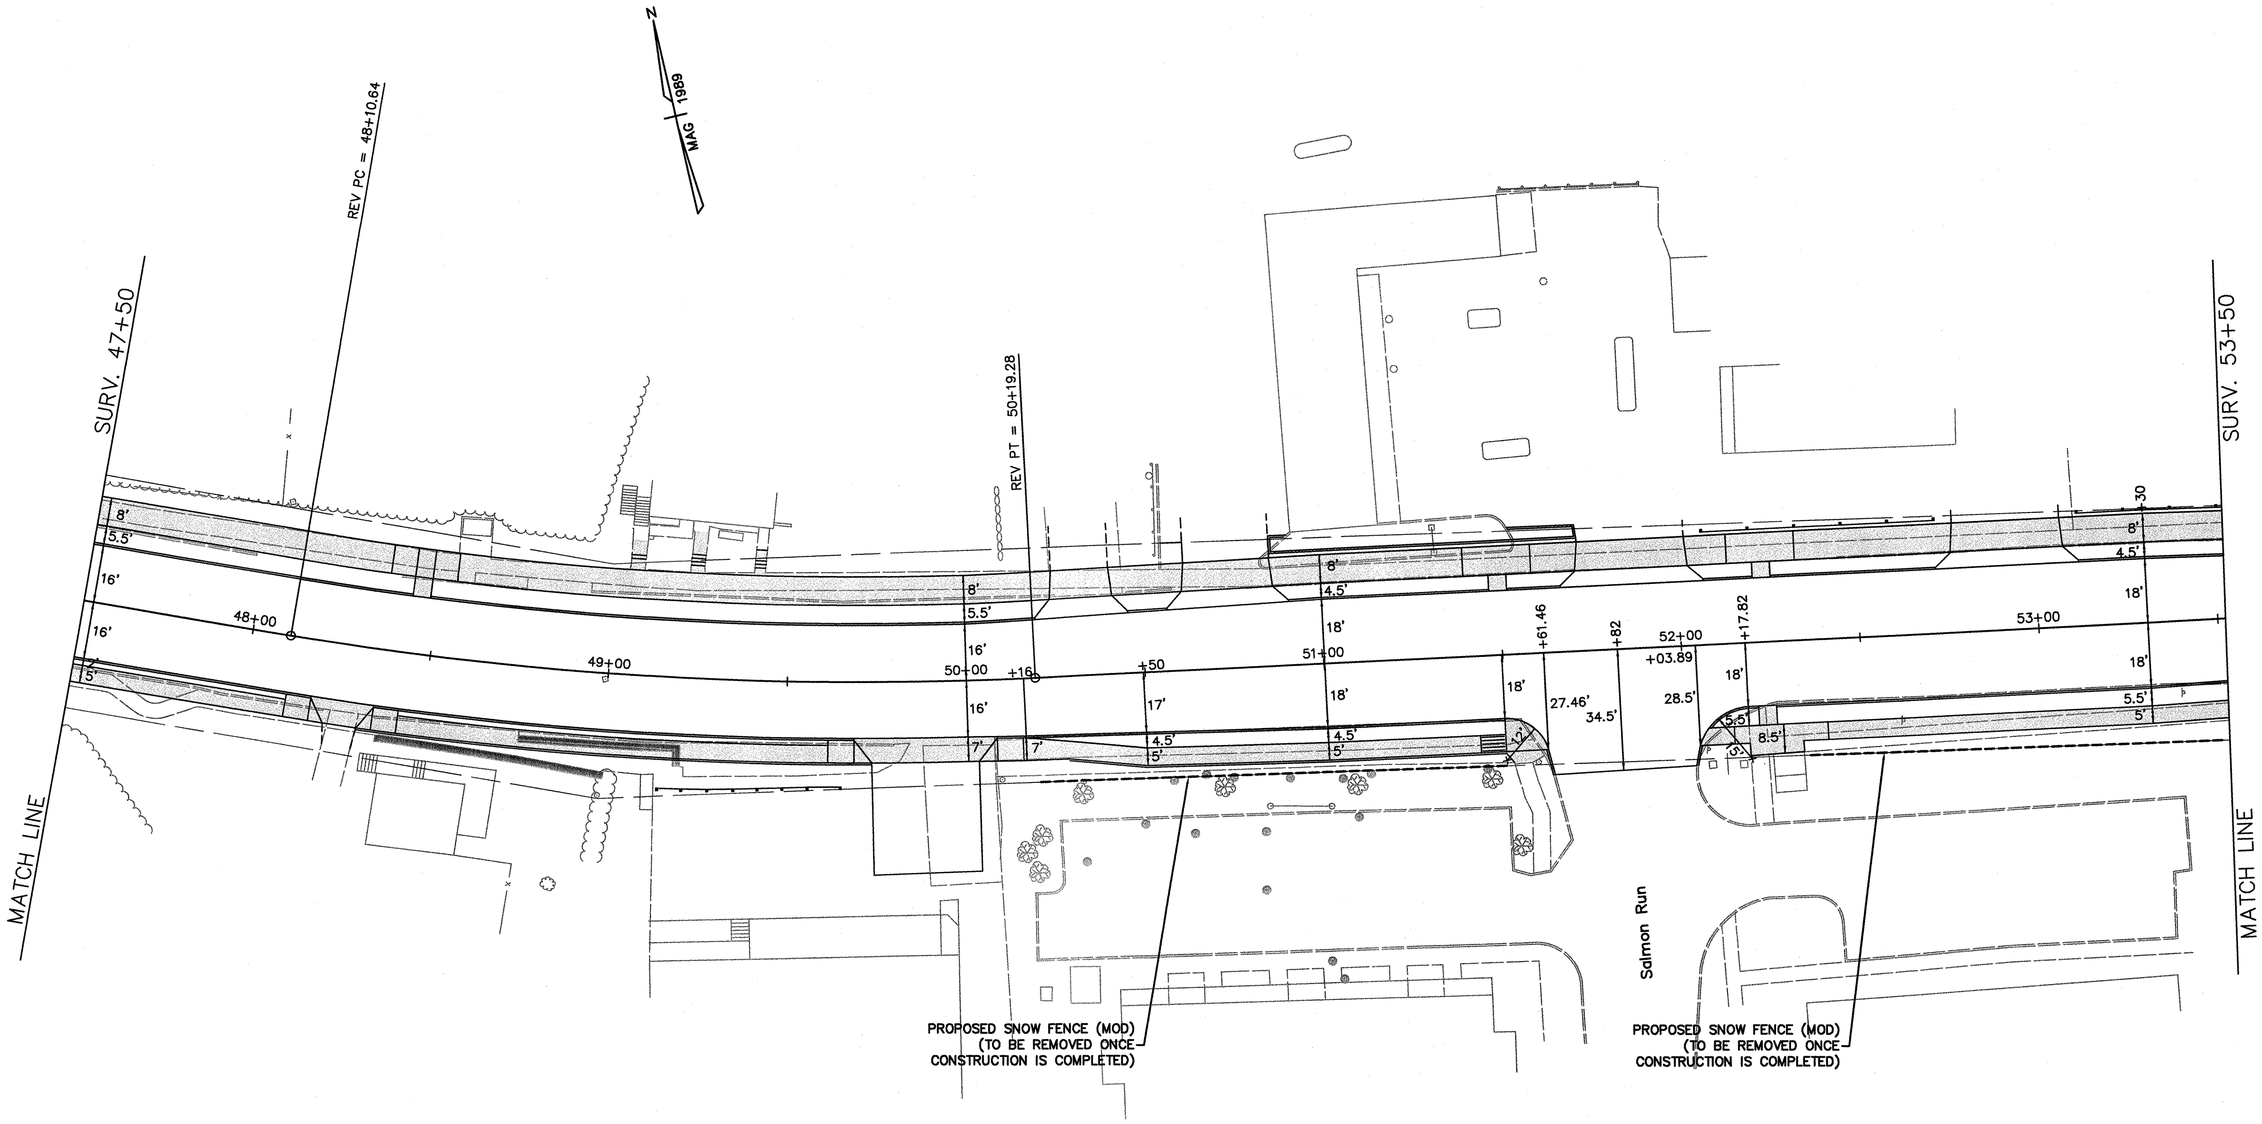

VIEW: CS8

DATUM

VERTICAL NGVD 1929

HORIZONTAL N/A

SCALE IN FEET

0 20

PAVEMENT LAYOUT PLAN

SURVEYED BY	CLD	DATE	7/89
DRAWN BY	TUS	DATE	10/93
SQUAD LEADER	JAW		
DESIGN FILE NO.	89-108		
IPARM FILE		DATE PLOTTED	JUL 30 2004

PROJECT NAME: BURLINGTON

PROJECT NUMBER: MEGC 5000(15)

SHEET 79 OF 252 SHEETS