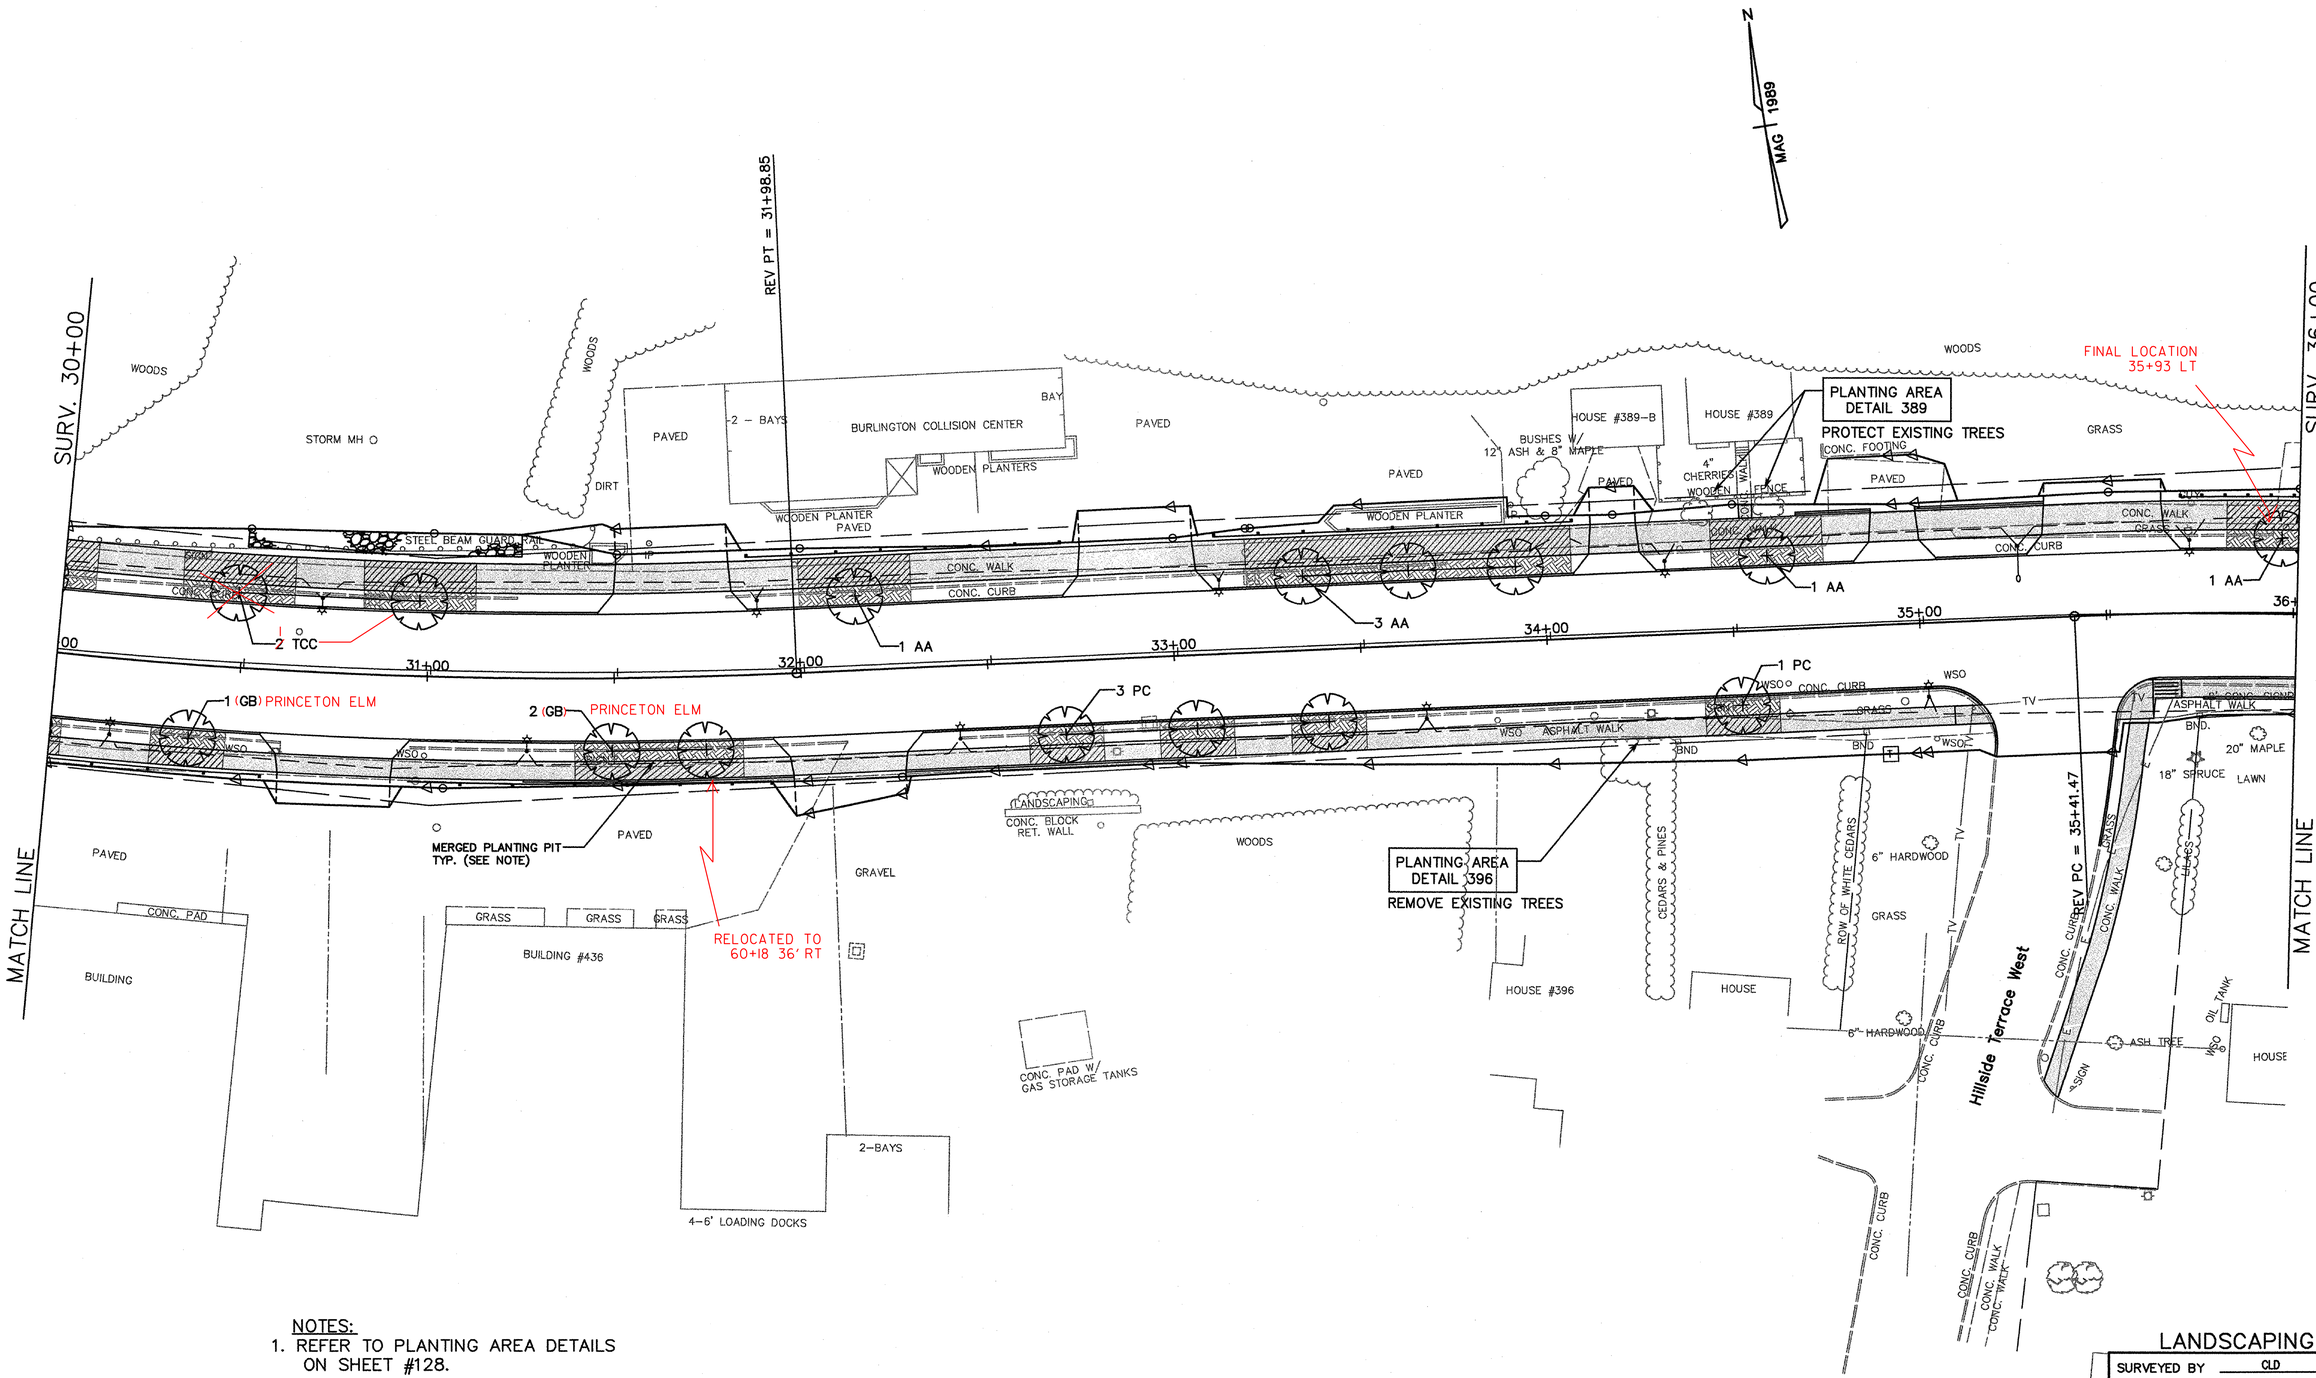

NOTES:

1. REFER TO PLANTING AREA DETAILS ON SHEET #128.
2. MERGE PLANTING PITS WHERE THERE WOULD BE LESS THAN 15' BETWEEN SEPARATE PITS.

STRUCTURAL SOIL

TOPSOIL

SCALE IN FEET

0 20

VIEW: CS5

DATUM

VERTICAL NGVD 1929

HORIZONTAL N/A

LANDSCAPING PLAN

SURVEYED BY	CLD	DATE	7/89
DRAWN BY	TUS	DATE	10/93
SQUAD LEADER	JAW		
DESIGN FILE NO.	89-108		
IPARM FILE		DATE PLOTTED	

PROJECT NAME: BURLINGTON

PROJECT NUMBER: MEGC 5000(15)

SHEET 120 OF 252 SHEETS