


DATE	
BY	
FINAL SURVEY	
NOTEBOOK	
NO.	

DATE	
BY	
ORIGINAL SURVEY	
NOTEBOOK	
NO.	

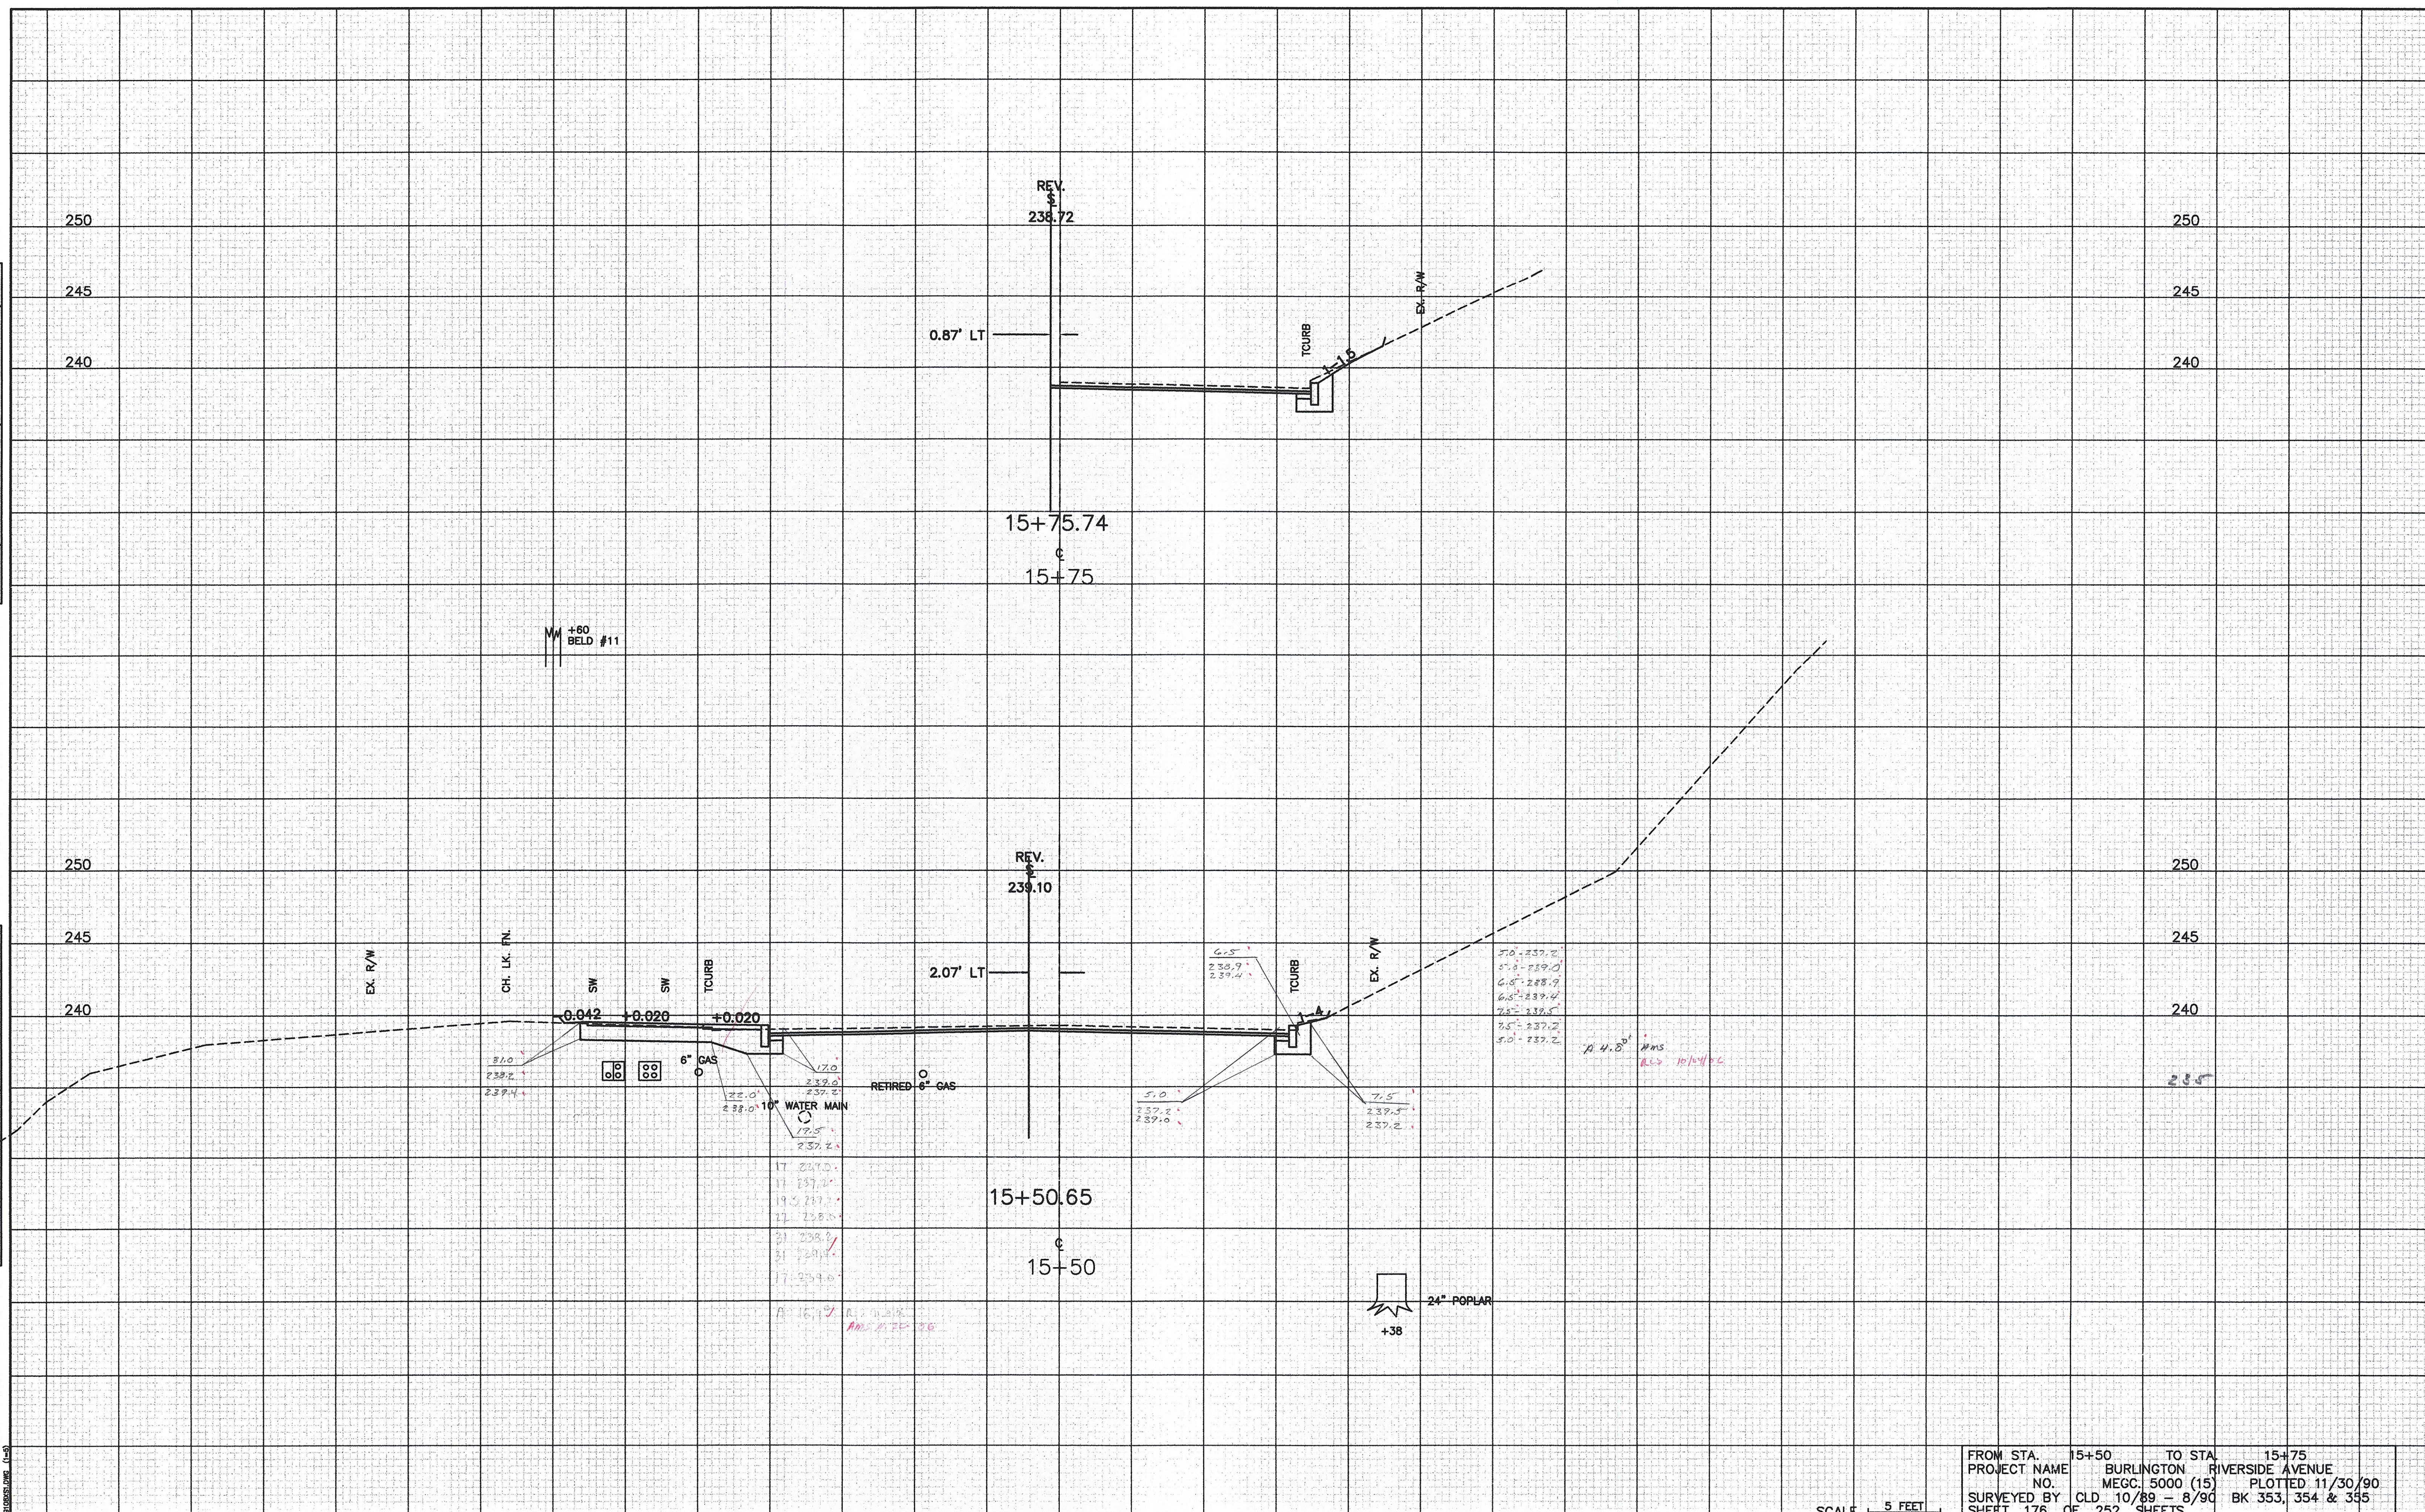

REVISIONS (if any)

SCALE 5 FEET

FROM STA.	15+50	TO STA.	15+75
PROJECT NAME	BURLINGTON	PROJECT NAME	RIVERSIDE AVENUE
NO.	MEGC. 5000 (15)	NO.	PLOTTED 11/30/90
SURVEYED BY	CLD 10/89 - 8/90	SURVEYED BY	BK 353, 354 & 355
SHEET	176 OF 252 SHEETS		