


DATE	
BY	
FINAL SURVEY	
FIELD NOTES	
NO. AREAS CHECKED	

DATE	
BY	
ORIGINAL SURVEY	
FIELD NOTES	
NO. AREAS CHECKED	

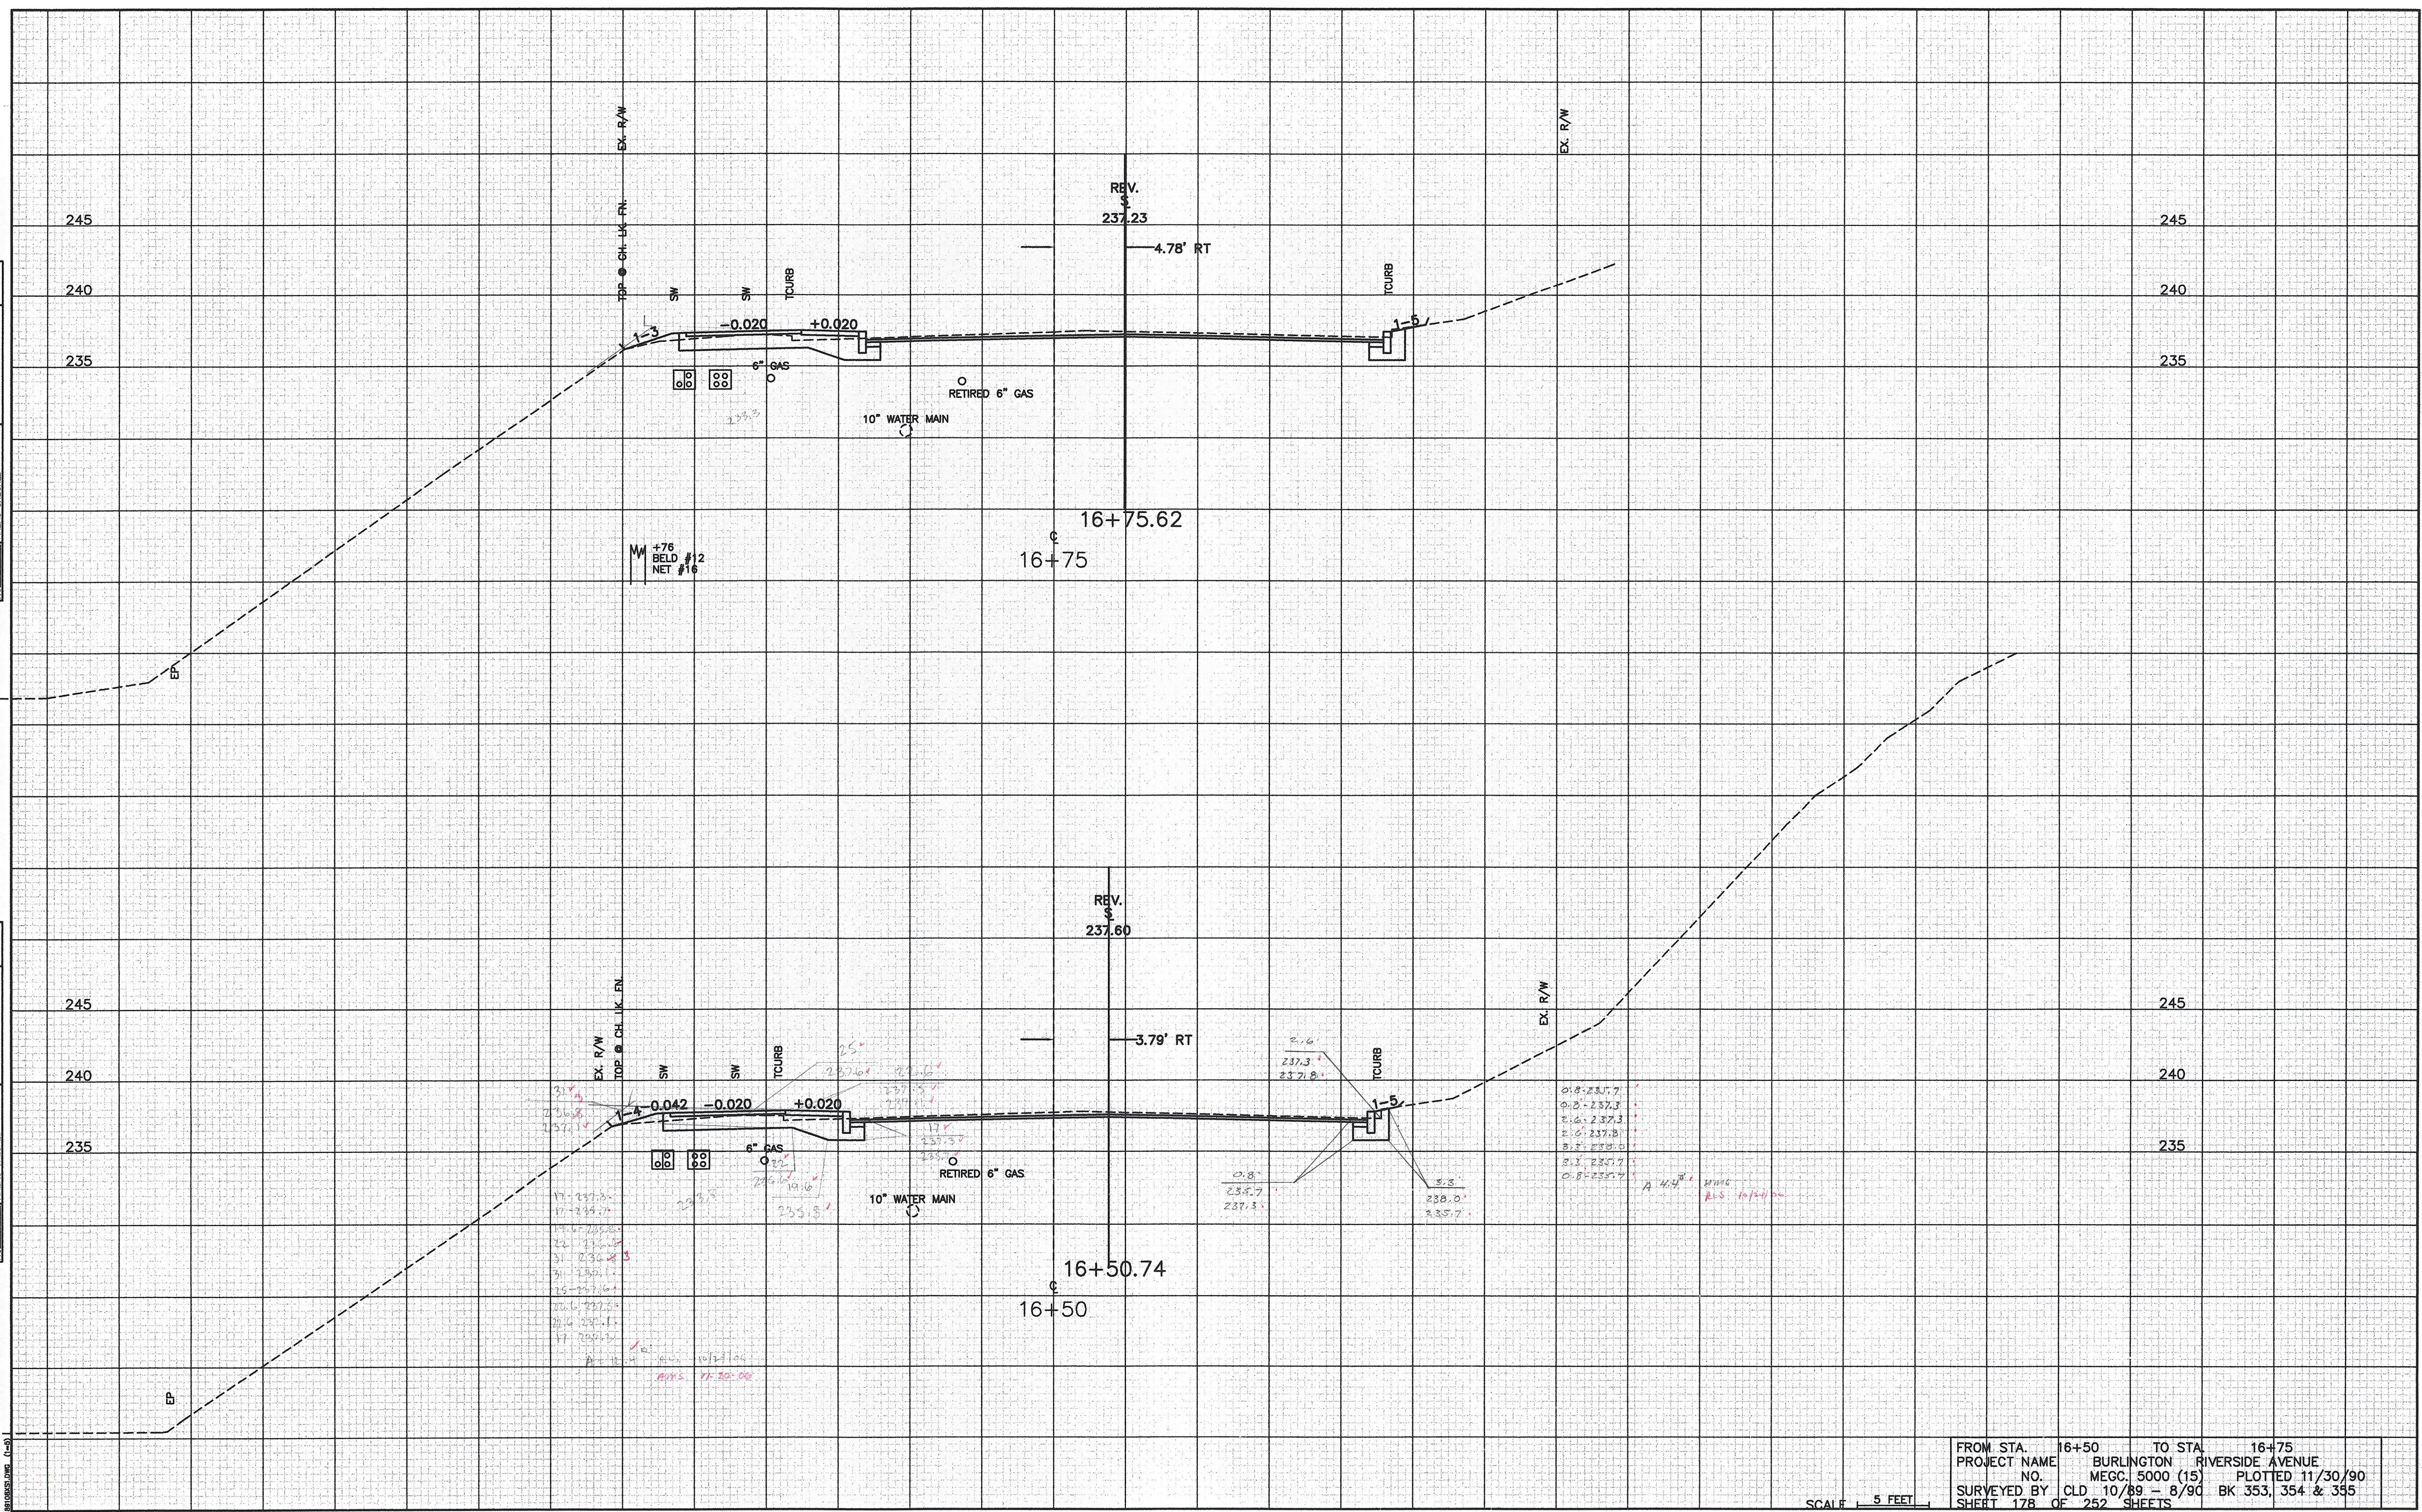

FROM STA. 16+50 TO STA. 16+75  
 PROJECT NAME BURLINGTON RIVERSIDE AVENUE  
 NO. MEGC. 5000 (15) PLOTTED 11/30/90  
 SURVEYED BY CLD 10/89 - 8/90 BK 353, 354 & 355  
 SHEET 178 OF 252 SHEETS

SCALE 1" = 5 FEET