


DATE	
BY	
NO.	
AREAS CHECKED	
AREAS	
TEMPLATE	
FINAL SURVEY	
NOTEBOOK	

DATE	
BY	
NO.	
AREAS CHECKED	
AREAS	
TEMPLATE	
ORIGINAL SURVEY	
NOTEBOOK	

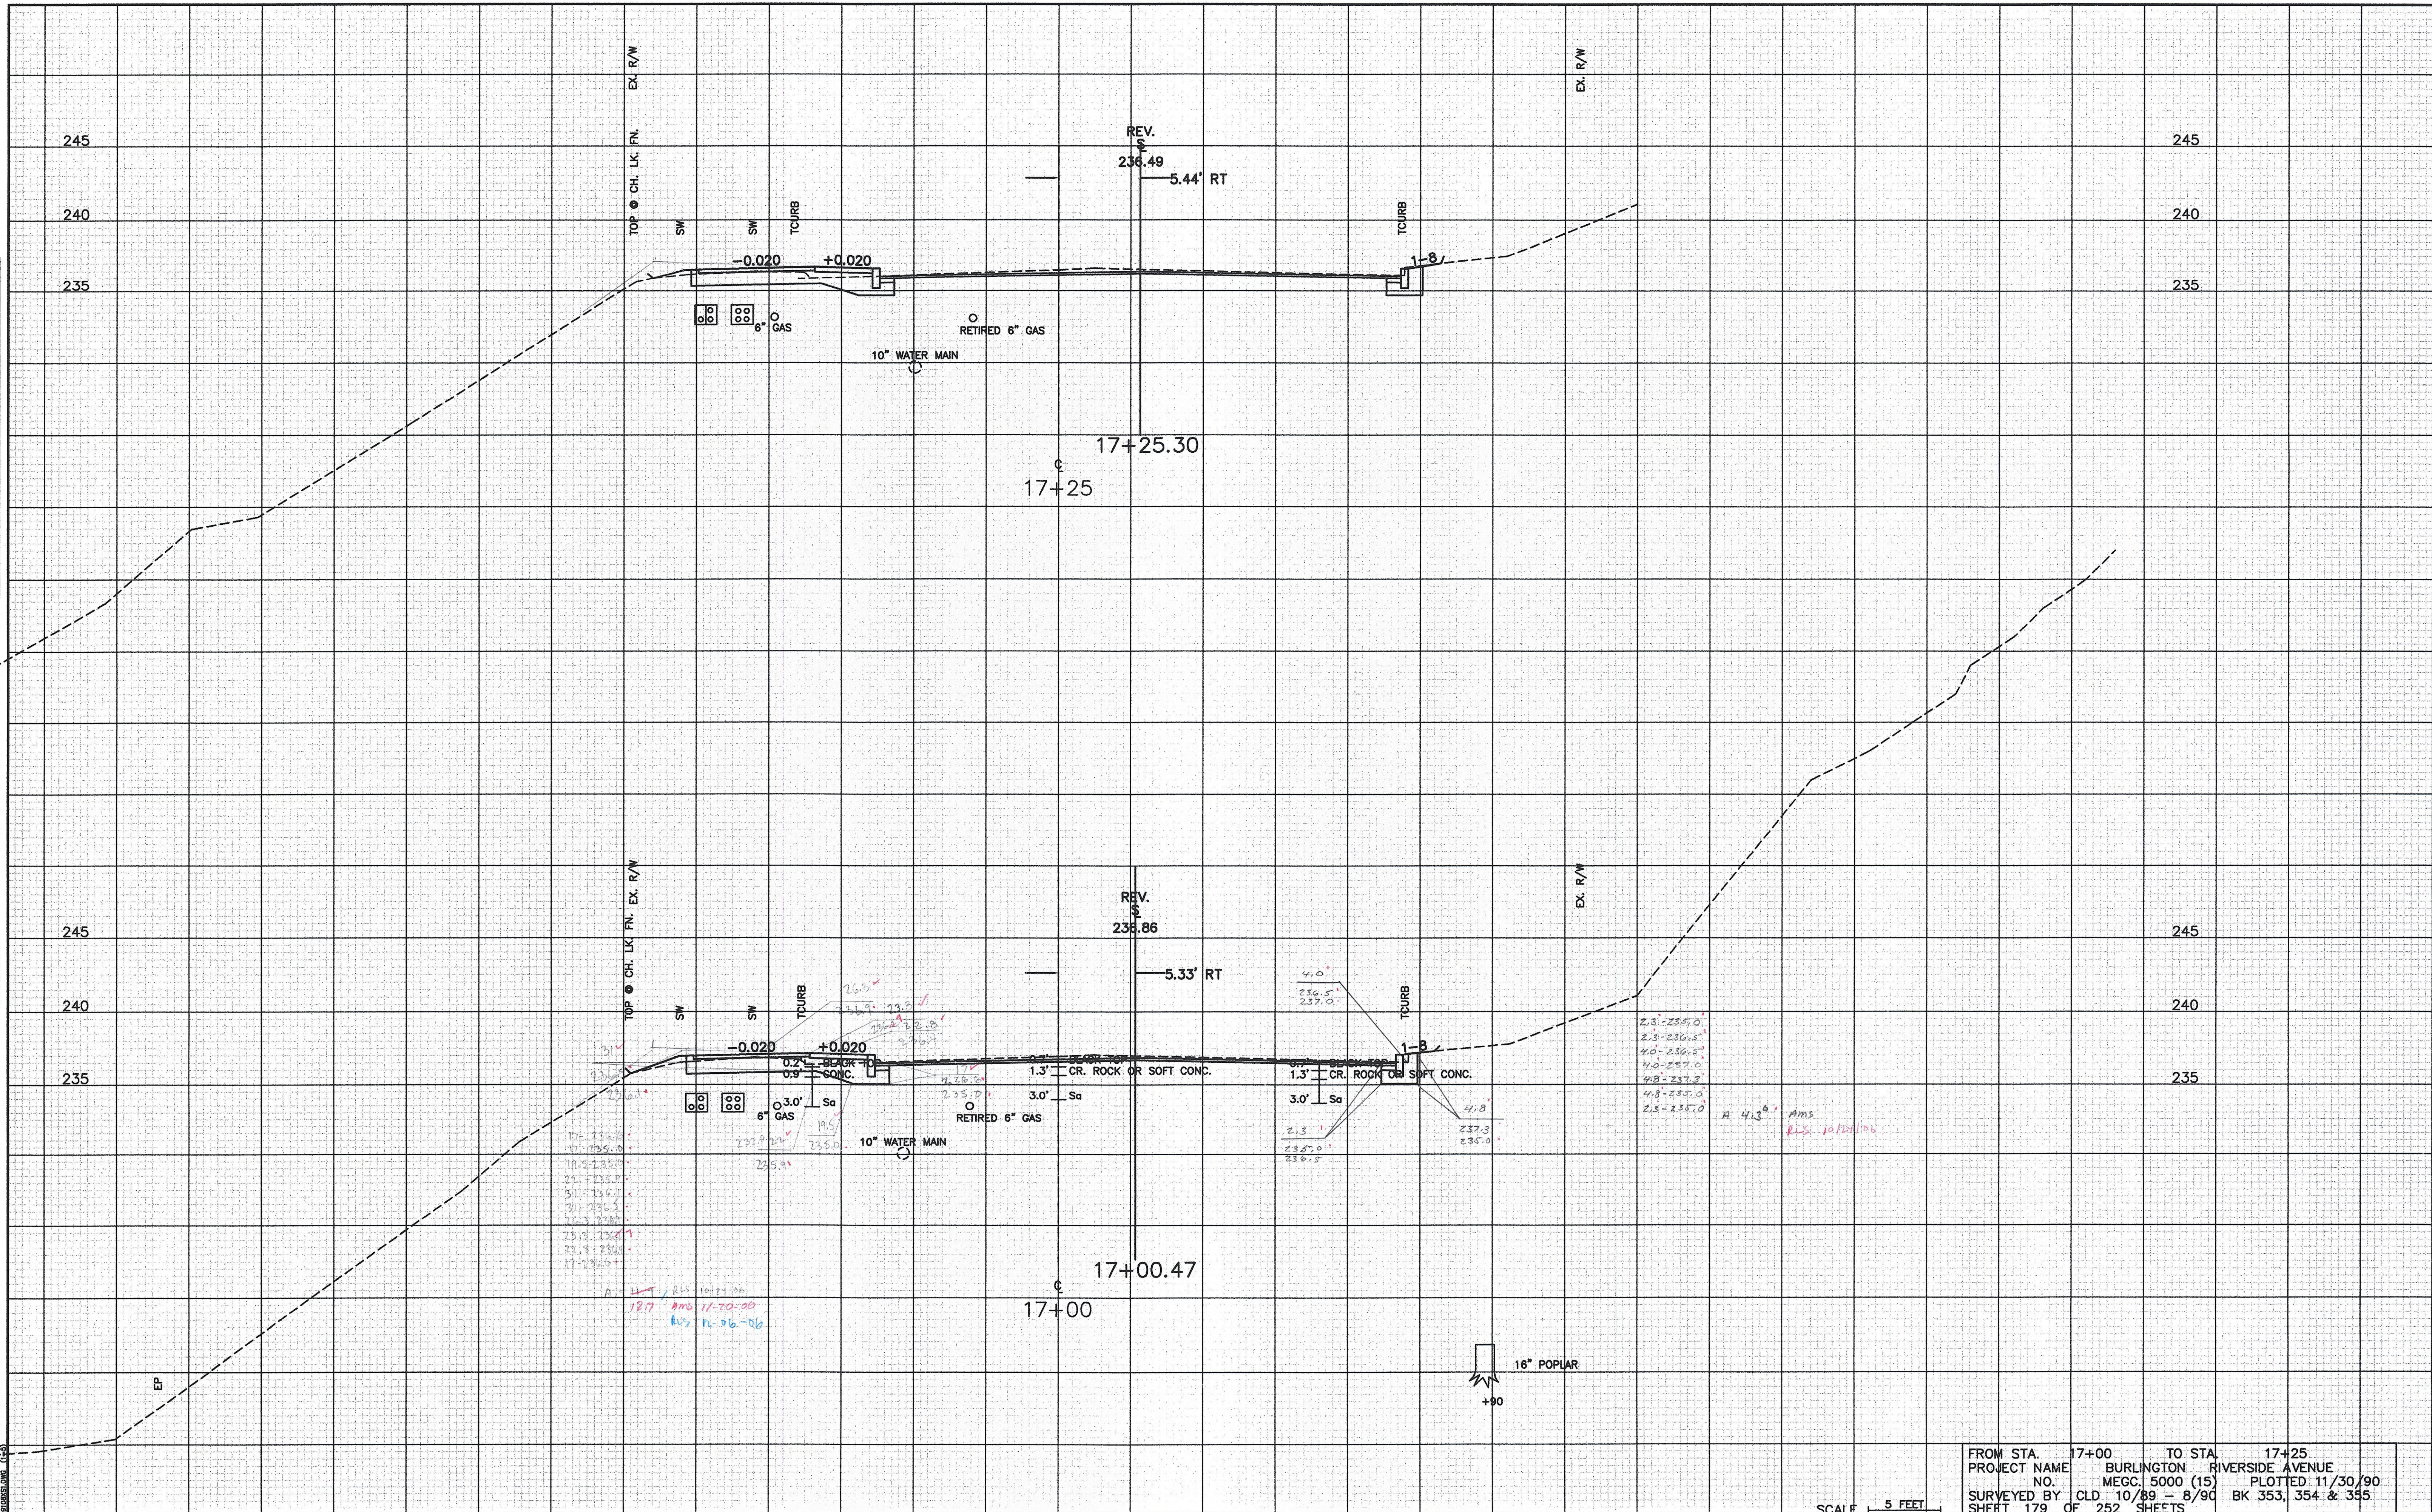

FROM STA. 17+00 TO STA. 17+25  
 PROJECT NAME BURLINGTON RIVERSIDE AVENUE  
 NO. MEGC. 5000 (15) PLOTTED 11/30/90  
 SURVEYED BY CLD 10/89 - 8/90 BK 353, 354 & 355  
 SHEET 179 OF 252 SHEETS

SCALE 5 FEET