


DATE	
BY	
SURVEYED	
PLOTTED	
TEMP. DATE	
NO. BOOK	
AREAS	
CHECKED	
NO.	

DATE	
BY	
SURVEYED	
PLOTTED	
TEMP. DATE	
NO. BOOK	
AREAS	
CHECKED	
NO.	

DATE	
BY	
SURVEYED	
PLOTTED	
TEMP. DATE	
NO. BOOK	
AREAS	
CHECKED	
NO.	

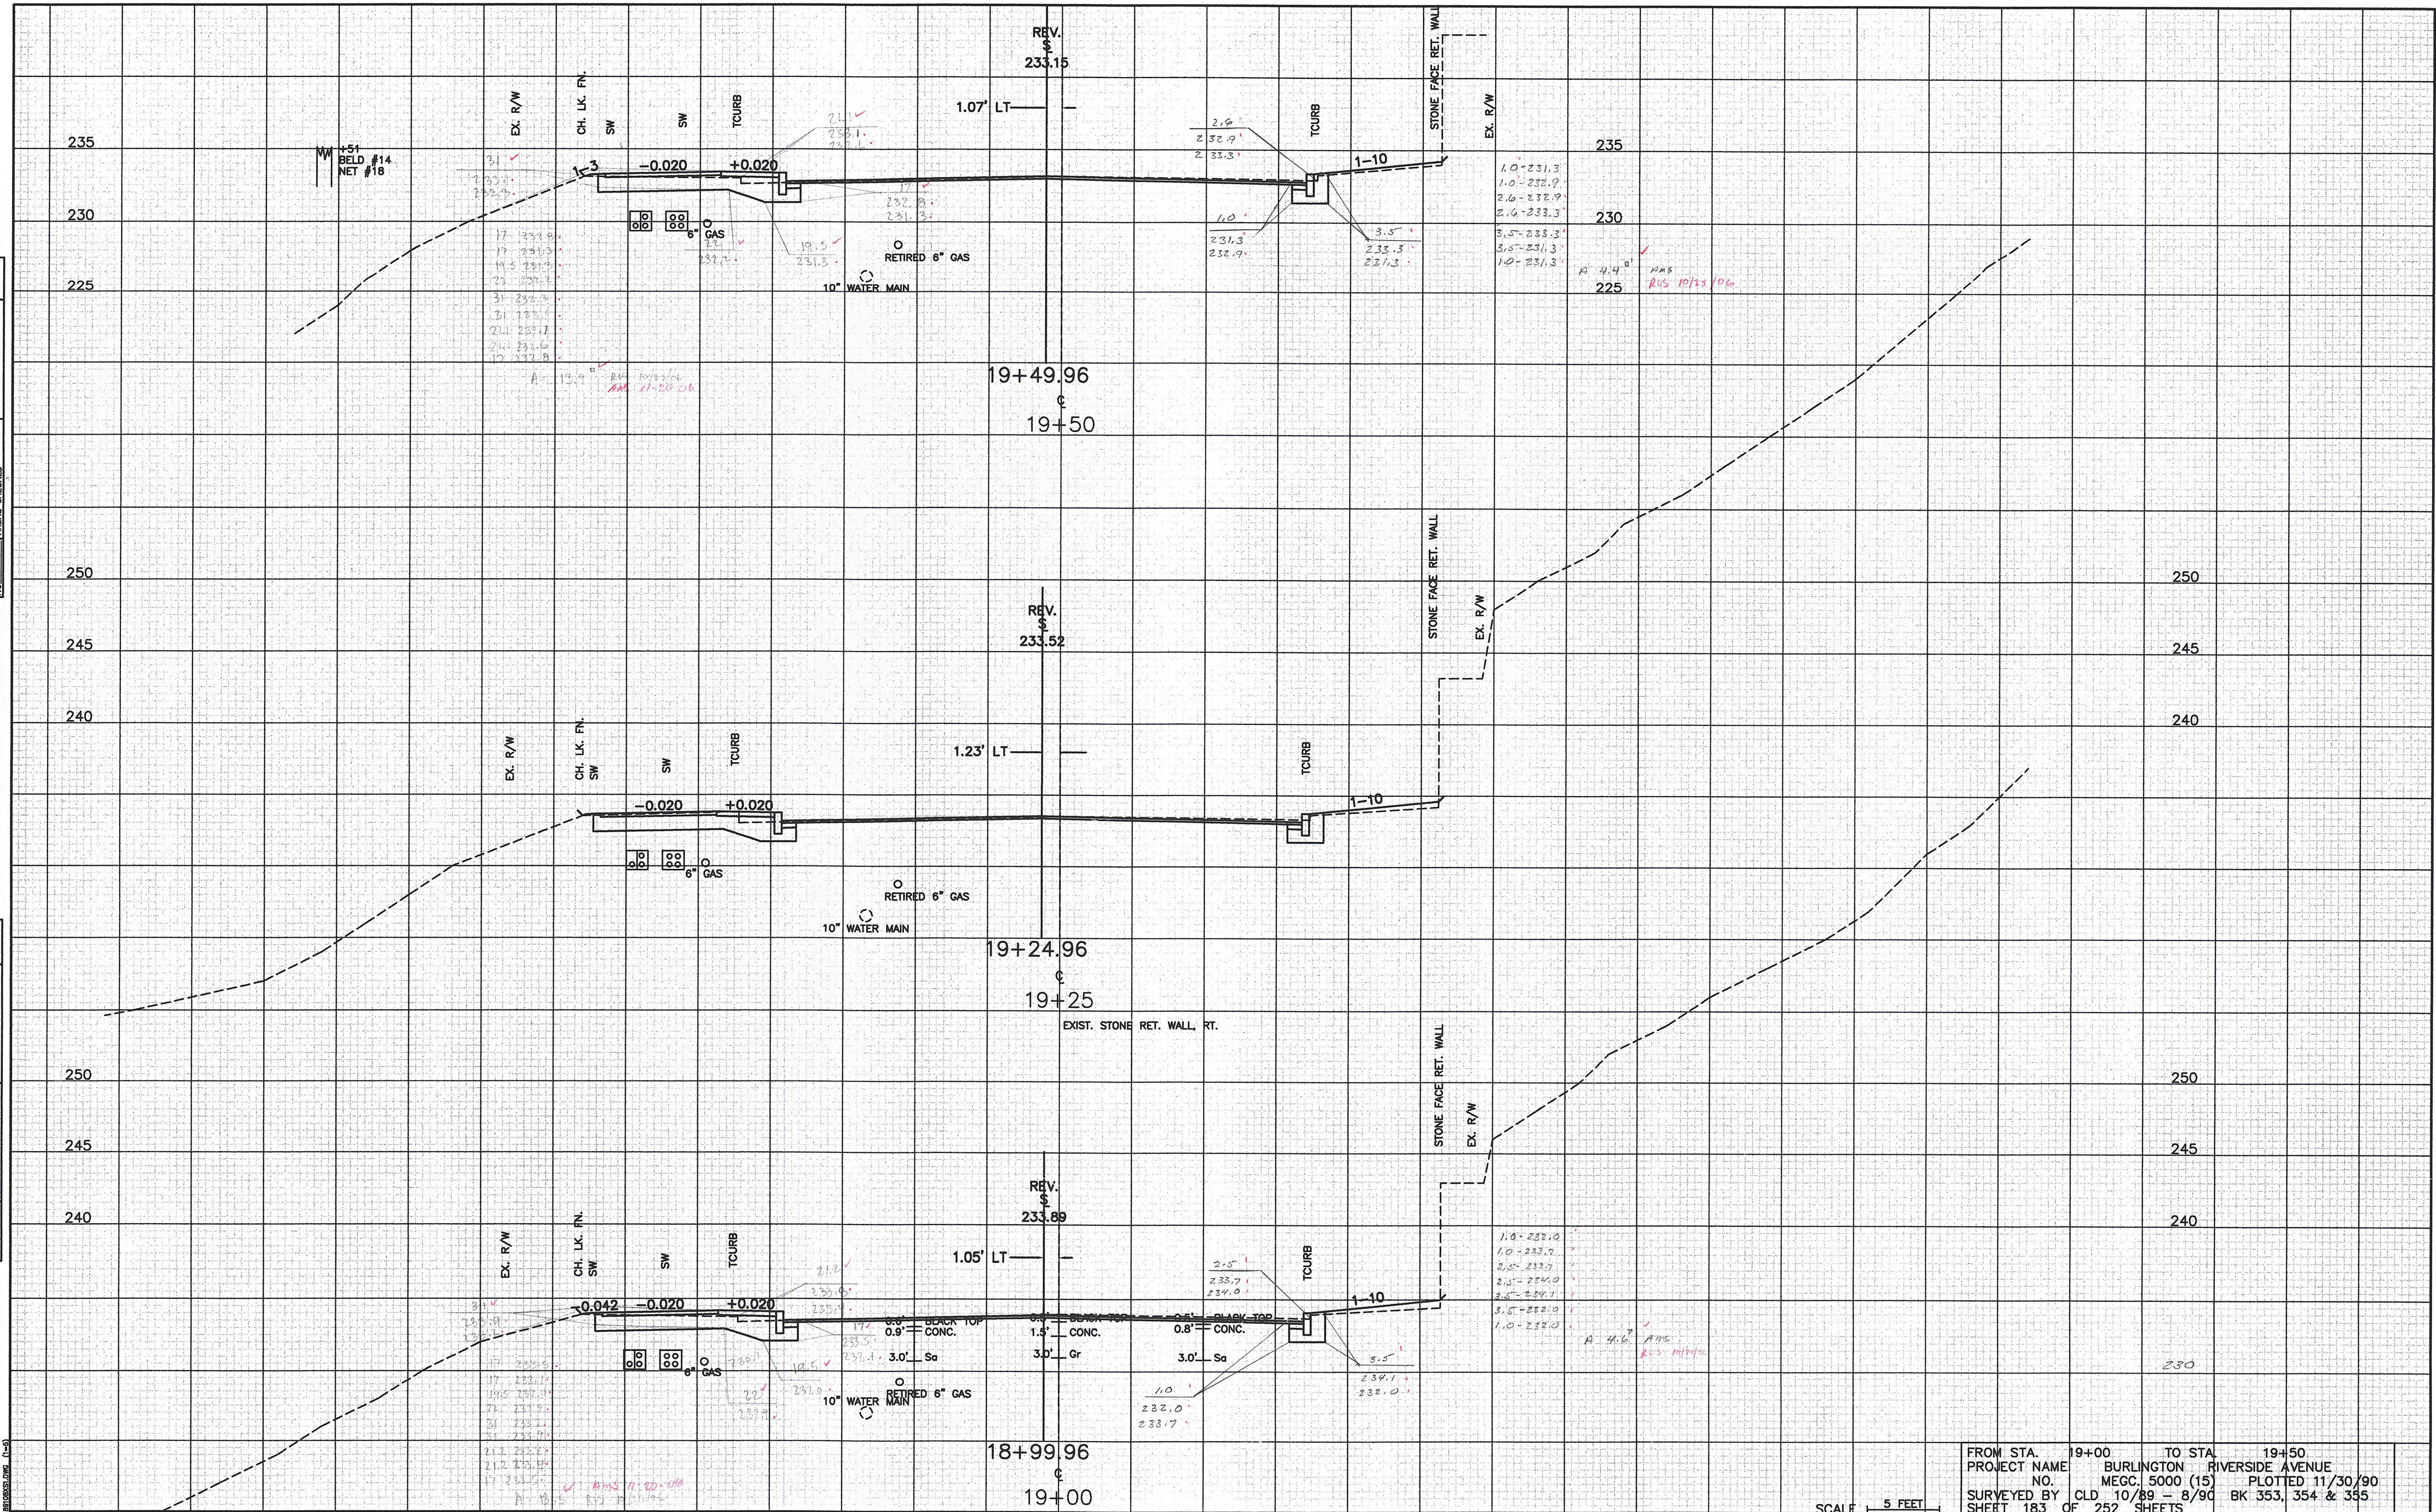

FROM STA. 19+00 TO STA. 19+50
 PROJECT NAME BURLINGTON RIVERSIDE AVENUE
 NO. MEGC. 5000 (15) PLOTTED 11/30/90
 SURVEYED BY CLD 10/89 - 8/90 BK 353, 354 & 355
 SHEET 183 OF 252 SHEETS

SCALE 5 FEET