FINAL SURVEY		BY	DATE
NOTEBOOK	SURVEYED		
	PLOTTED		
	TEMPLATE		
	AREAS		
NO.	AREAS CHECKED		

ORIGINAL SURVEY		BY	DATE
NOTEBOOK	SURVEYED		
	PLOTTED		
	TEMPLATE		
	AREAS		
NO.	AREAS CHECKED		

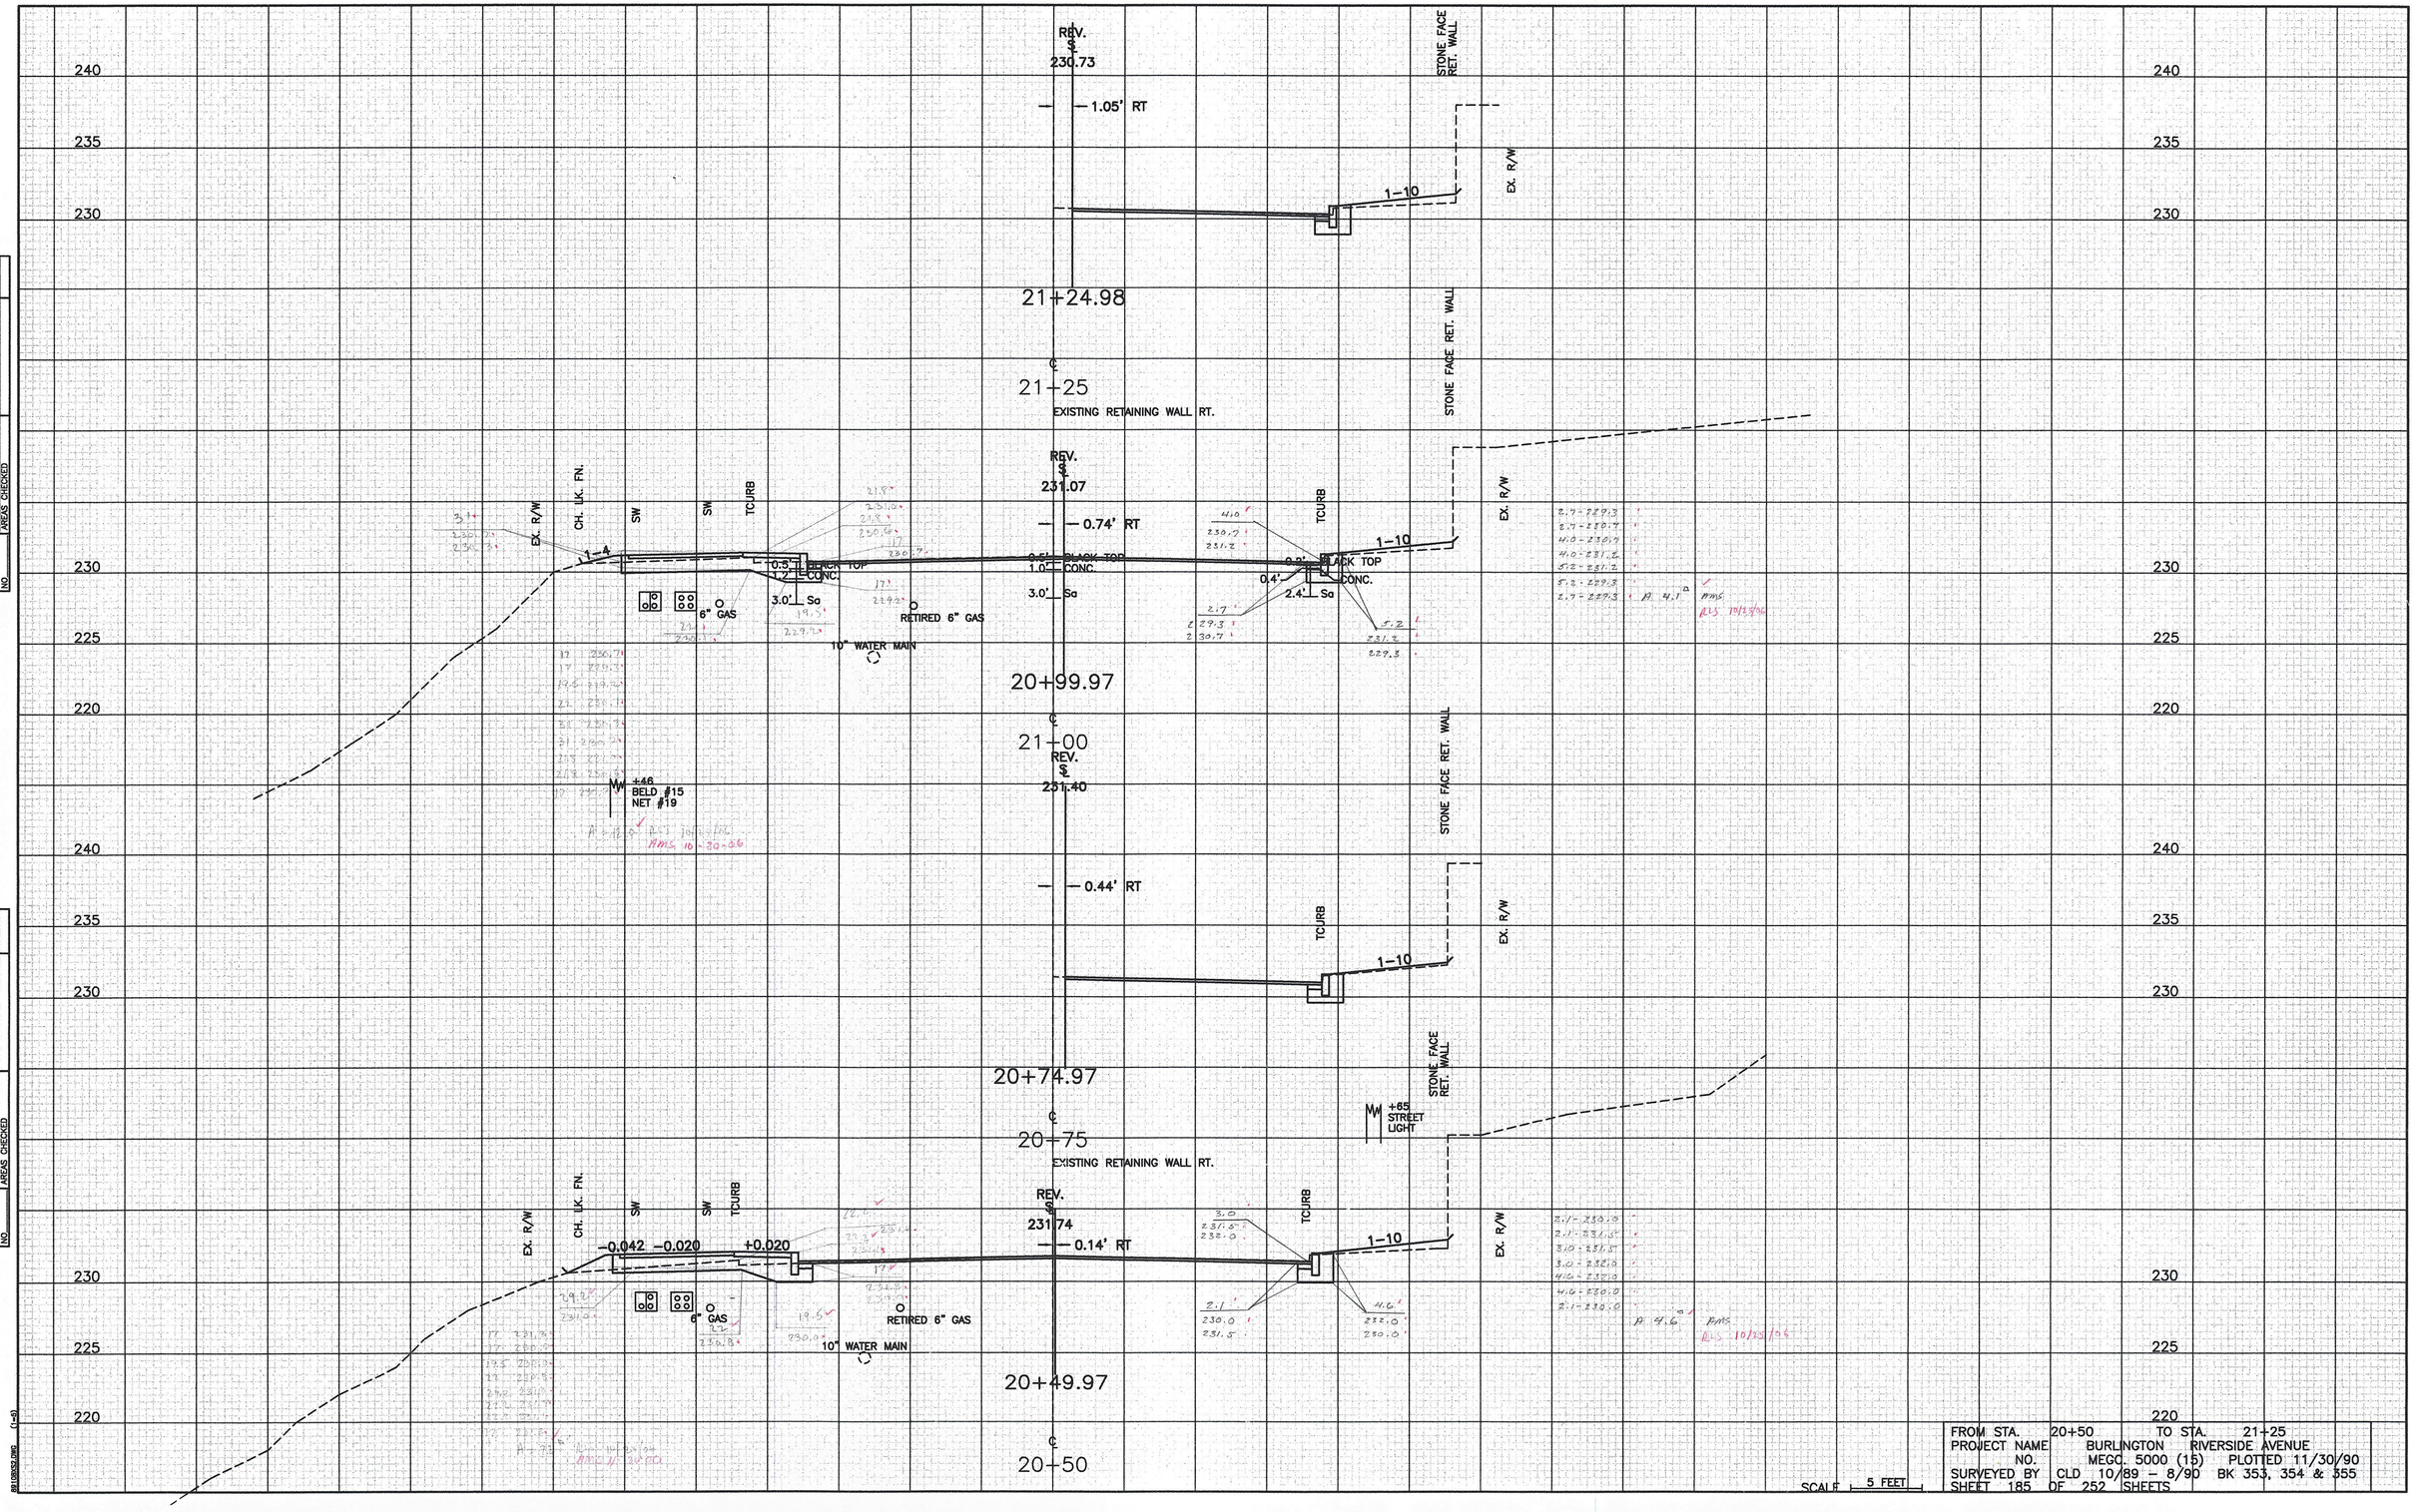

FROM STA. 20+50	TO STA. 21+25
PROJECT NAME BURLINGTON	RIVERSIDE AVENUE
NO. MEGC. 5000 (15)	PLOTTED 11/30/90
SURVEYED BY CLD 10/89 – 8/90	BK 353, 354 & 355
SHEET 185 OF 252 SHEETS	

SCALE 5 FEET