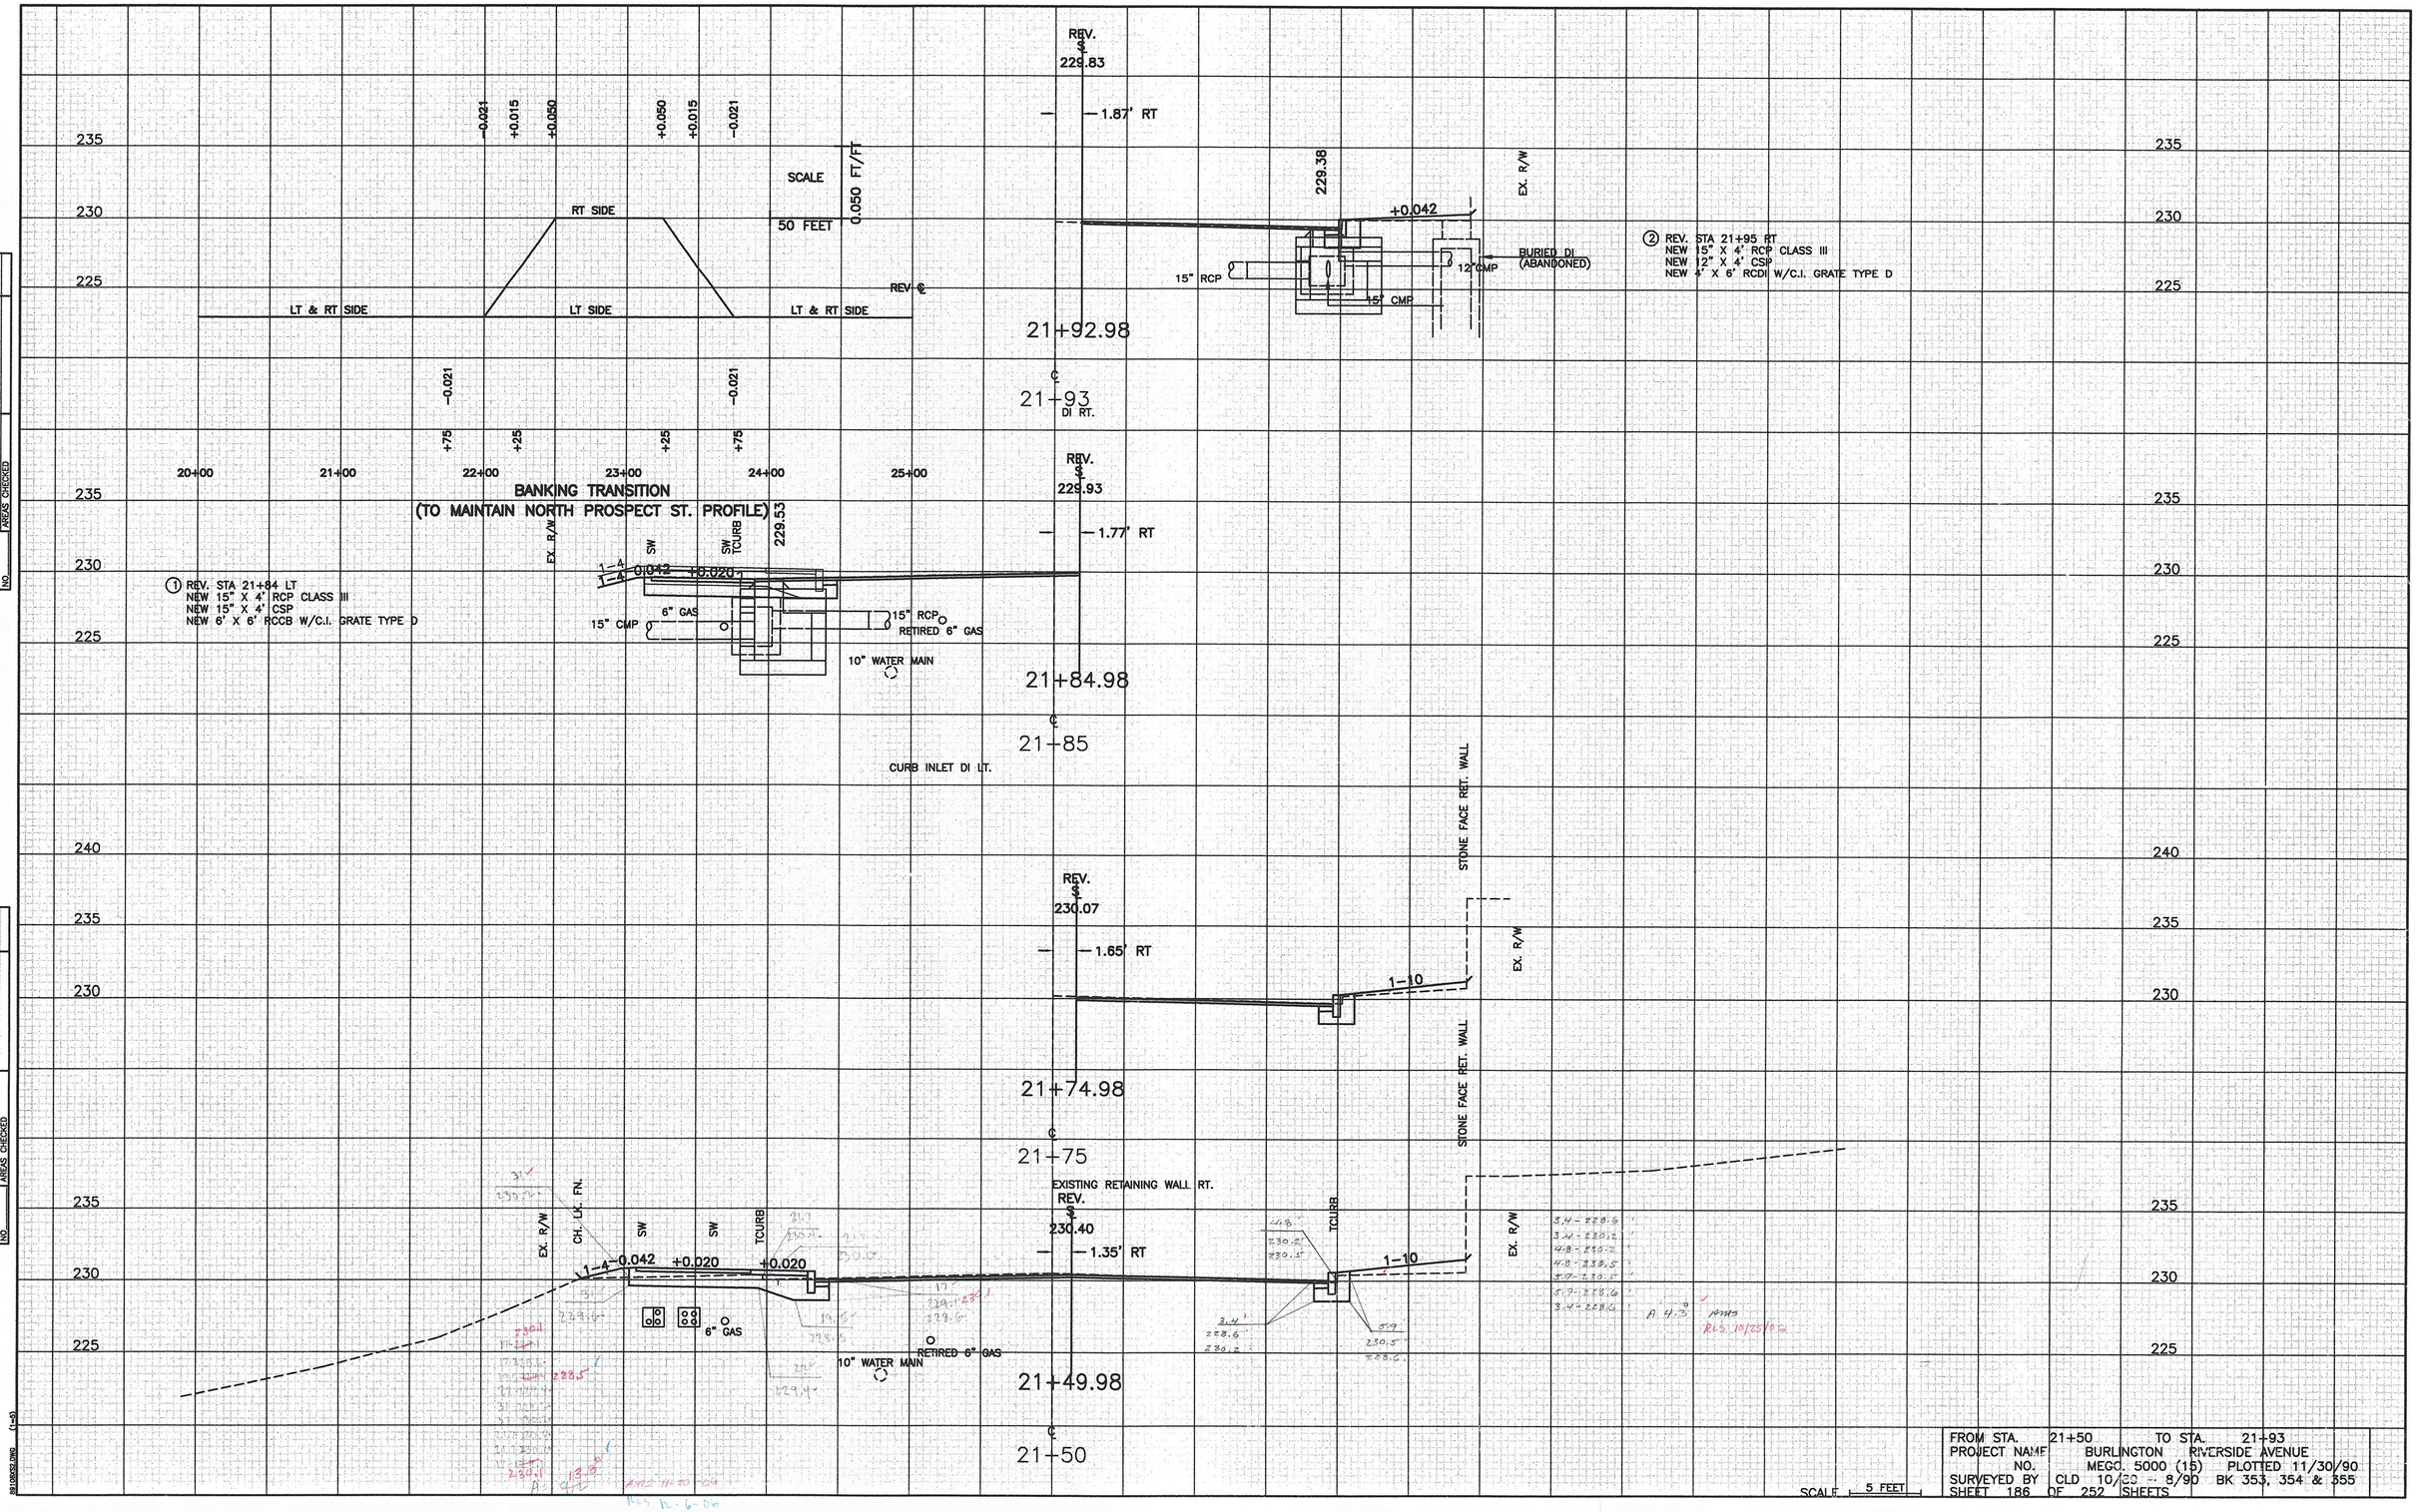

FROM STA. 21+50	TO STA. 21+93
PROJECT NAME	BURLINGTON RIVERSIDE AVENUE
NO.	MEGC. 5000 (15) PLOTTED 11/30/90
SURVEYED BY	CLD 10/90 - 8/90 BK 353, 354 & 355
SHEET 186 OF 252	SHEETS

FINAL SURVEY		BY	DATE
	SURVEYED		
	PLOTTED		
	TEMPLATE		
	AREAS		
NOTEBOOK	AREAS CHECKED		
NO.			

ORIGINAL SURVEY		BY	DATE
	SURVEYED		
	PLOTTED		
	TEMPLATE		
	AREAS		
NOTEBOOK	AREAS CHECKED		
NO.			

(1-9)