


DATE	
BY	
FINAL SURVEY	
SURVEY PLOTTED	
NOTED	
AREAS CHECKED	
NO	

DATE	
BY	
ORIGINAL SURVEY	
SURVEY PLOTTED	
NOTED	
AREAS CHECKED	
NO	

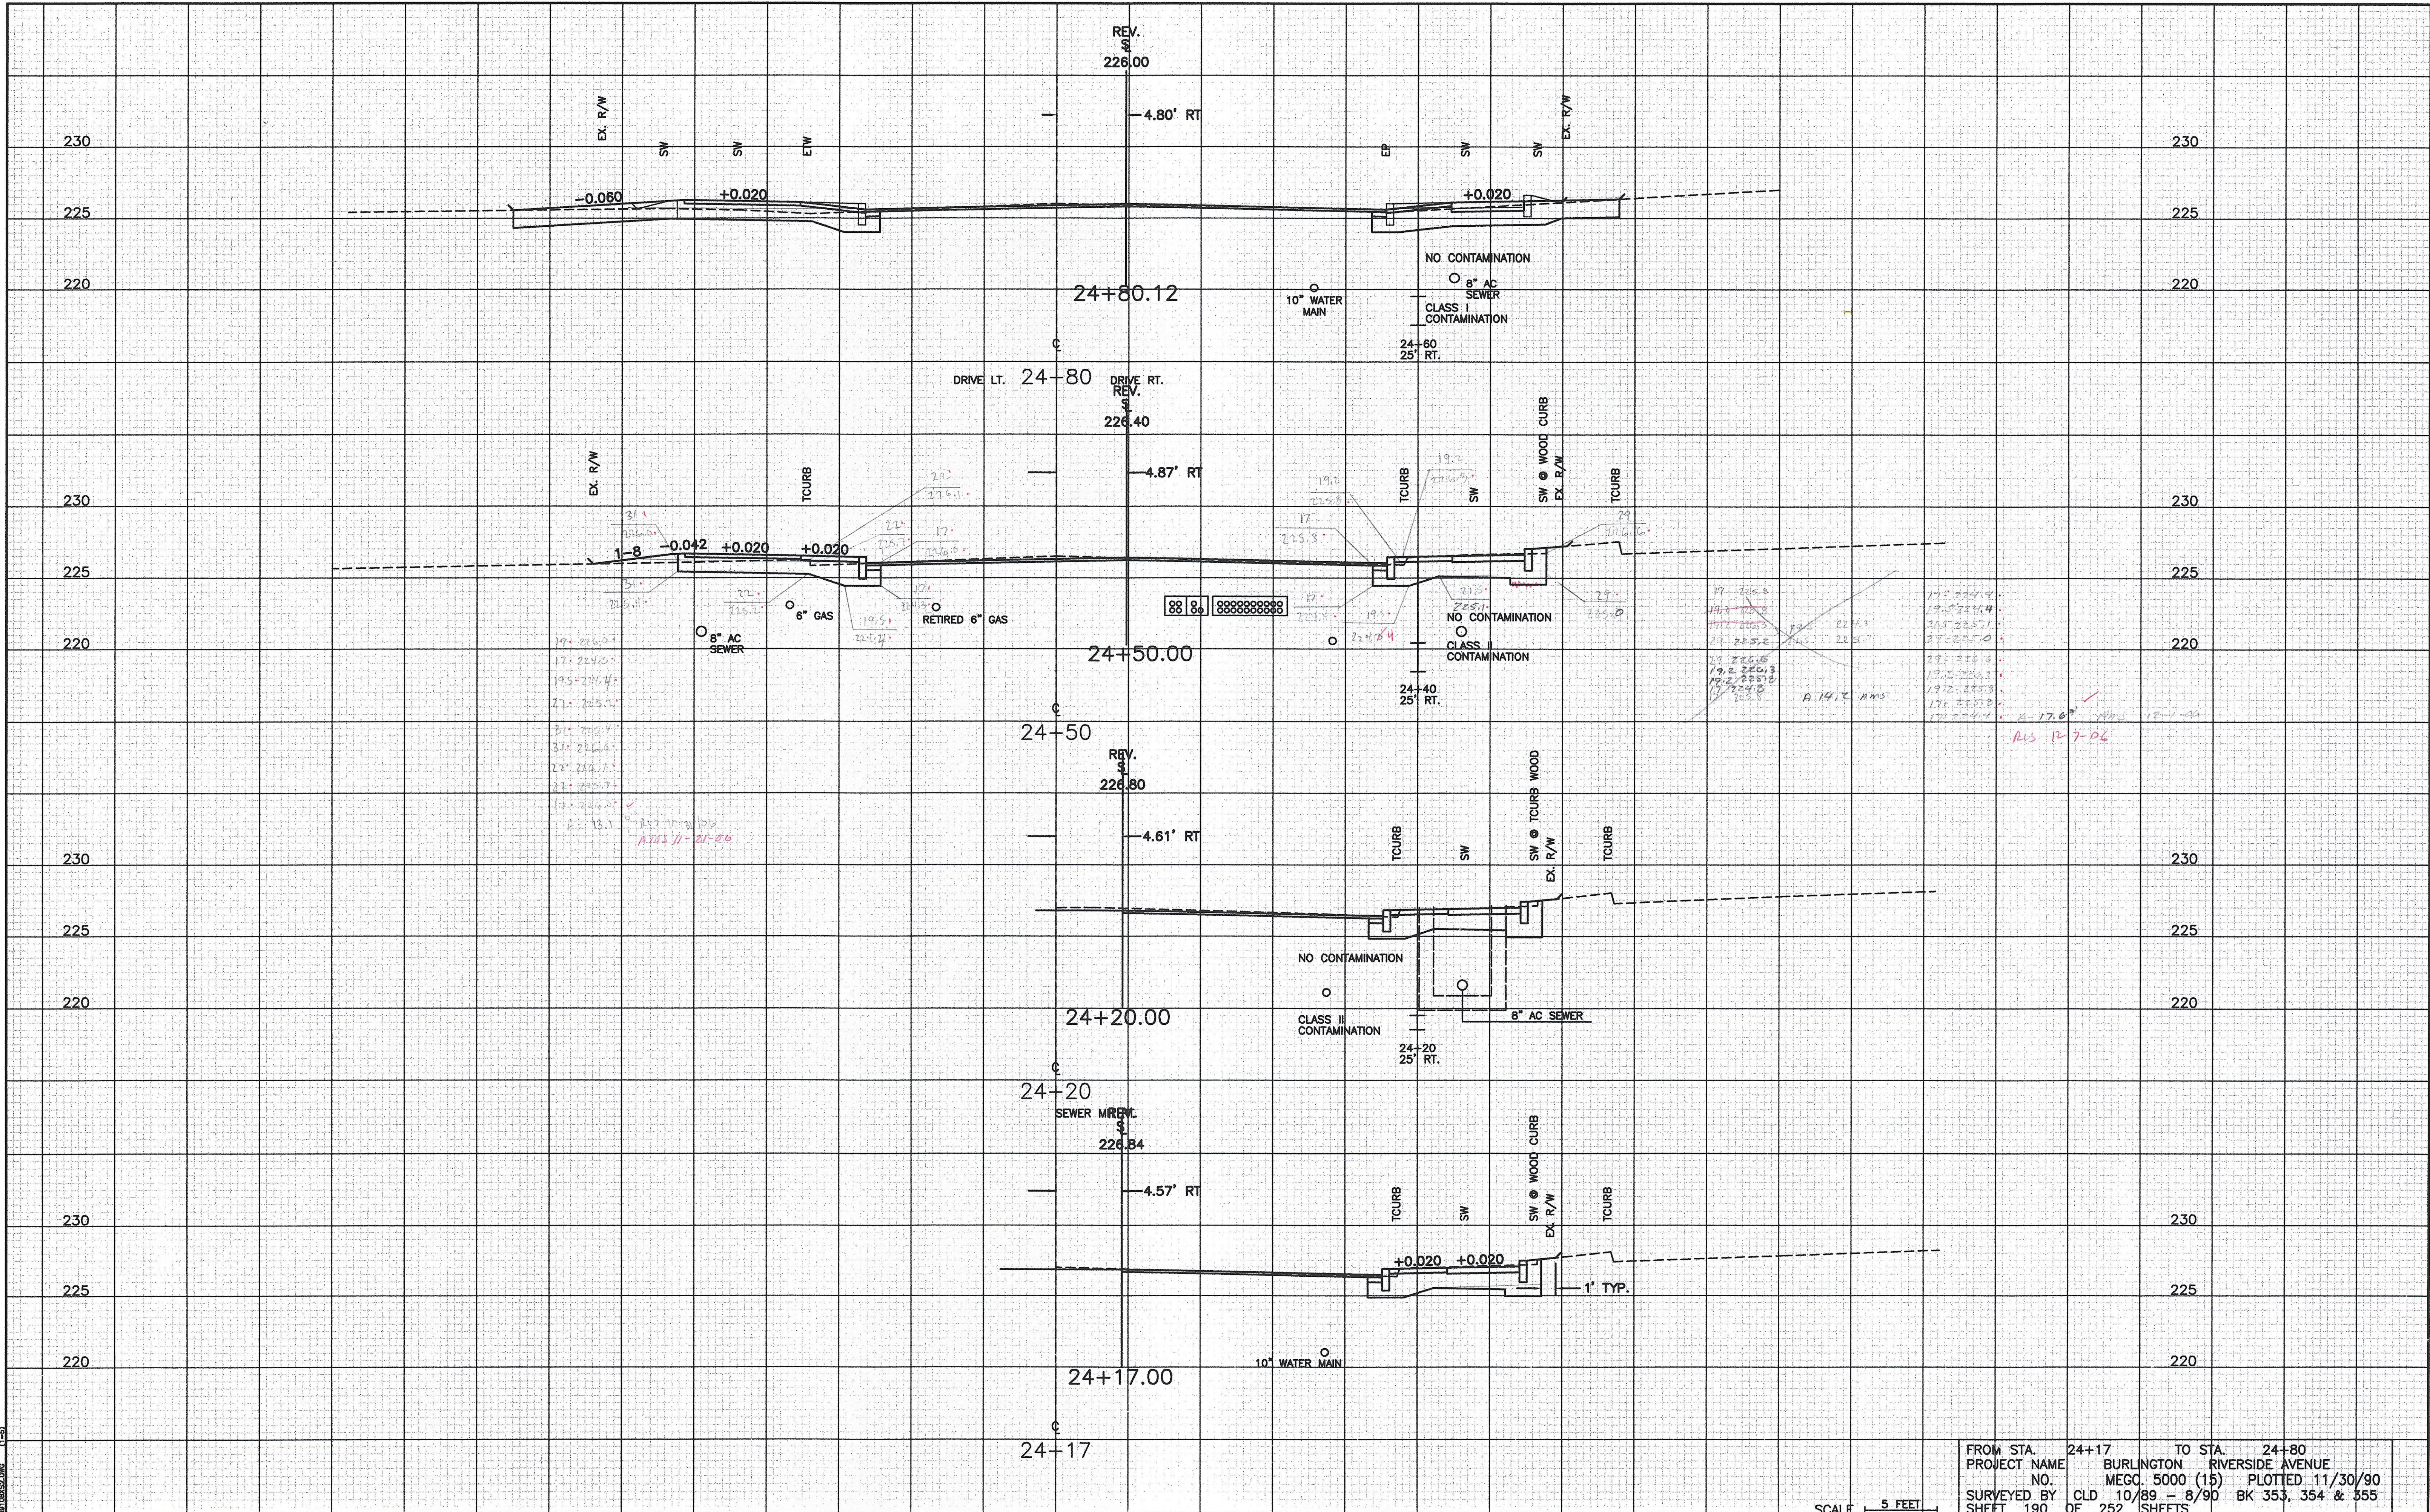

FROM STA. 24+17 TO STA. 24+80
 PROJECT NAME BURLINGTON RIVERSIDE AVENUE
 NO. MEGC. 5000 (15) PLOTTED 11/30/90
 SURVEYED BY CLD 10/89 - 8/90 BK 353, 354 & 355
 SHEET 190 OF 252 SHEETS

SCALE 5 FEET

SUBSIDIARY