


DATE	
BY	
FINAL SURVEY NO.	
SURVEYED	
PLOTTED	
DATE	
AREAS CHECKED	

DATE	
BY	
ORIGINAL SURVEY NO.	
SURVEYED	
PLOTTED	
DATE	
AREAS CHECKED	

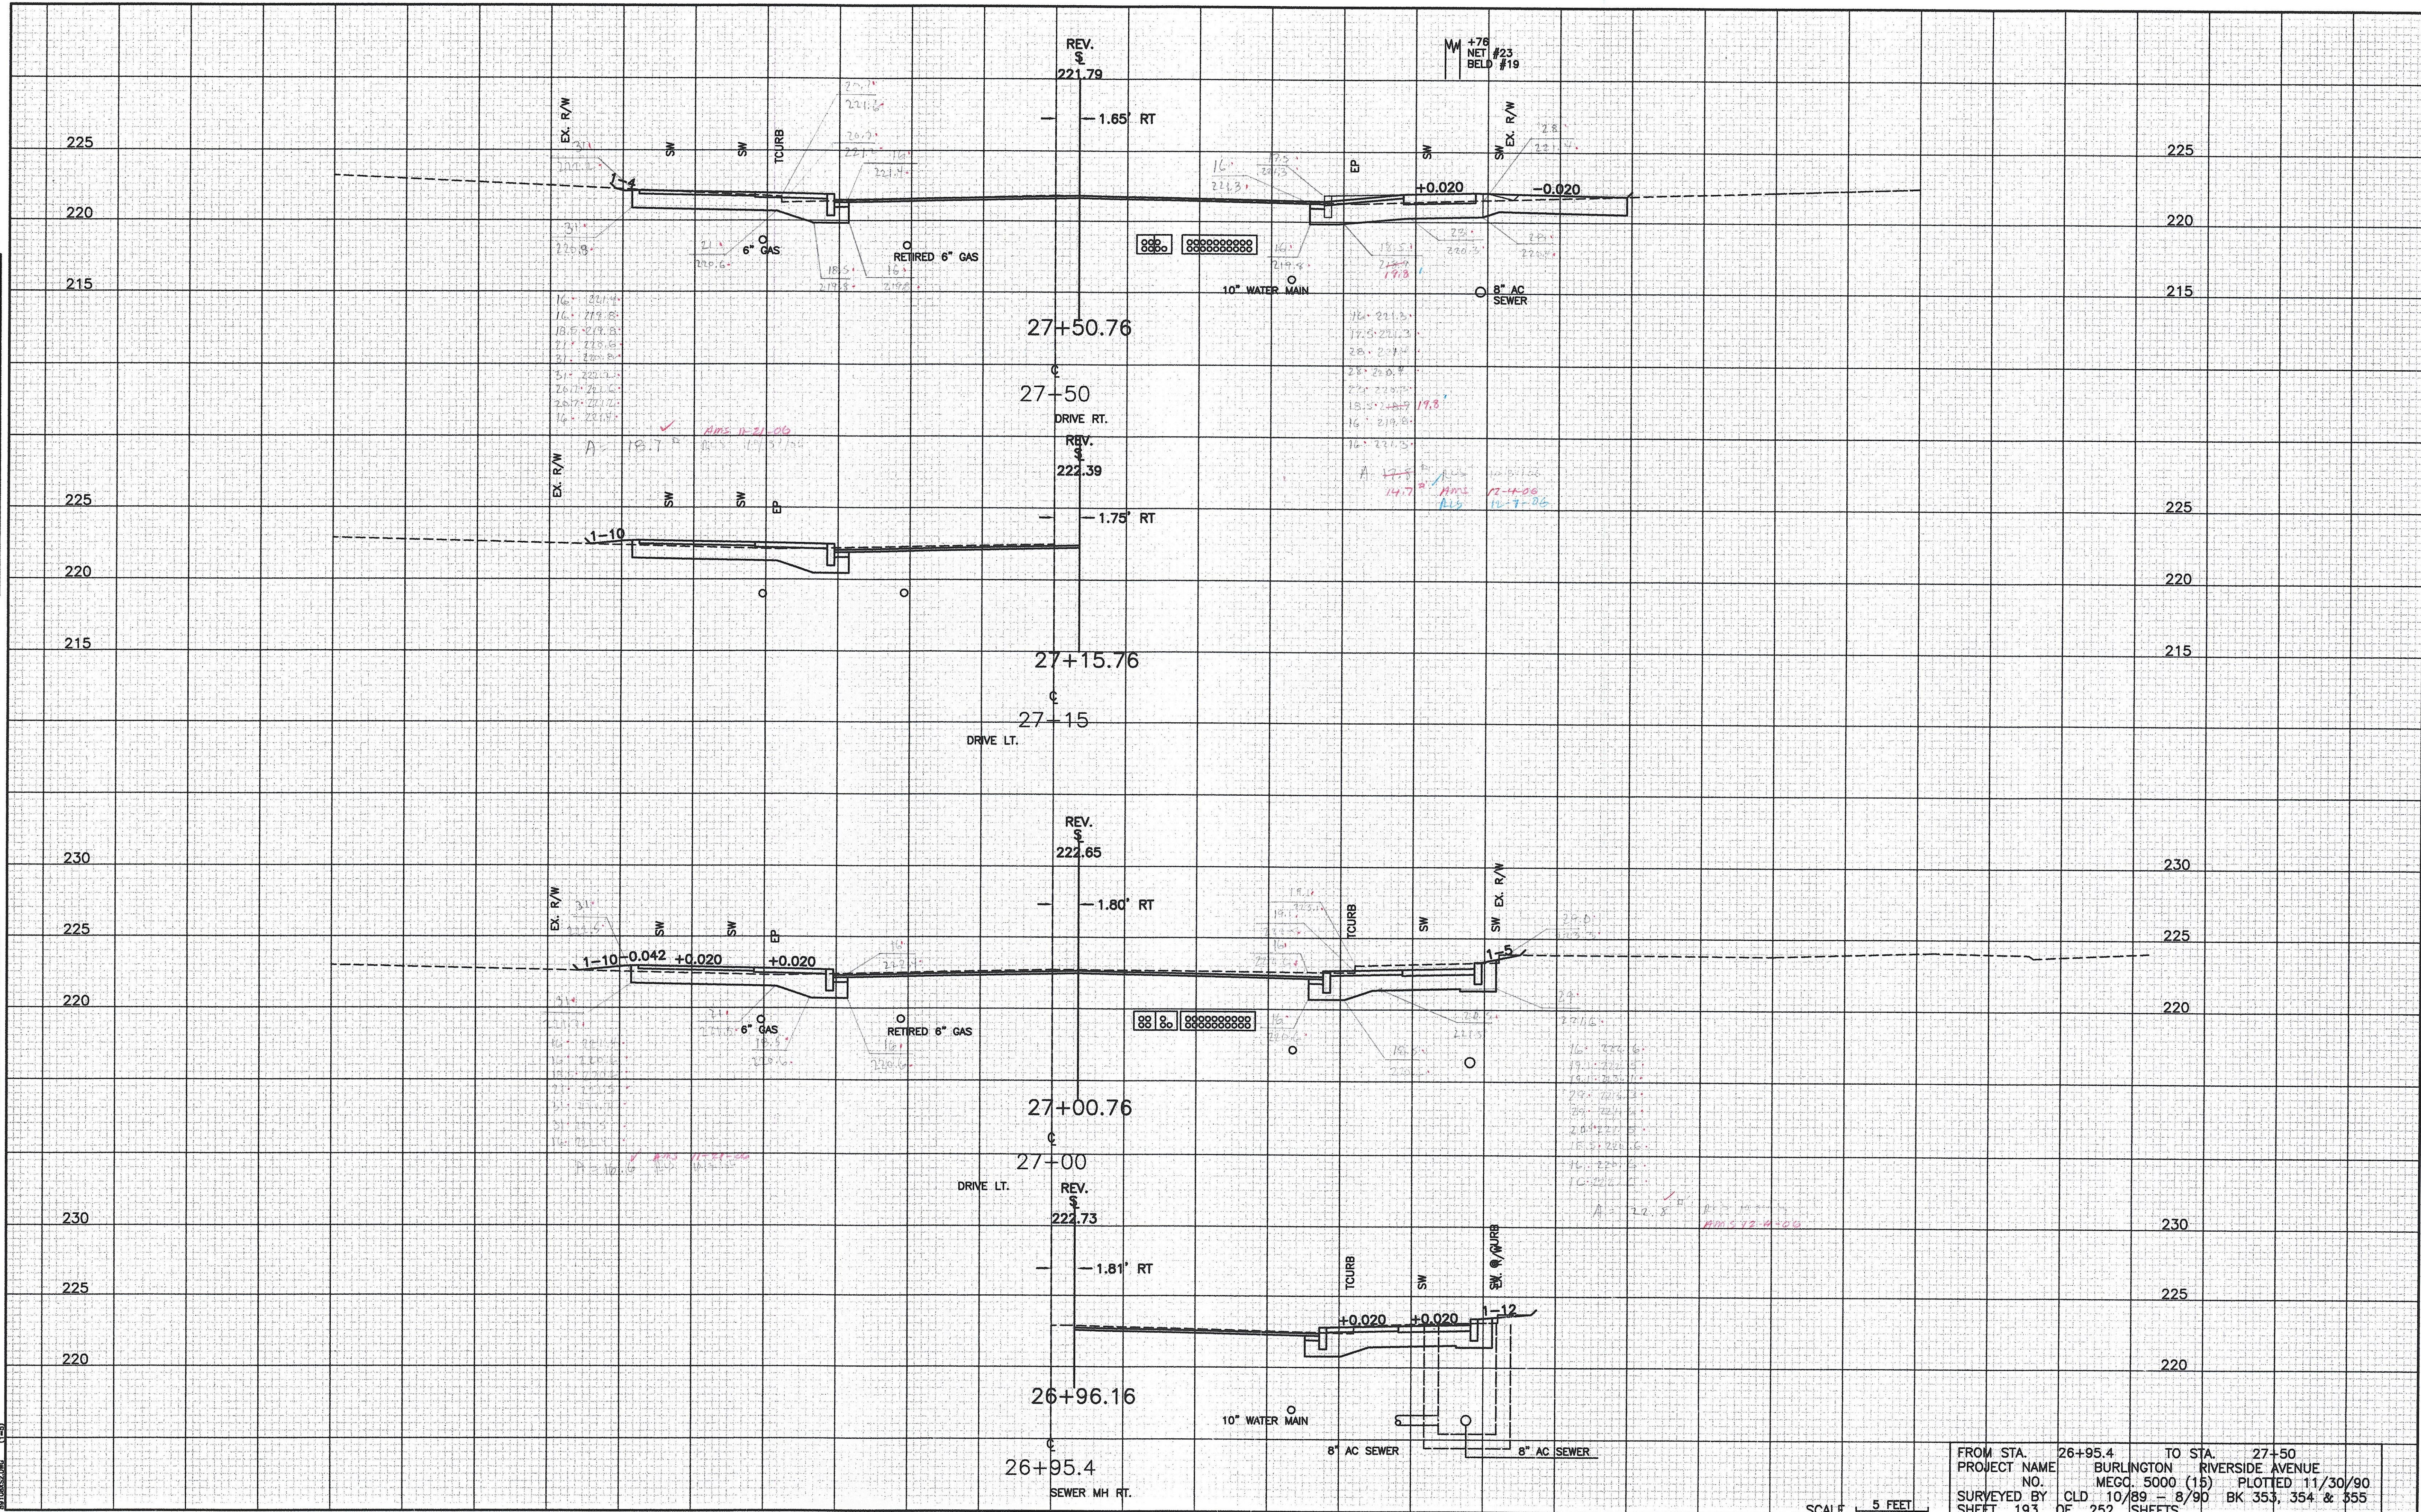

FROM STA. 26+95.4 TO STA. 27+50  
 PROJECT NAME BURLINGTON RIVERSIDE AVENUE  
 NO. MEGC. 5000 (15) PLOTTED 11/30/90  
 SURVEYED BY CLD 10/89 = 8/90 BK 353, 354 & 355  
 SHEET 193 OF 252 SHEETS

SCALE 1" = 5 FEET