


DATE	
BY	
NO.	
FINAL SURVEY	
TEMPERATURE	
NOTEBOOK	
AREAS CHECKED	

DATE	
BY	
NO.	
ORIGINAL SURVEY	
TEMPERATURE	
NOTEBOOK	
AREAS CHECKED	

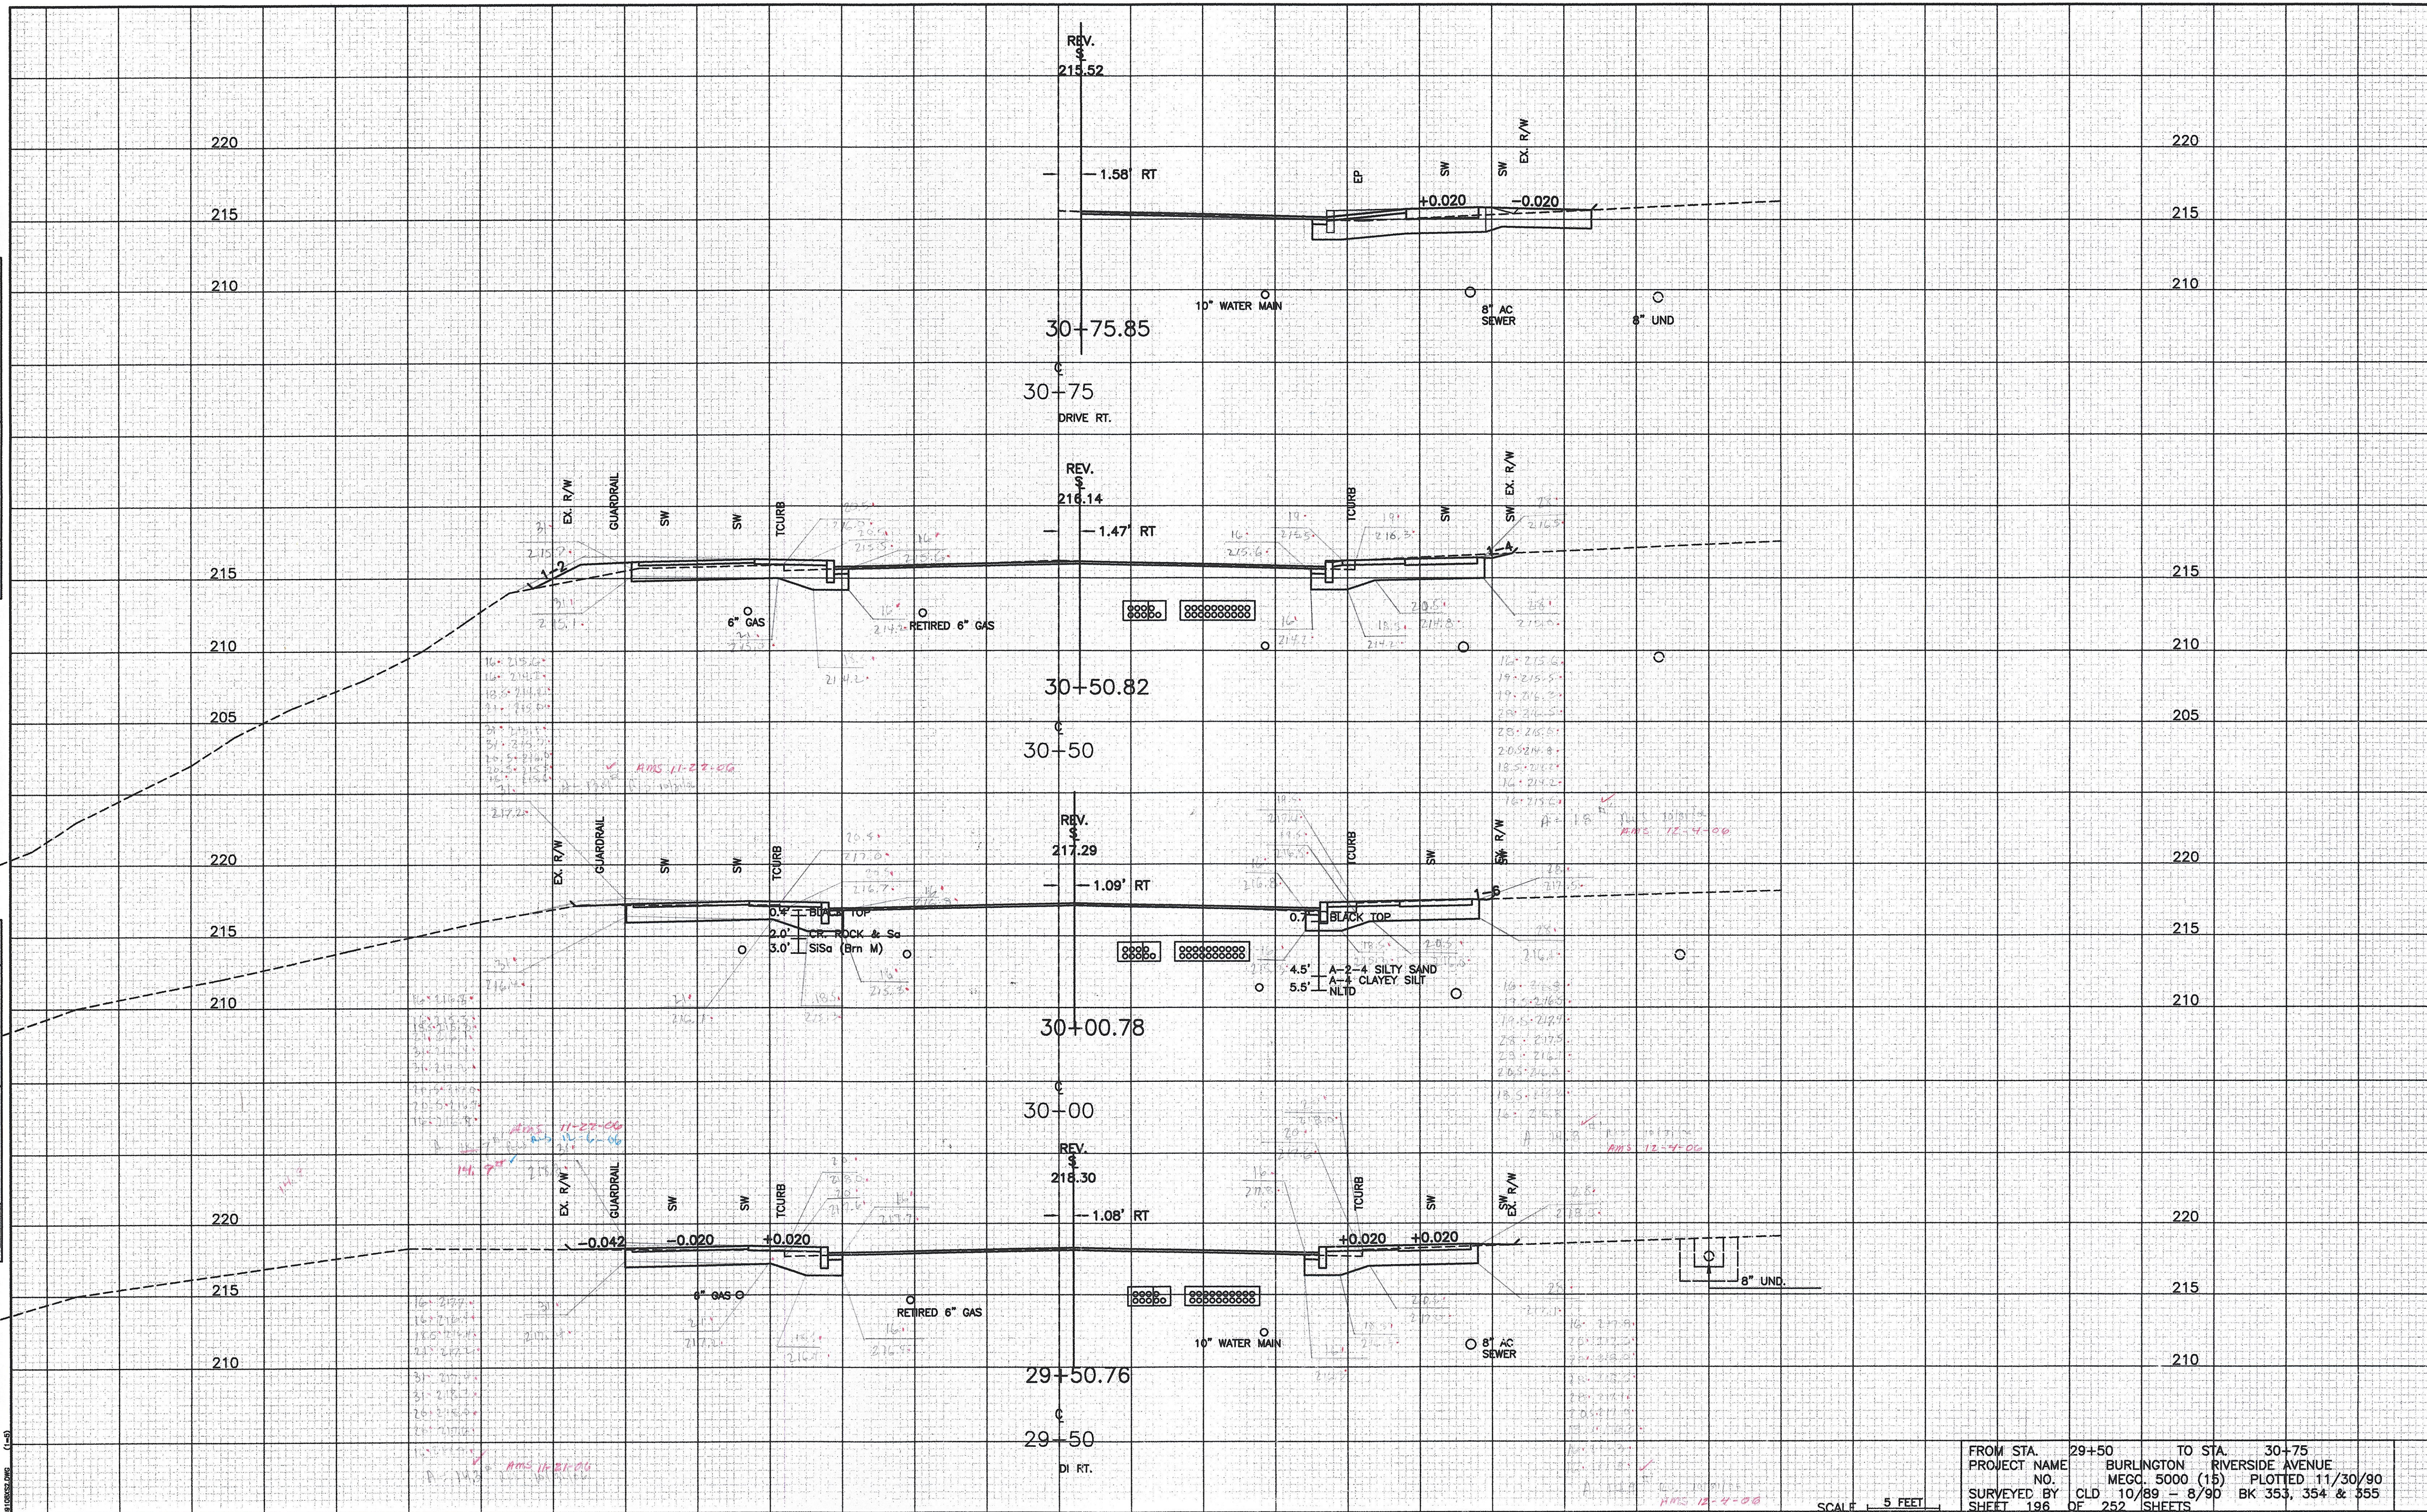

SCALE 5 FEET

FROM STA. 29+50 TO STA. 30+75
 PROJECT NAME BURLINGTON RIVERSIDE AVENUE
 NO. MEGC. 5000 (15) PLOTTED 11/30/90
 SURVEYED BY CLD 10/89 - 8/90 BK 353, 354 & 355
 SHEET 196 OF 252 SHEETS