


DATE	
BY	
FINAL SURVEY NO.	
PLOTTED	
NOTED	
AREAS CHECKED	

DATE	
BY	
ORIGINAL SURVEY NO.	
PLOTTED	
NOTED	
AREAS CHECKED	

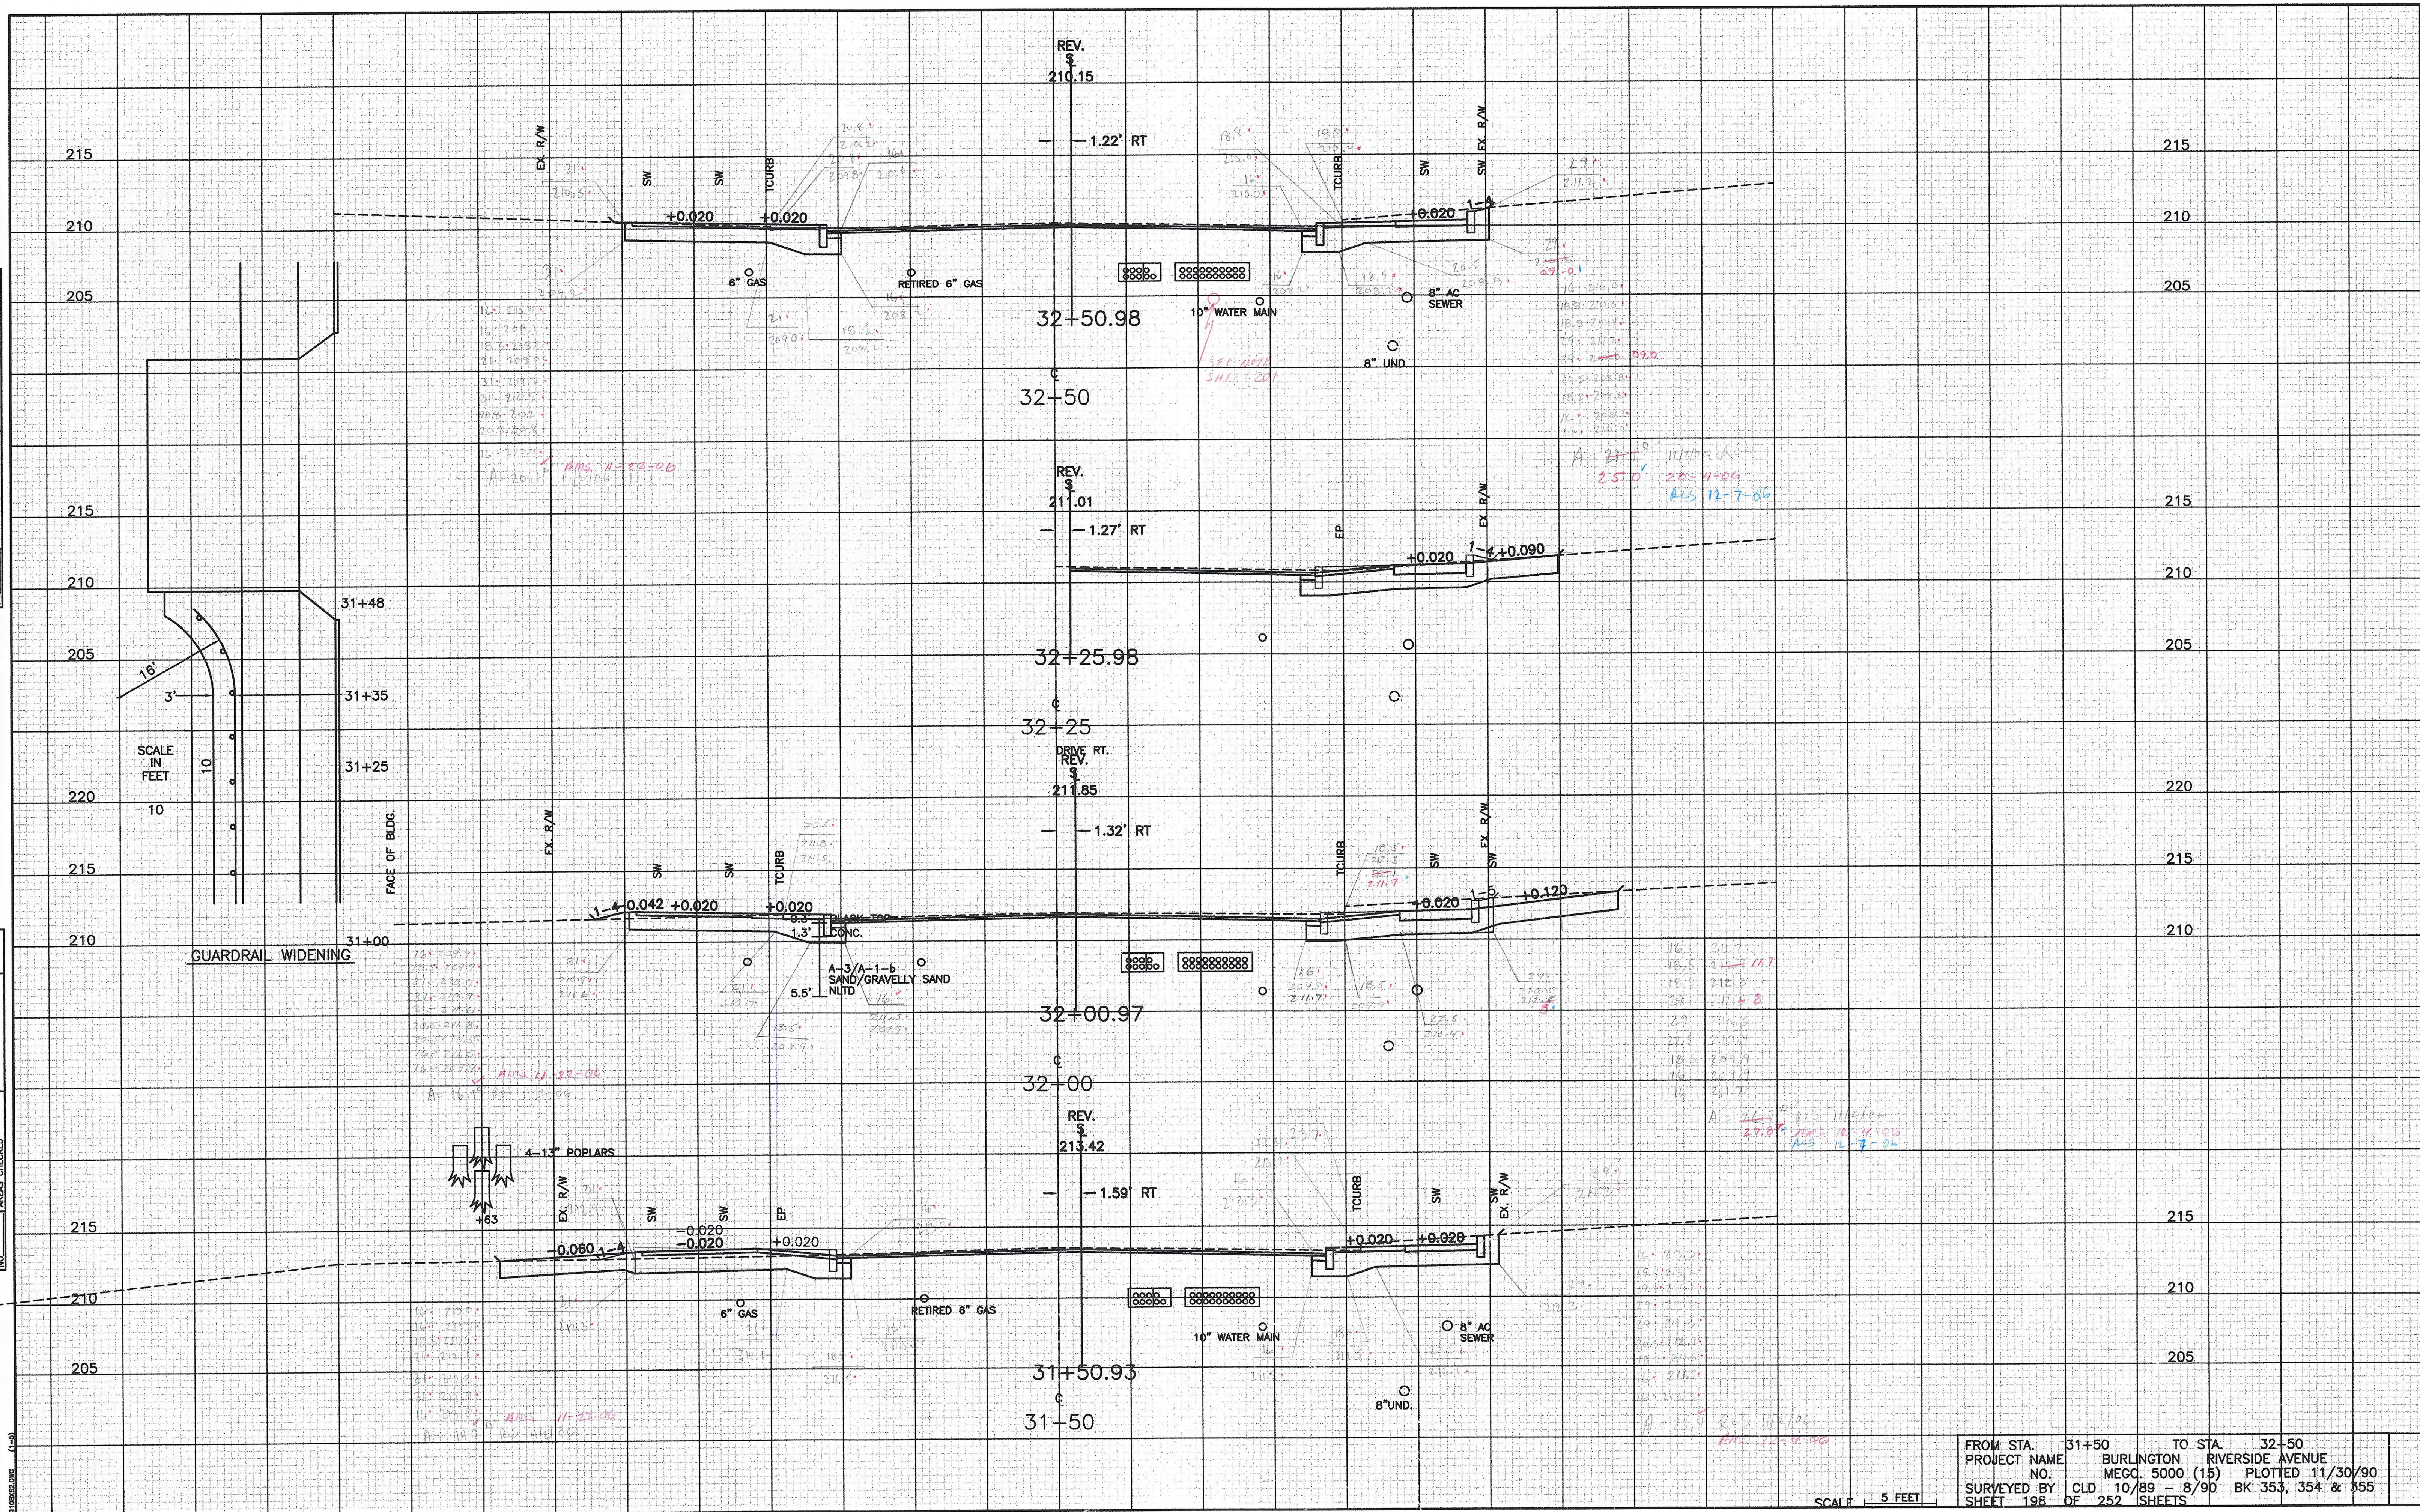

FROM STA. 31+50 TO STA. 32+50
 PROJECT NAME BURLINGTON RIVERSIDE AVENUE
 NO. MEGC. 5000 (15) PLOTTED 11/30/90
 SURVEYED BY CLD 10/89 - 8/90 BK 353, 354 & 355
 SHEET 198 OF 252 SHEETS

SCALE 5 FEET