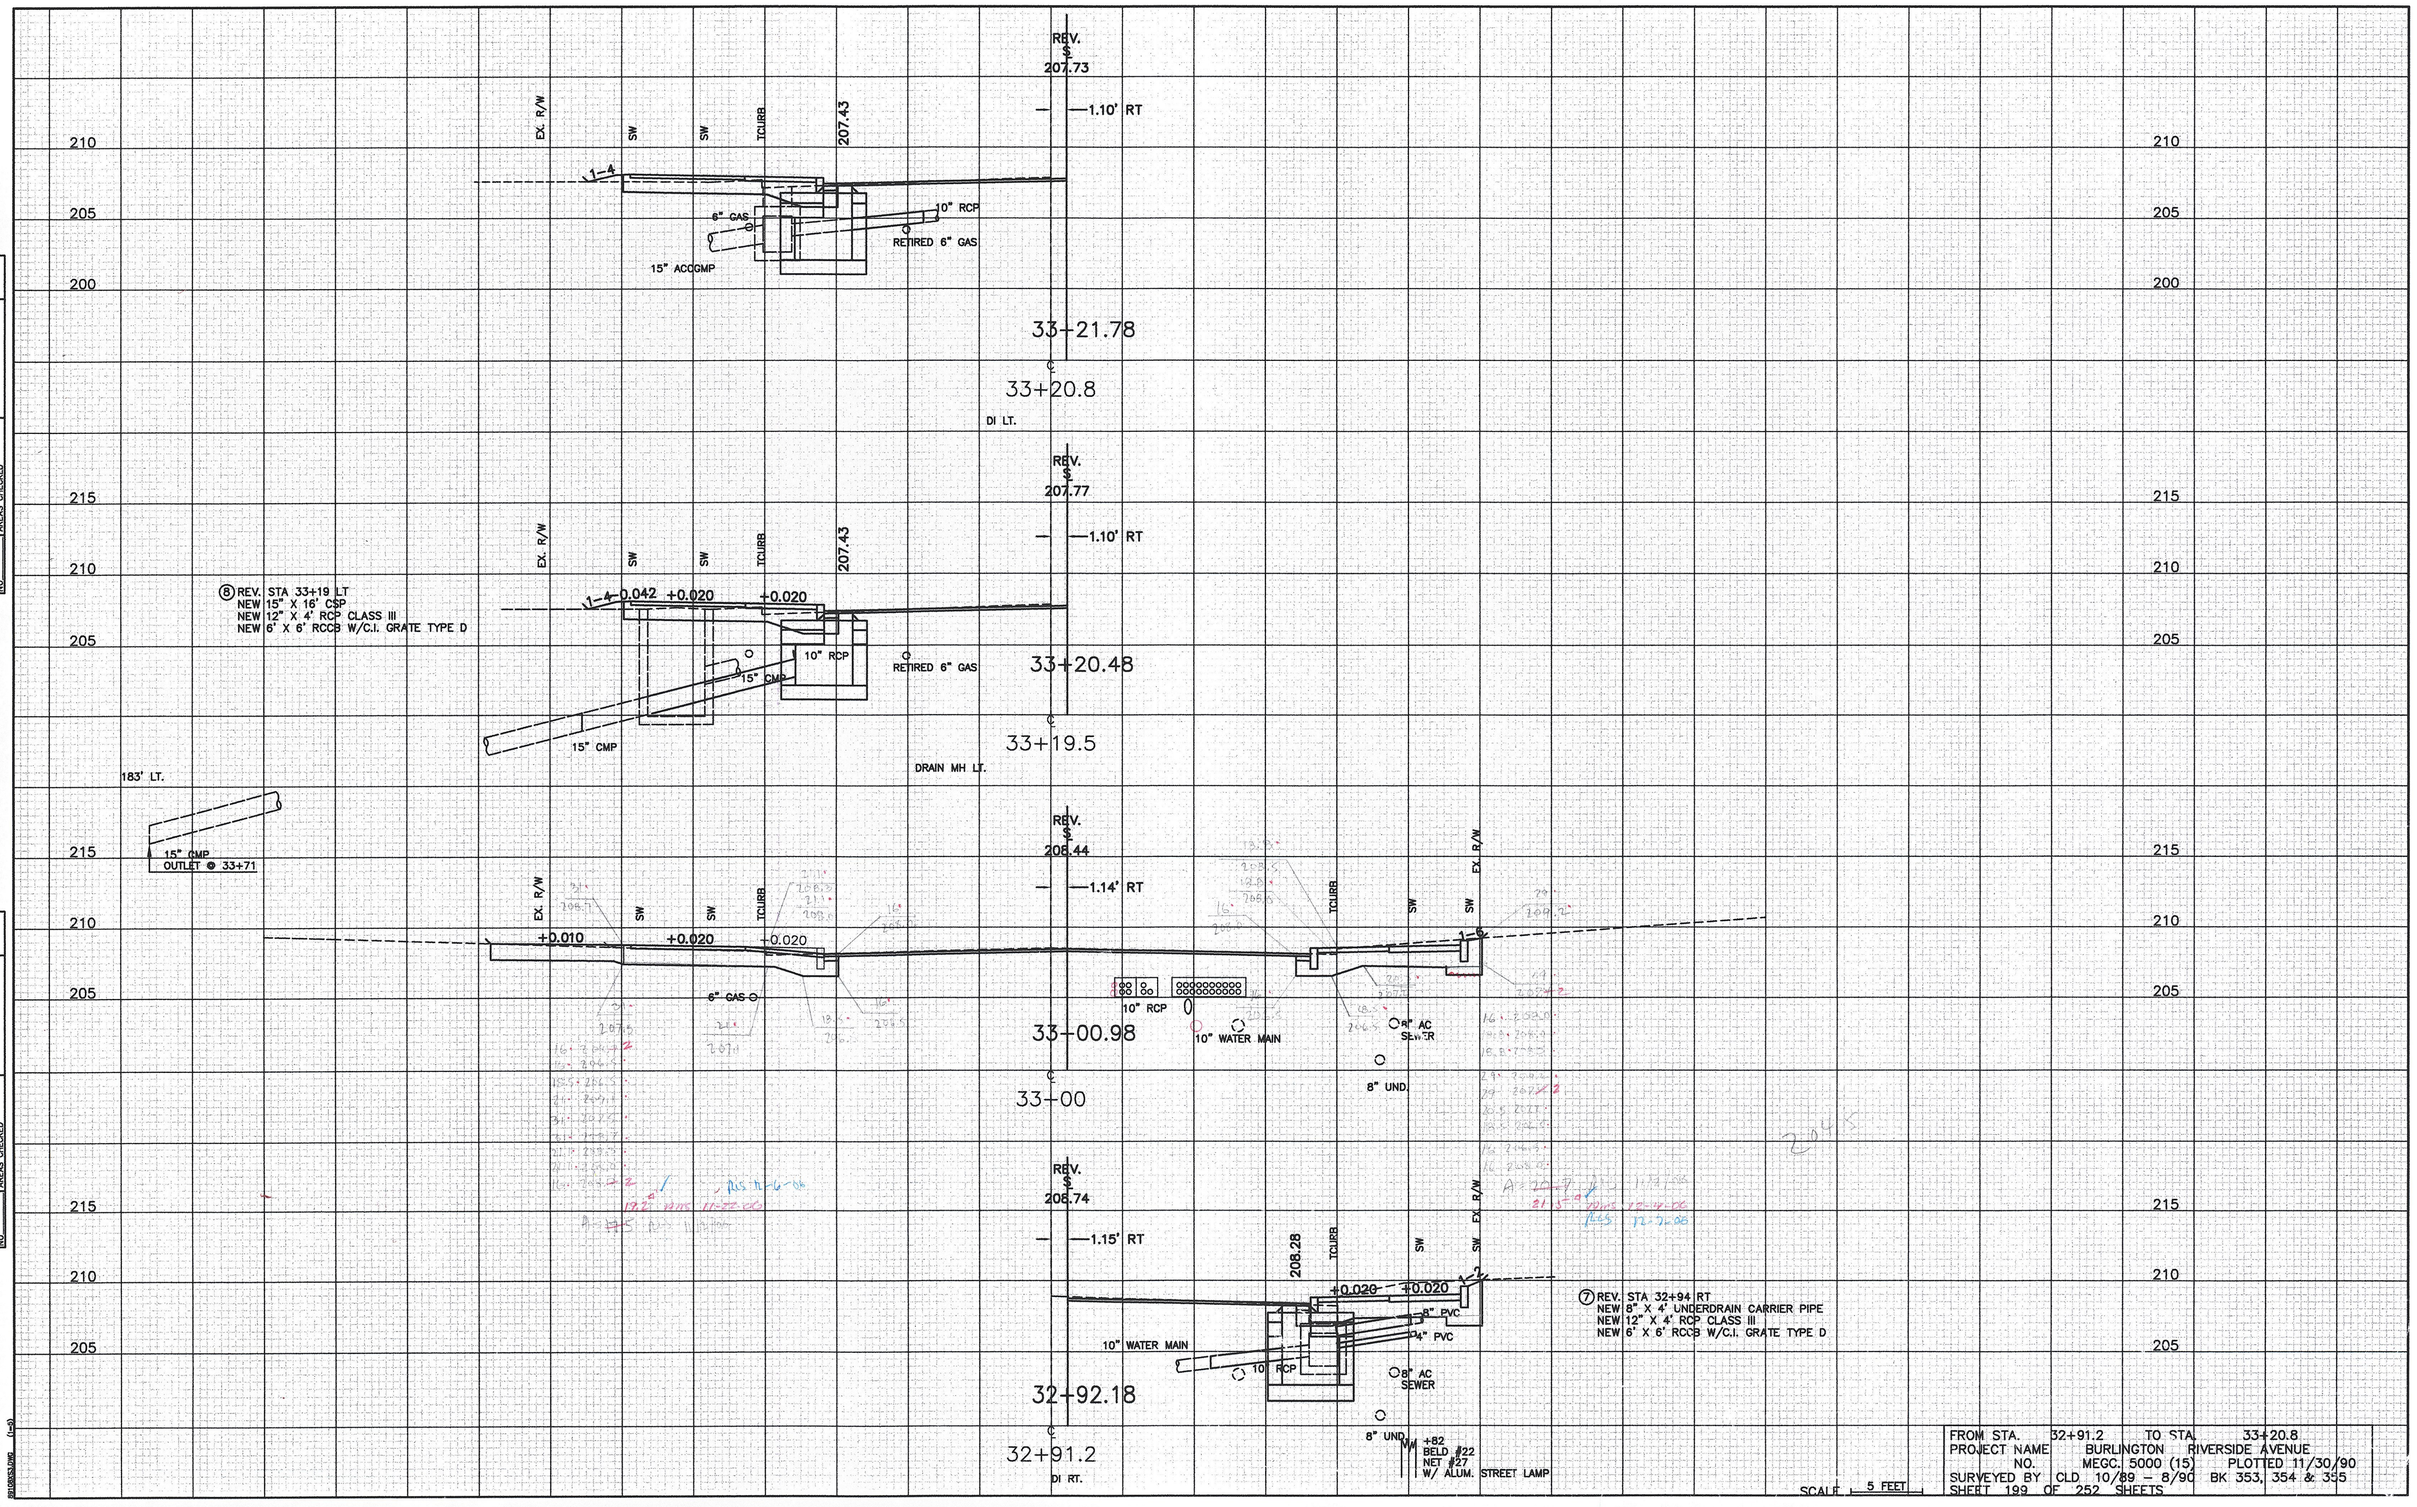
REV.
207.73
1.10' RT
EX. R/W
SW
SW
TCURB
207.43
1-4
6" GAS
10" RCP
RETIRED 6" GAS
15" ACCGMP
33+21.78
33+20.8
DI LT.
REV.
207.77
1.10' RT
EX. R/W
SW
SW
TCURB
207.43
1-4
0.042
+0.020
+0.020
8 REV. STA 33+19 LT
NEW 15" X 16' CSP
NEW 12" X 4' RCP CLASS III
NEW 6' X 6' RCCB W/C.I. GRATE TYPE D
10" RCP
15" CMP
RETIRED 6" GAS
33+20.48
15" CMP
33+19.5
DRAIN MH LT.
183' LT.
15" CMP
OUTLET @ 33+71
REV.
208.44
1.14' RT
EX. R/W
SW
SW
TCURB
+0.010
+0.020
+0.020
6" GAS
10" RCP
10" WATER MAIN
8" AC SEWER
8" UND.
33+00.98
33+00
REV.
208.74
1.15' RT
208.28
TCURB
SW
SW
EX. R/W
+0.020
+0.020
8" PVC
4" PVC
7 REV. STA 32+94 RT
NEW 8" X 4' UNDERDRAIN CARRIER PIPE
NEW 12" X 4' RCP CLASS III
NEW 6' X 6' RCCB W/C.I. GRATE TYPE D
10" WATER MAIN
10" RCP
8" AC SEWER
32+92.18
8" UND.
WM +82
BELD #22
NET #27
W/ ALUM. STREET LAMP
32+91.2
DI RT.
SCALE 5 FEET
FROM STA. 32+91.2 TO STA. 33+20.8
PROJECT NAME BURLINGTON RIVERSIDE AVENUE
NO. MEGC. 5000 (15) PLOTTED 11/30/90
SURVEYED BY CLD 10/89 – 8/90 BK 353, 354 & 355
SHEET 199 OF 252 SHEETS
FINAL SURVEY
NOTEBOOK
NO.
SURVEYED
PLOTTED
TEMPLATE
AREAS
AREAS CHECKED
BY
DATE
ORIGINAL SURVEY
NOTEBOOK
NO.
SURVEYED
PLOTTED
TEMPLATE
AREAS
AREAS CHECKED
BY
DATE