FINAL SURVEY	BY	DATE
SURVEYED		
PLOTTED		
TRAVERSE		
NOTEBOOK AREAS		
NO. AREAS CHECKED		

ORIGINAL SURVEY	BY	DATE
SURVEYED		
PLOTTED		
TRAVERSE		
NOTEBOOK AREAS		
NO. AREAS CHECKED		

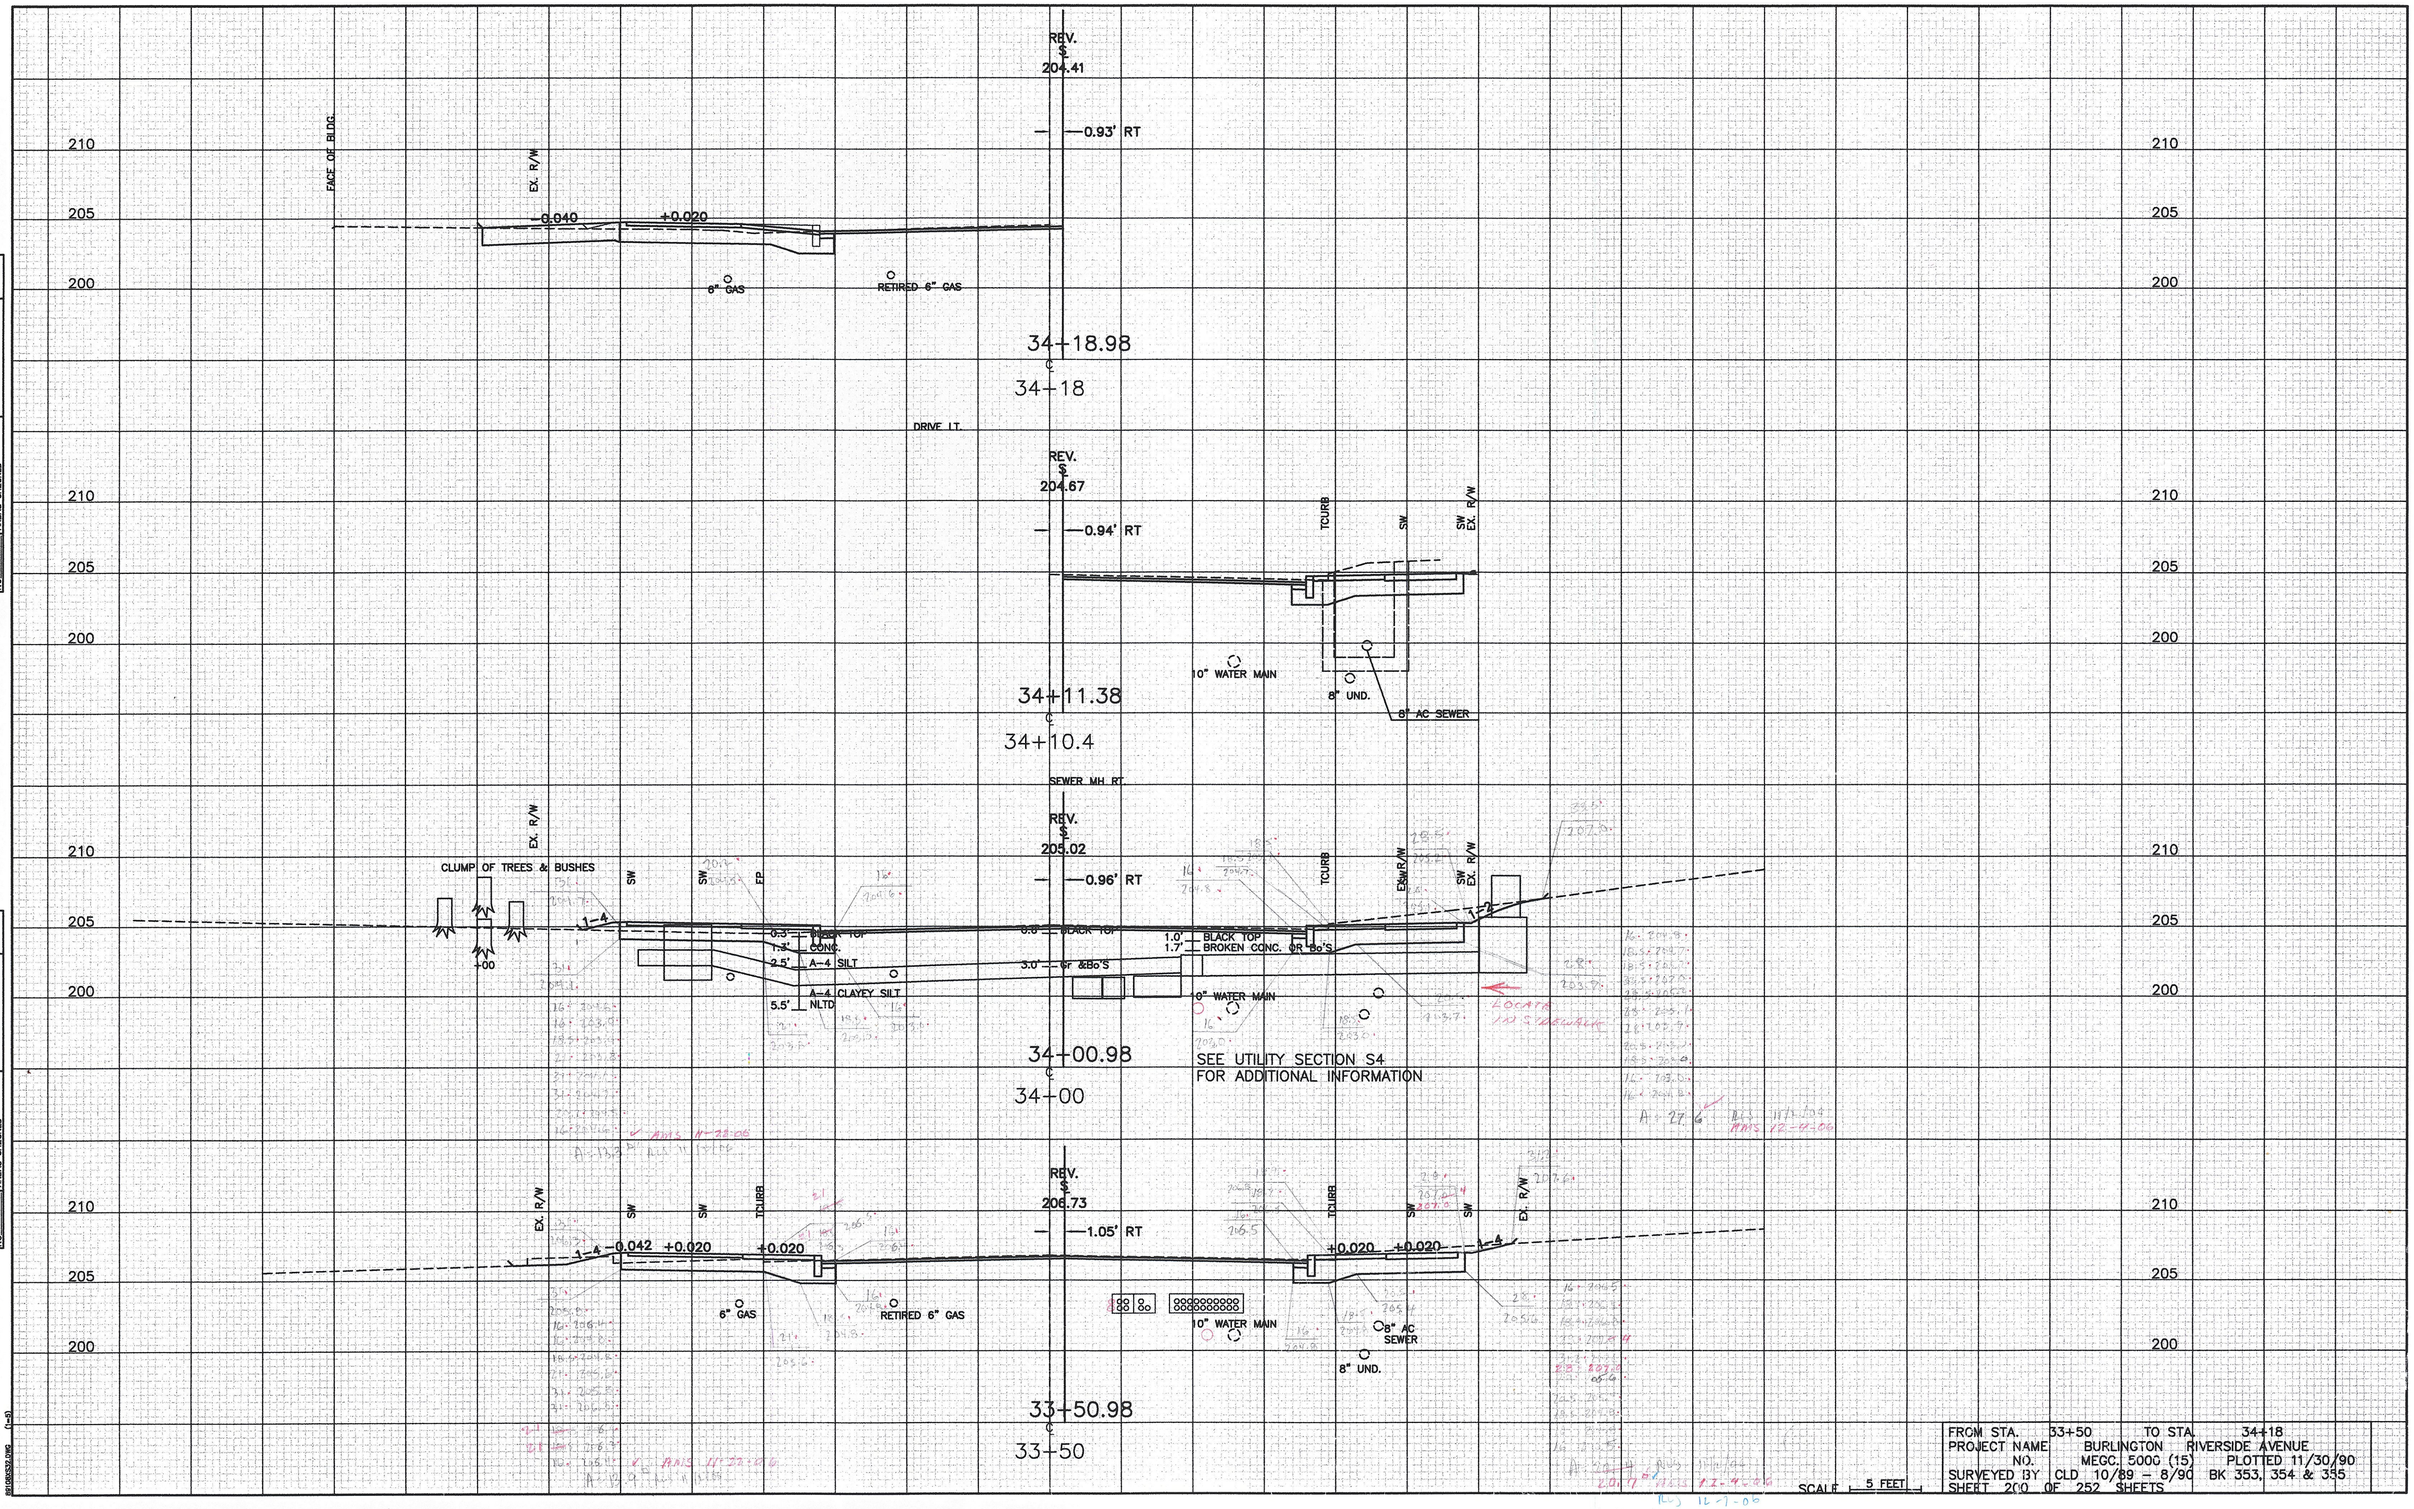

FROM STA. 33+50 TO STA. 34+18
PROJECT NAME BURLINGTON RIVERSIDE AVENUE
NO. MEGC. 5000 (15) PLOTTED 11/30/90
SURVEYED BY CLD 10/89 – 8/90 BK 353, 354 & 355
SHEET 200 OF 252 SHEETS

SCALE 5 FEET