


DATE	
BY	
FINAL SURVEY PLOTTED	
NOTEBOOK NO.	
AREAS CHECKED	

DATE	
BY	
ORIGINAL SURVEY PLOTTED	
NOTEBOOK NO.	
AREAS CHECKED	

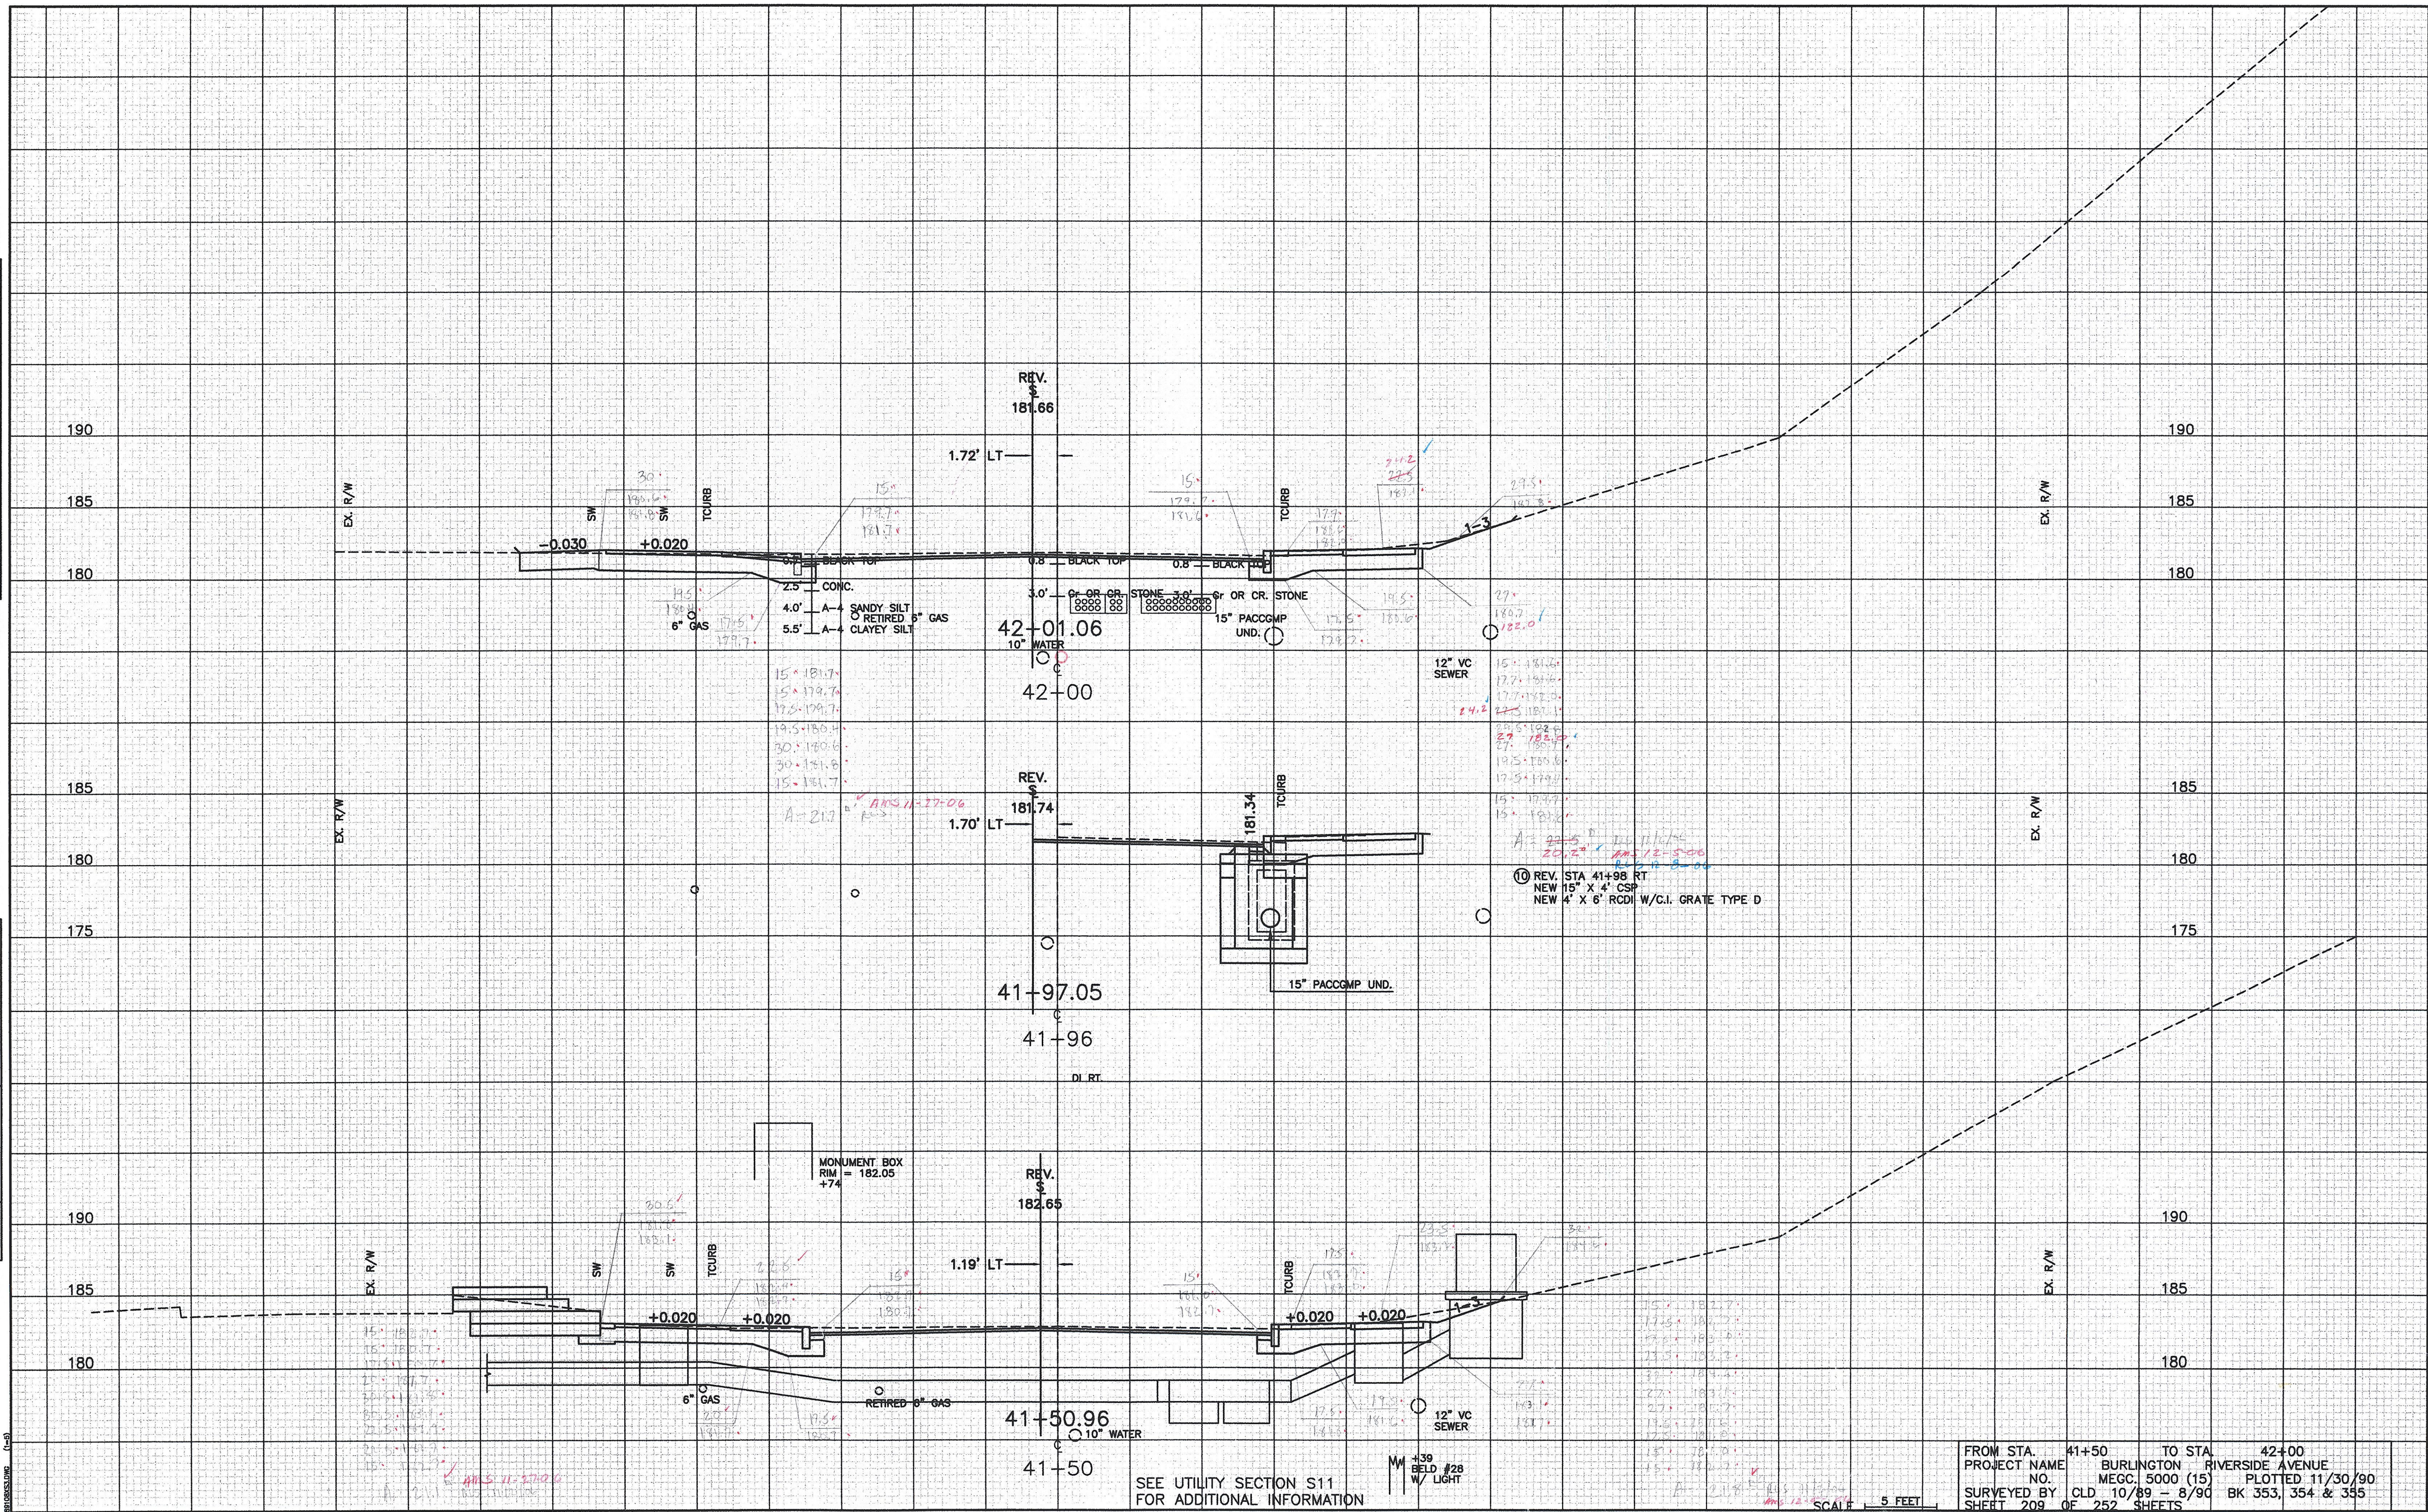

REVISIONS

SEE UTILITY SECTION S11 FOR ADDITIONAL INFORMATION

MM +39 BELD #28 W/LIGHT

SCALE 5 FEET

FROM STA.	41+50	TO STA.	42+00
PROJECT NAME	BURLINGTON	RIVERSIDE AVENUE	
NO.	MECC 5000 (15)	PLOTTED	11/30/90
SURVEYED BY	CLD 10/89 - 8/90	BK 353, 354 & 355	
SHEET	209	OF	252 SHEETS