


DATE	
BY	
FINAL SURVEY NO.	
SURVEYED	
PLOTTED	
TEMPLATE	
AREAS CHECKED	

DATE	
BY	
ORIGINAL SURVEY NO.	
SURVEYED	
PLOTTED	
TEMPLATE	
AREAS CHECKED	

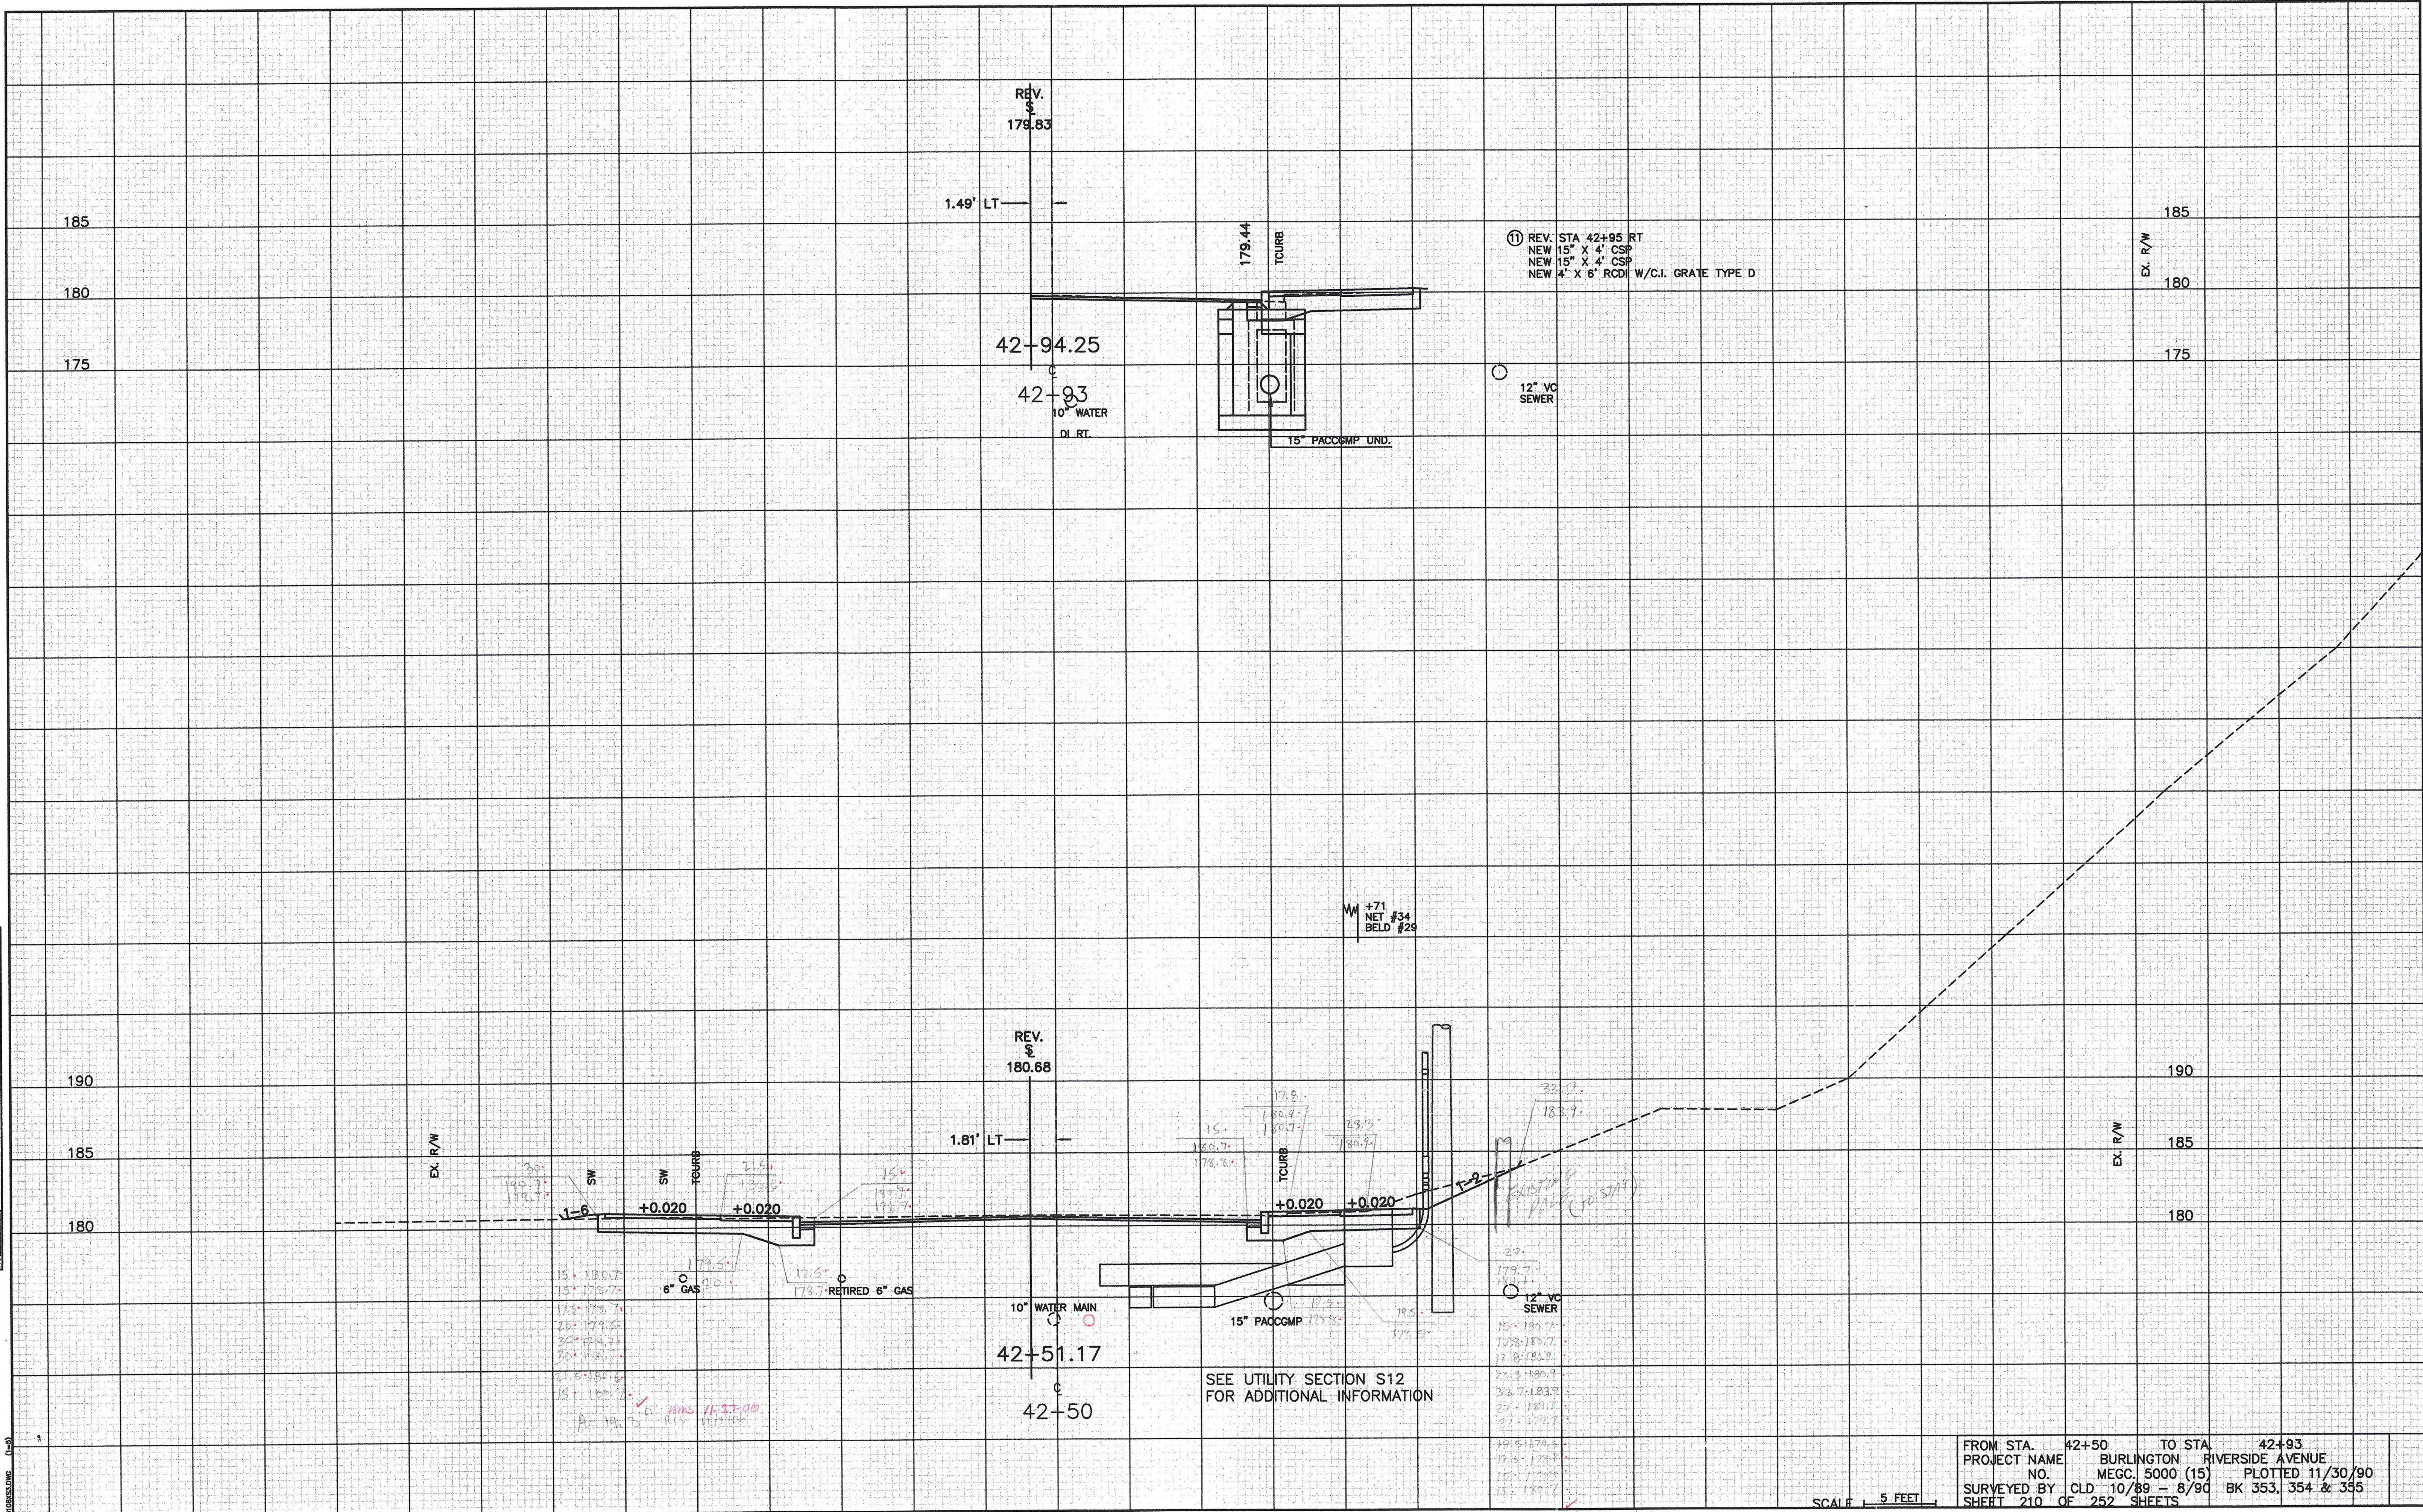

BURLINGTON

FROM STA. 42+50 TO STA. 42+93
 PROJECT NAME BURLINGTON RIVERSIDE AVENUE
 NO. MEGC. 5000 (15) PLOTTED 11/30/90
 SURVEYED BY CLD 10/89 - 8/90 BK 353, 354 & 355
 SHEET 210 OF 252 SHEETS

SCALE 5 FEET

A 22.5' 11.37.00
 AMS 12-5-00