FINAL SURVEY		BY	DATE
NOTEBOOK	SURVEYED		
	PLOTTED		
	TEMPLATE		
	AREAS		
NO.	AREAS CHECKED		

ORIGINAL SURVEY		BY	DATE
NOTEBOOK	SURVEYED		
	PLOTTED		
	TEMPLATE		
	AREAS		
NO.	AREAS CHECKED		

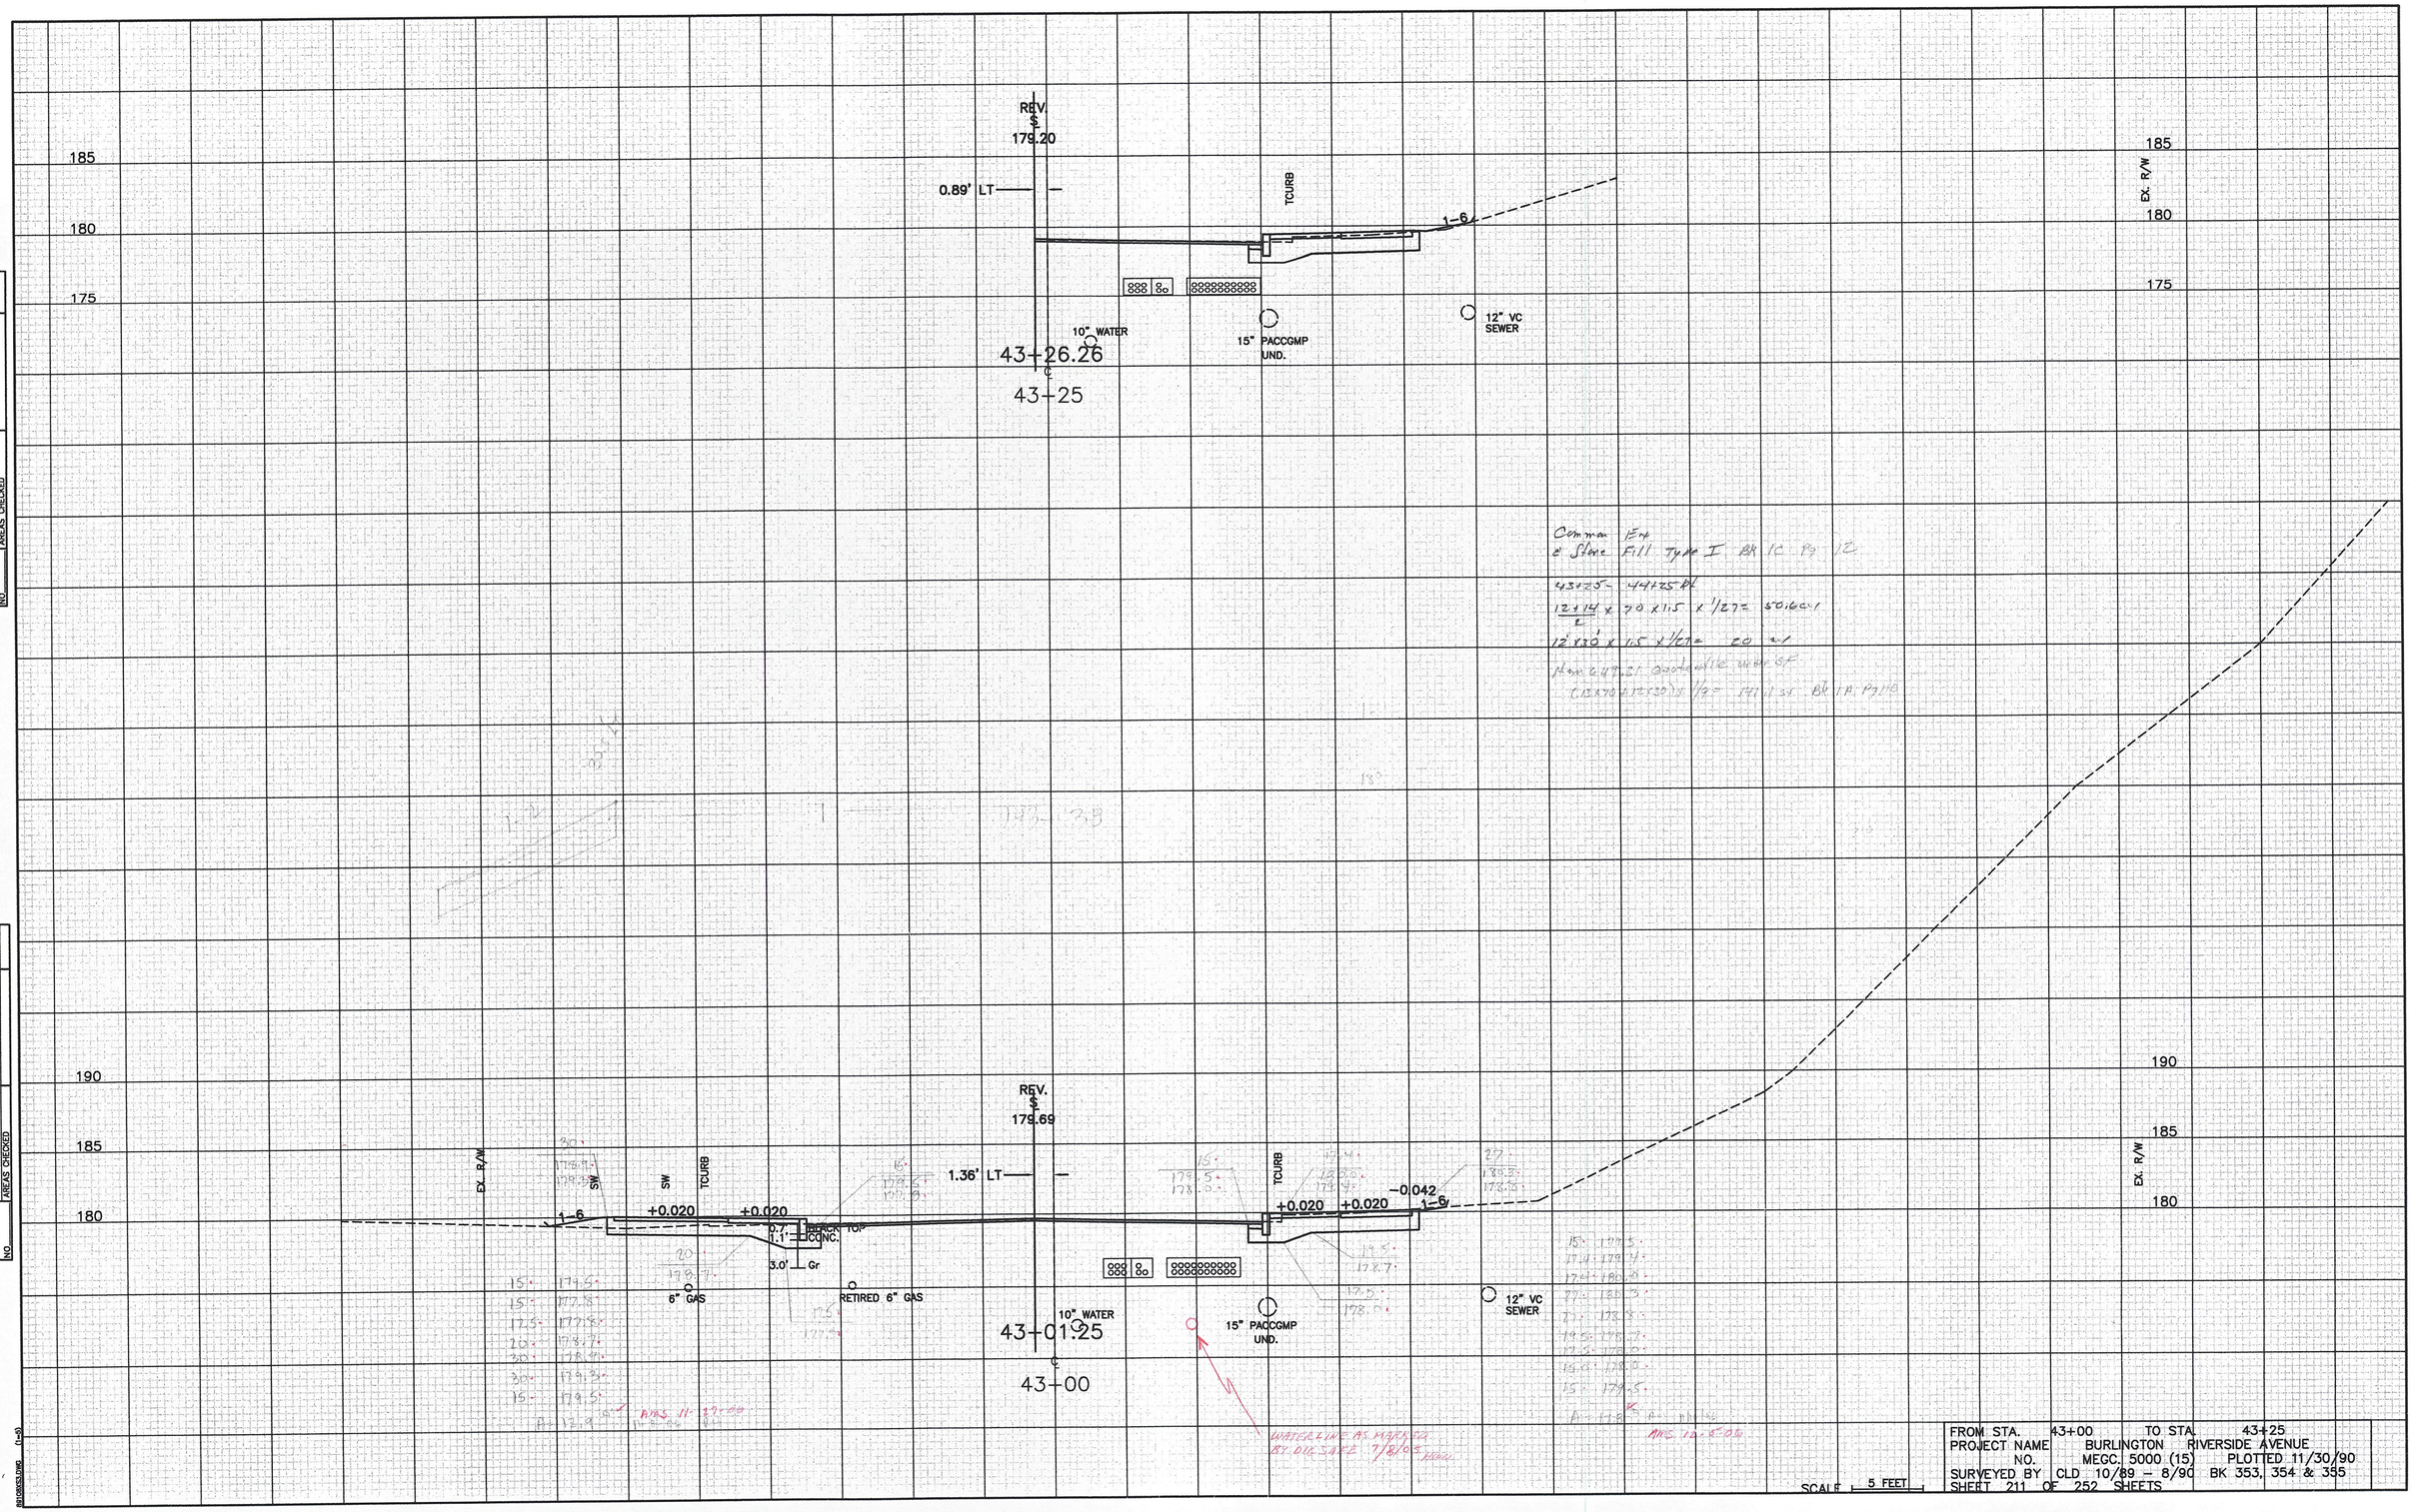

FROM STA. 43+00 TO STA. 43+25
PROJECT NAME BURLINGTON RIVERSIDE AVENUE
NO. MEGC. 5000 (15) PLOTTED 11/30/90
SURVEYED BY CLD 10/89 – 8/90 BK 353, 354 & 355
SHEET 211 OF 252 SHEETS

SCALE 5 FEET