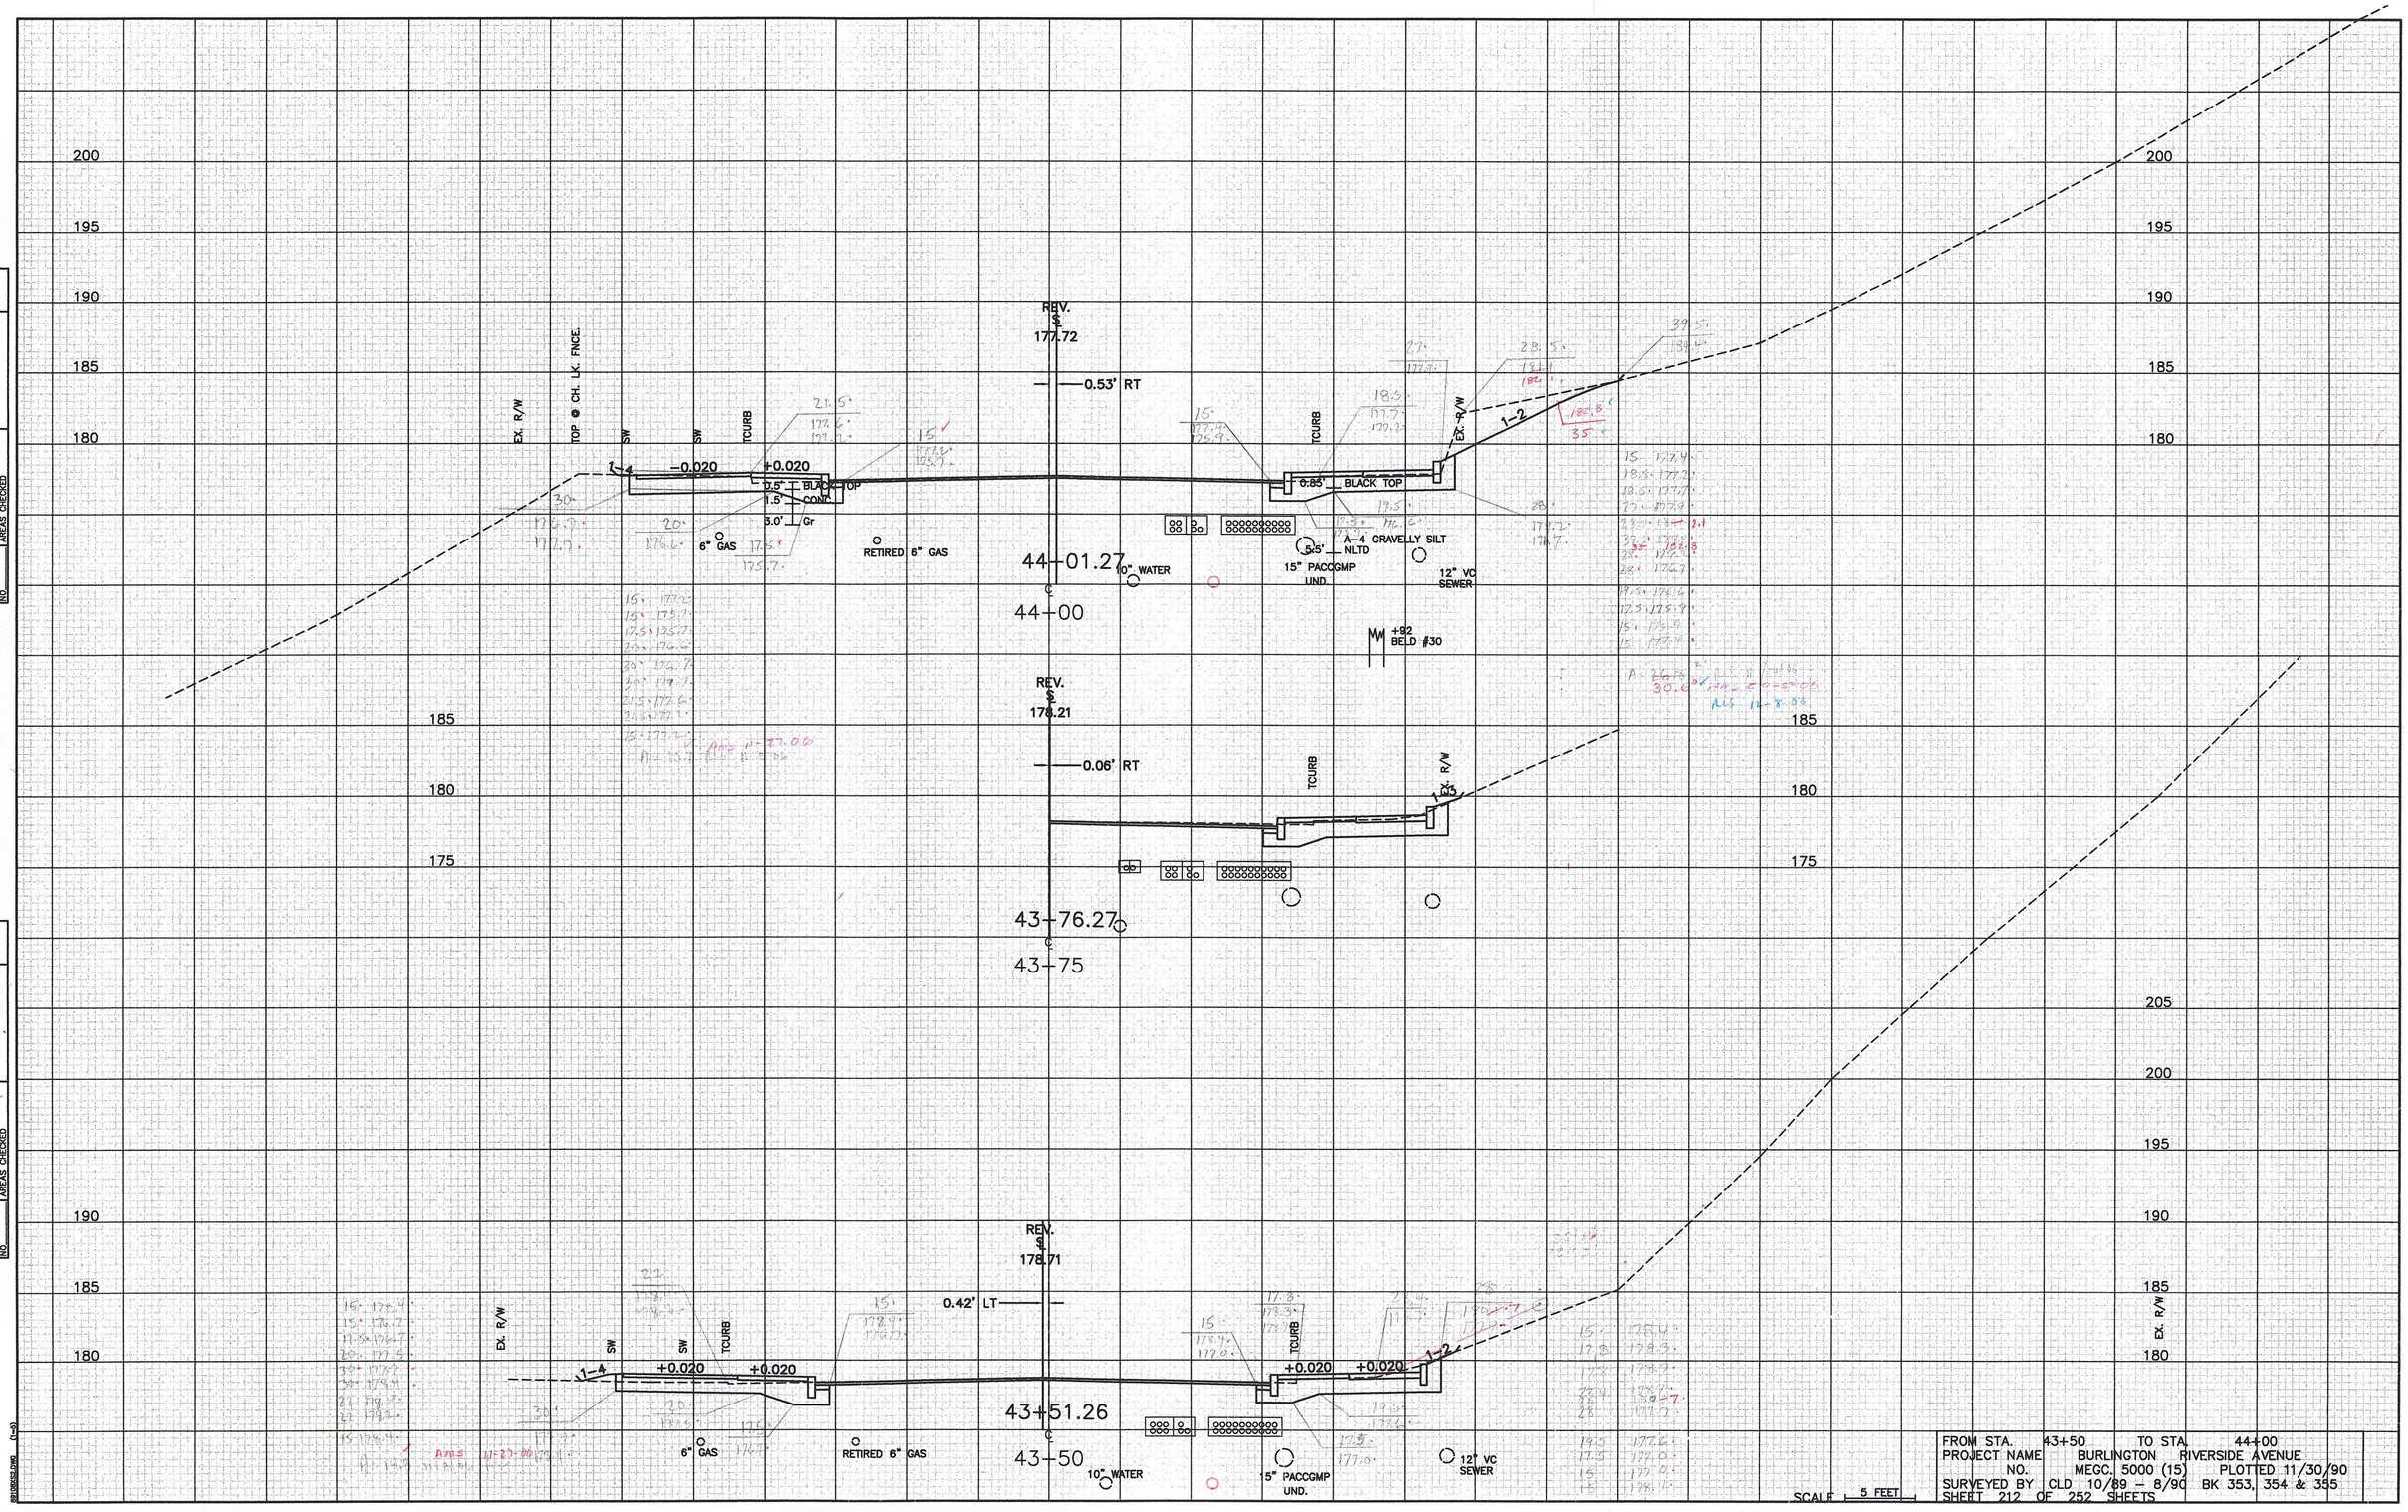

FROM STA. 43+50	TO STA. 44+00
PROJECT NAME BURLINGTON RIVERSIDE AVENUE	
NO. MEGC. 5000 (15)	PLOTTED 11/30/90
SURVEYED BY CLD 10/89 – 8/90	BK 353, 354 & 355
SHEET 212 OF 252 SHEETS	

FINAL SURVEY	SURVEYED	BY	DATE
	PLOTTED		
	PLAN-PLATE		
NOTEBOOK	AREAS		
NO.	AREAS CHECKED		

ORIGINAL SURVEY	SURVEYED	BY	DATE
	PLOTTED		
	PLAN-PLATE		
NOTEBOOK	AREAS		
NO.	AREAS CHECKED		

19'6" NMS 12-5-00
RLS 12-8-00