


FINAL SURVEY NO.	
SURVEYED BY	
PLOTTED BY	
TEMPLATE NO.	
AREAS CHECKED	
DATE	

ORIGINAL SURVEY NO.	
SURVEYED BY	
PLOTTED BY	
TEMPLATE NO.	
AREAS CHECKED	
DATE	

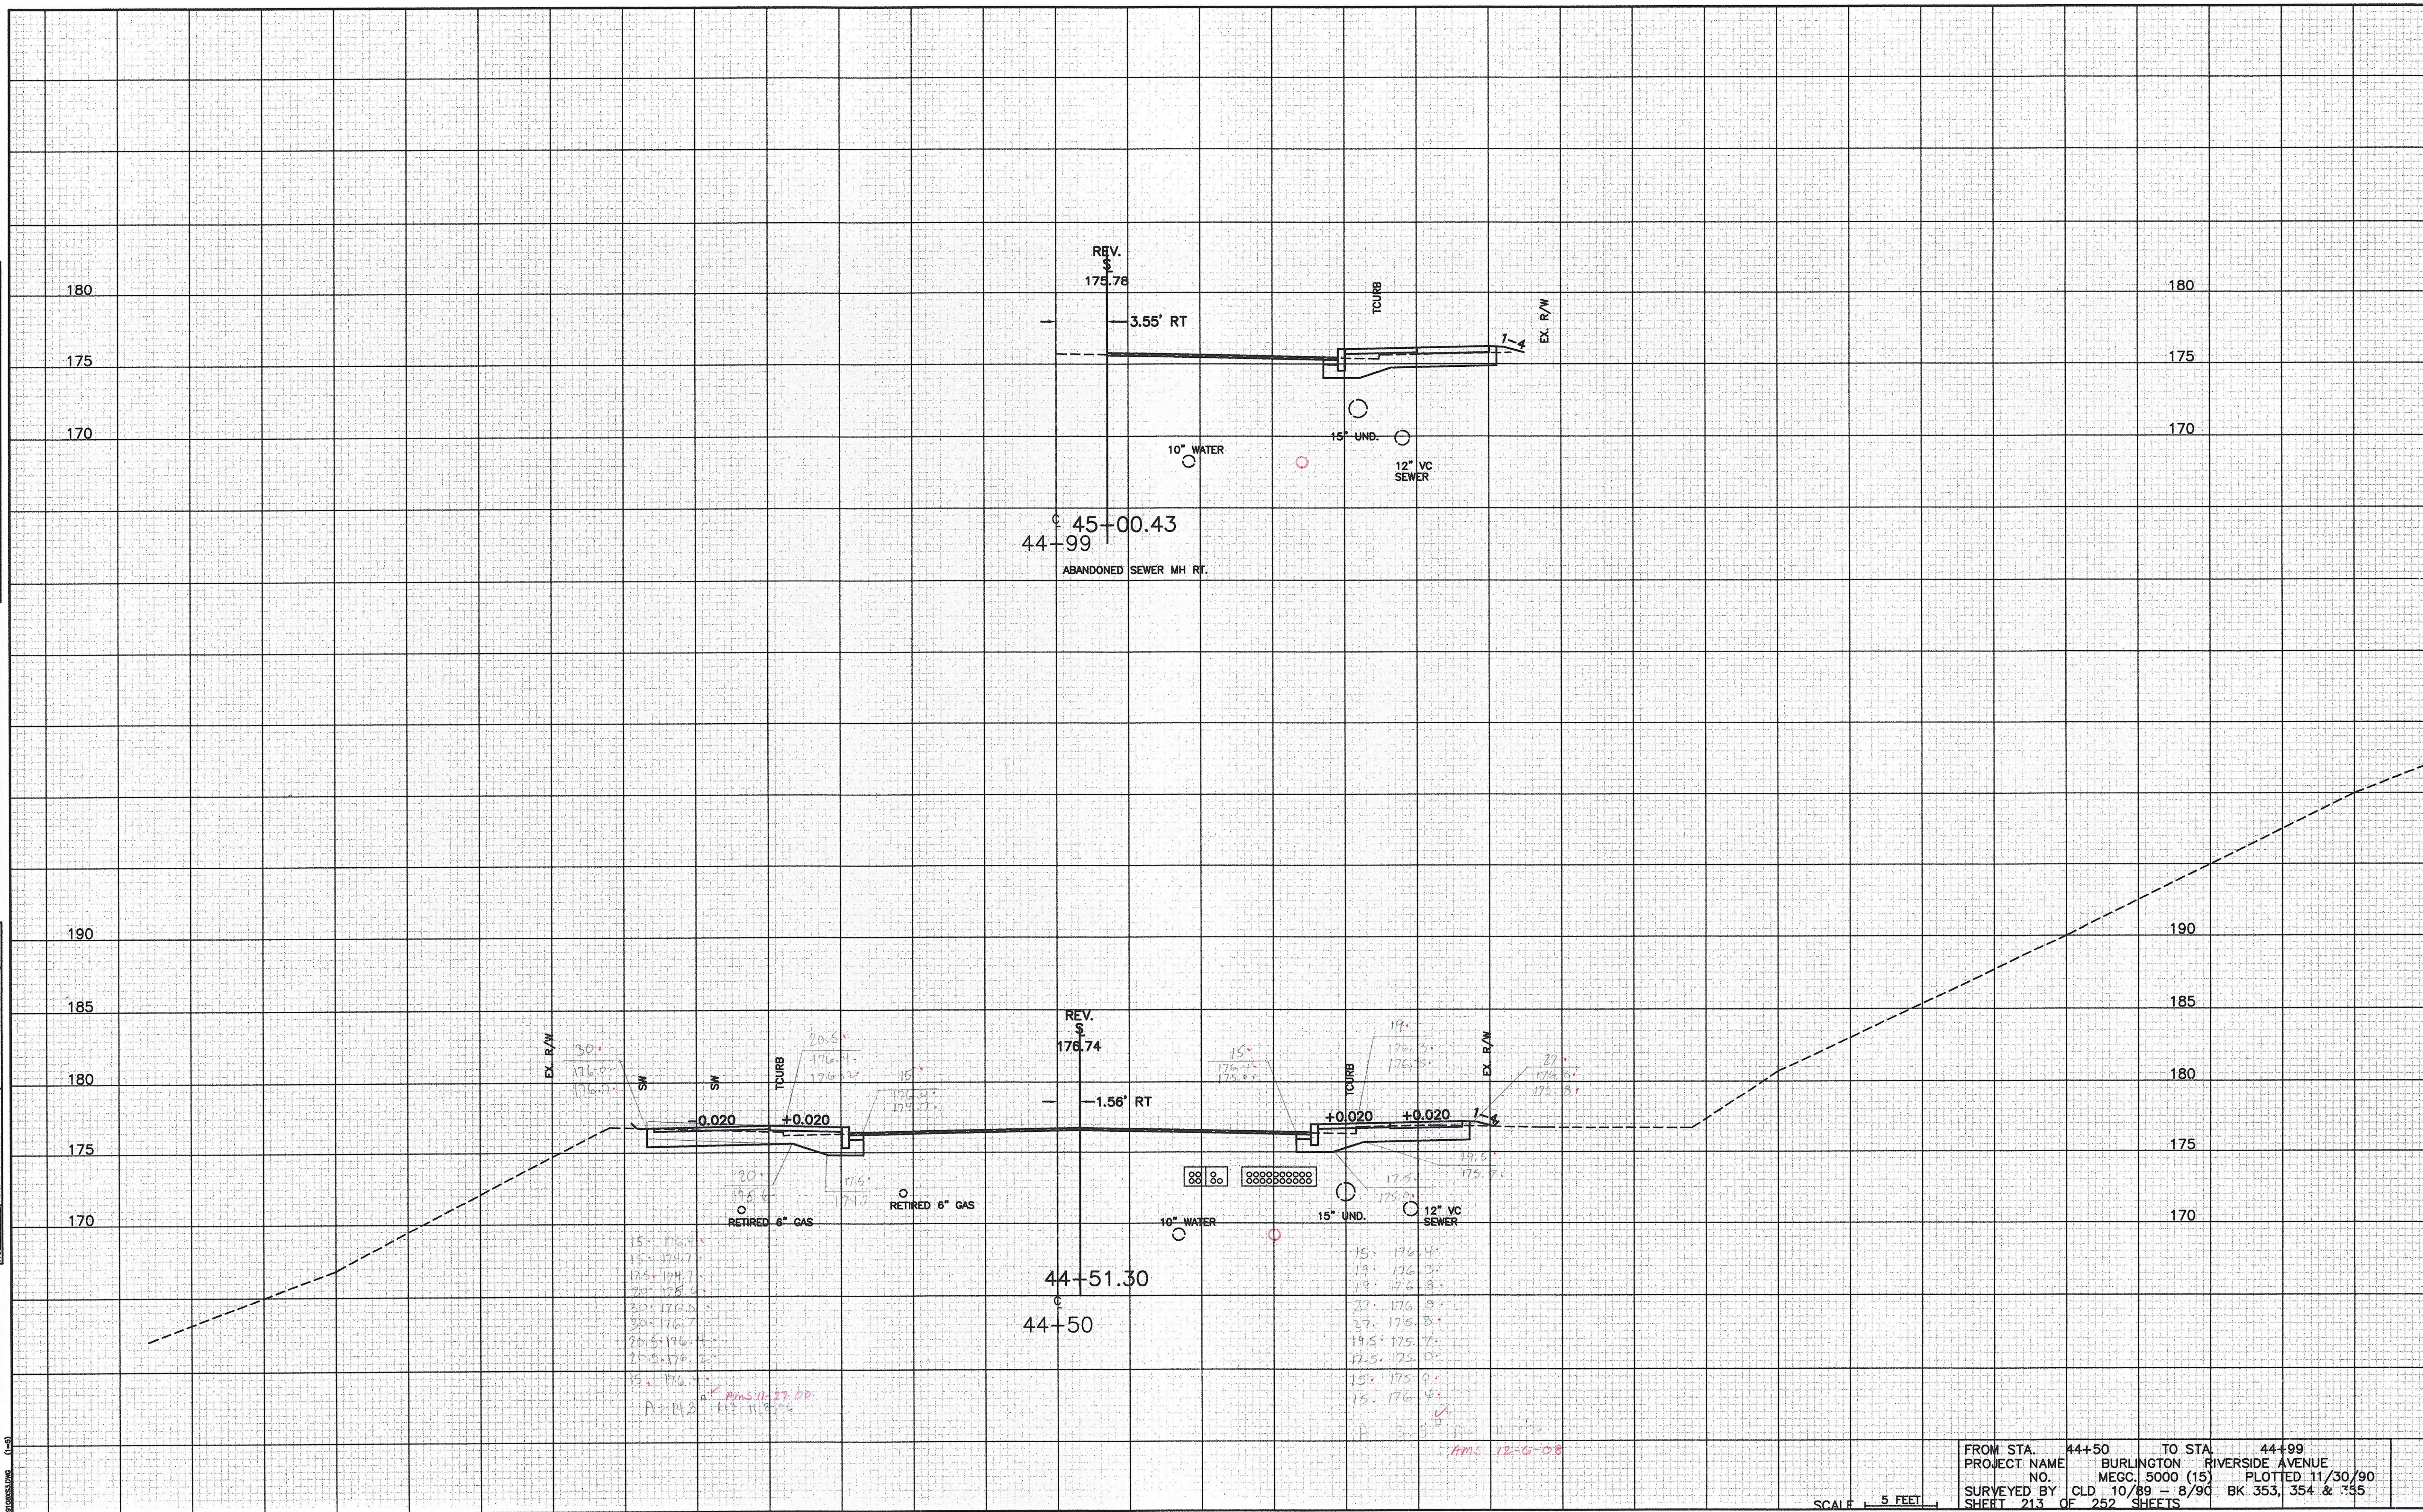

FROM STA. 44+50 TO STA. 44+99
 PROJECT NAME BURLINGTON RIVERSIDE AVENUE
 NO. MEGC. 5000 (15) PLOTTED 11/30/90
 SURVEYED BY CLD 10/89 - 8/90 BK 353, 354 & 355
 SHEET 213 OF 252 SHEETS

SCALE 1" = 5 FEET

AMS 12-6-08

8/10/2008