


|              |      |
|--------------|------|
| FINAL SURVEY | NO.  |
| SURVEYED     | DATE |
| PLOTTED      | BY   |
| TEMPLATE     |      |
| AREAS        |      |
| CHECKED      |      |

|                 |      |
|-----------------|------|
| ORIGINAL SURVEY | NO.  |
| SURVEYED        | DATE |
| PLOTTED         | BY   |
| TEMPLATE        |      |
| AREAS           |      |
| CHECKED         |      |

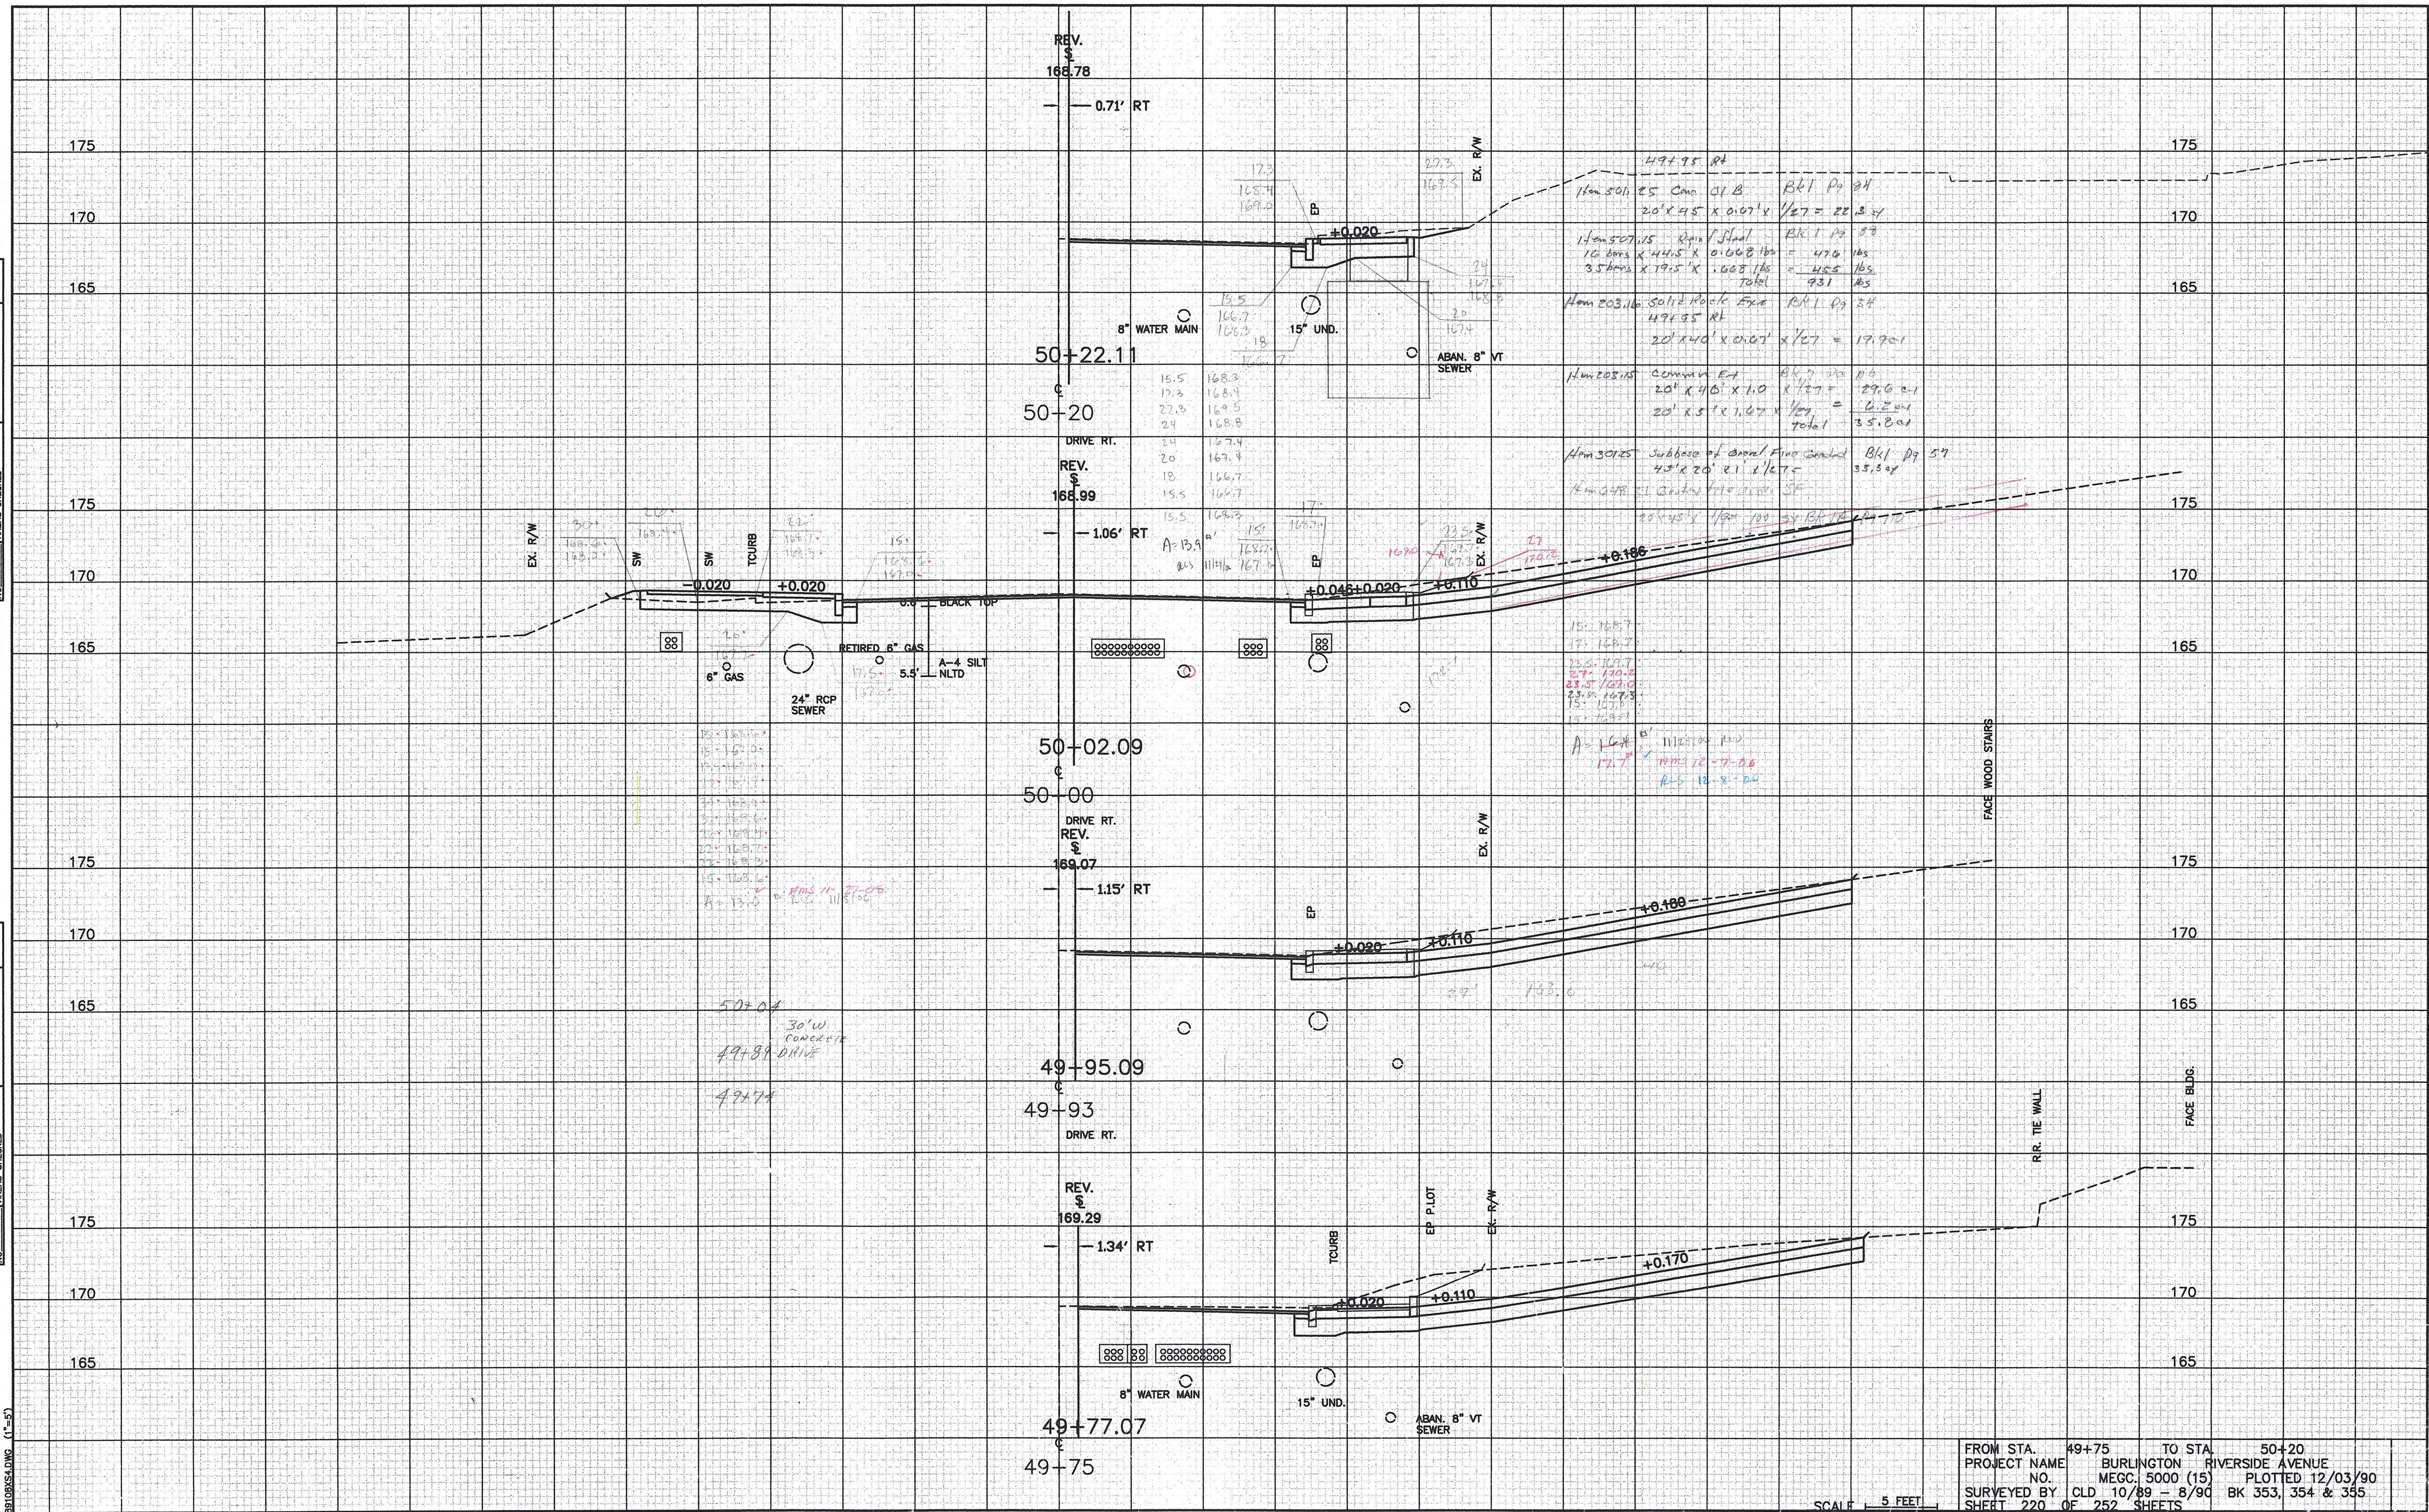

8910054.DWG (1-5)

SCALE 1/8\"/>

FROM STA. 49+75 TO STA. 50+20  
 PROJECT NAME BURLINGTON RIVERSIDE AVENUE  
 NO. MEGC. 5000 (15) PLOTTED 12/03/90  
 SURVEYED BY CLD 10/89 - 8/90 BK 353, 354 & 355  
 SHEET 220 OF 252 SHEETS