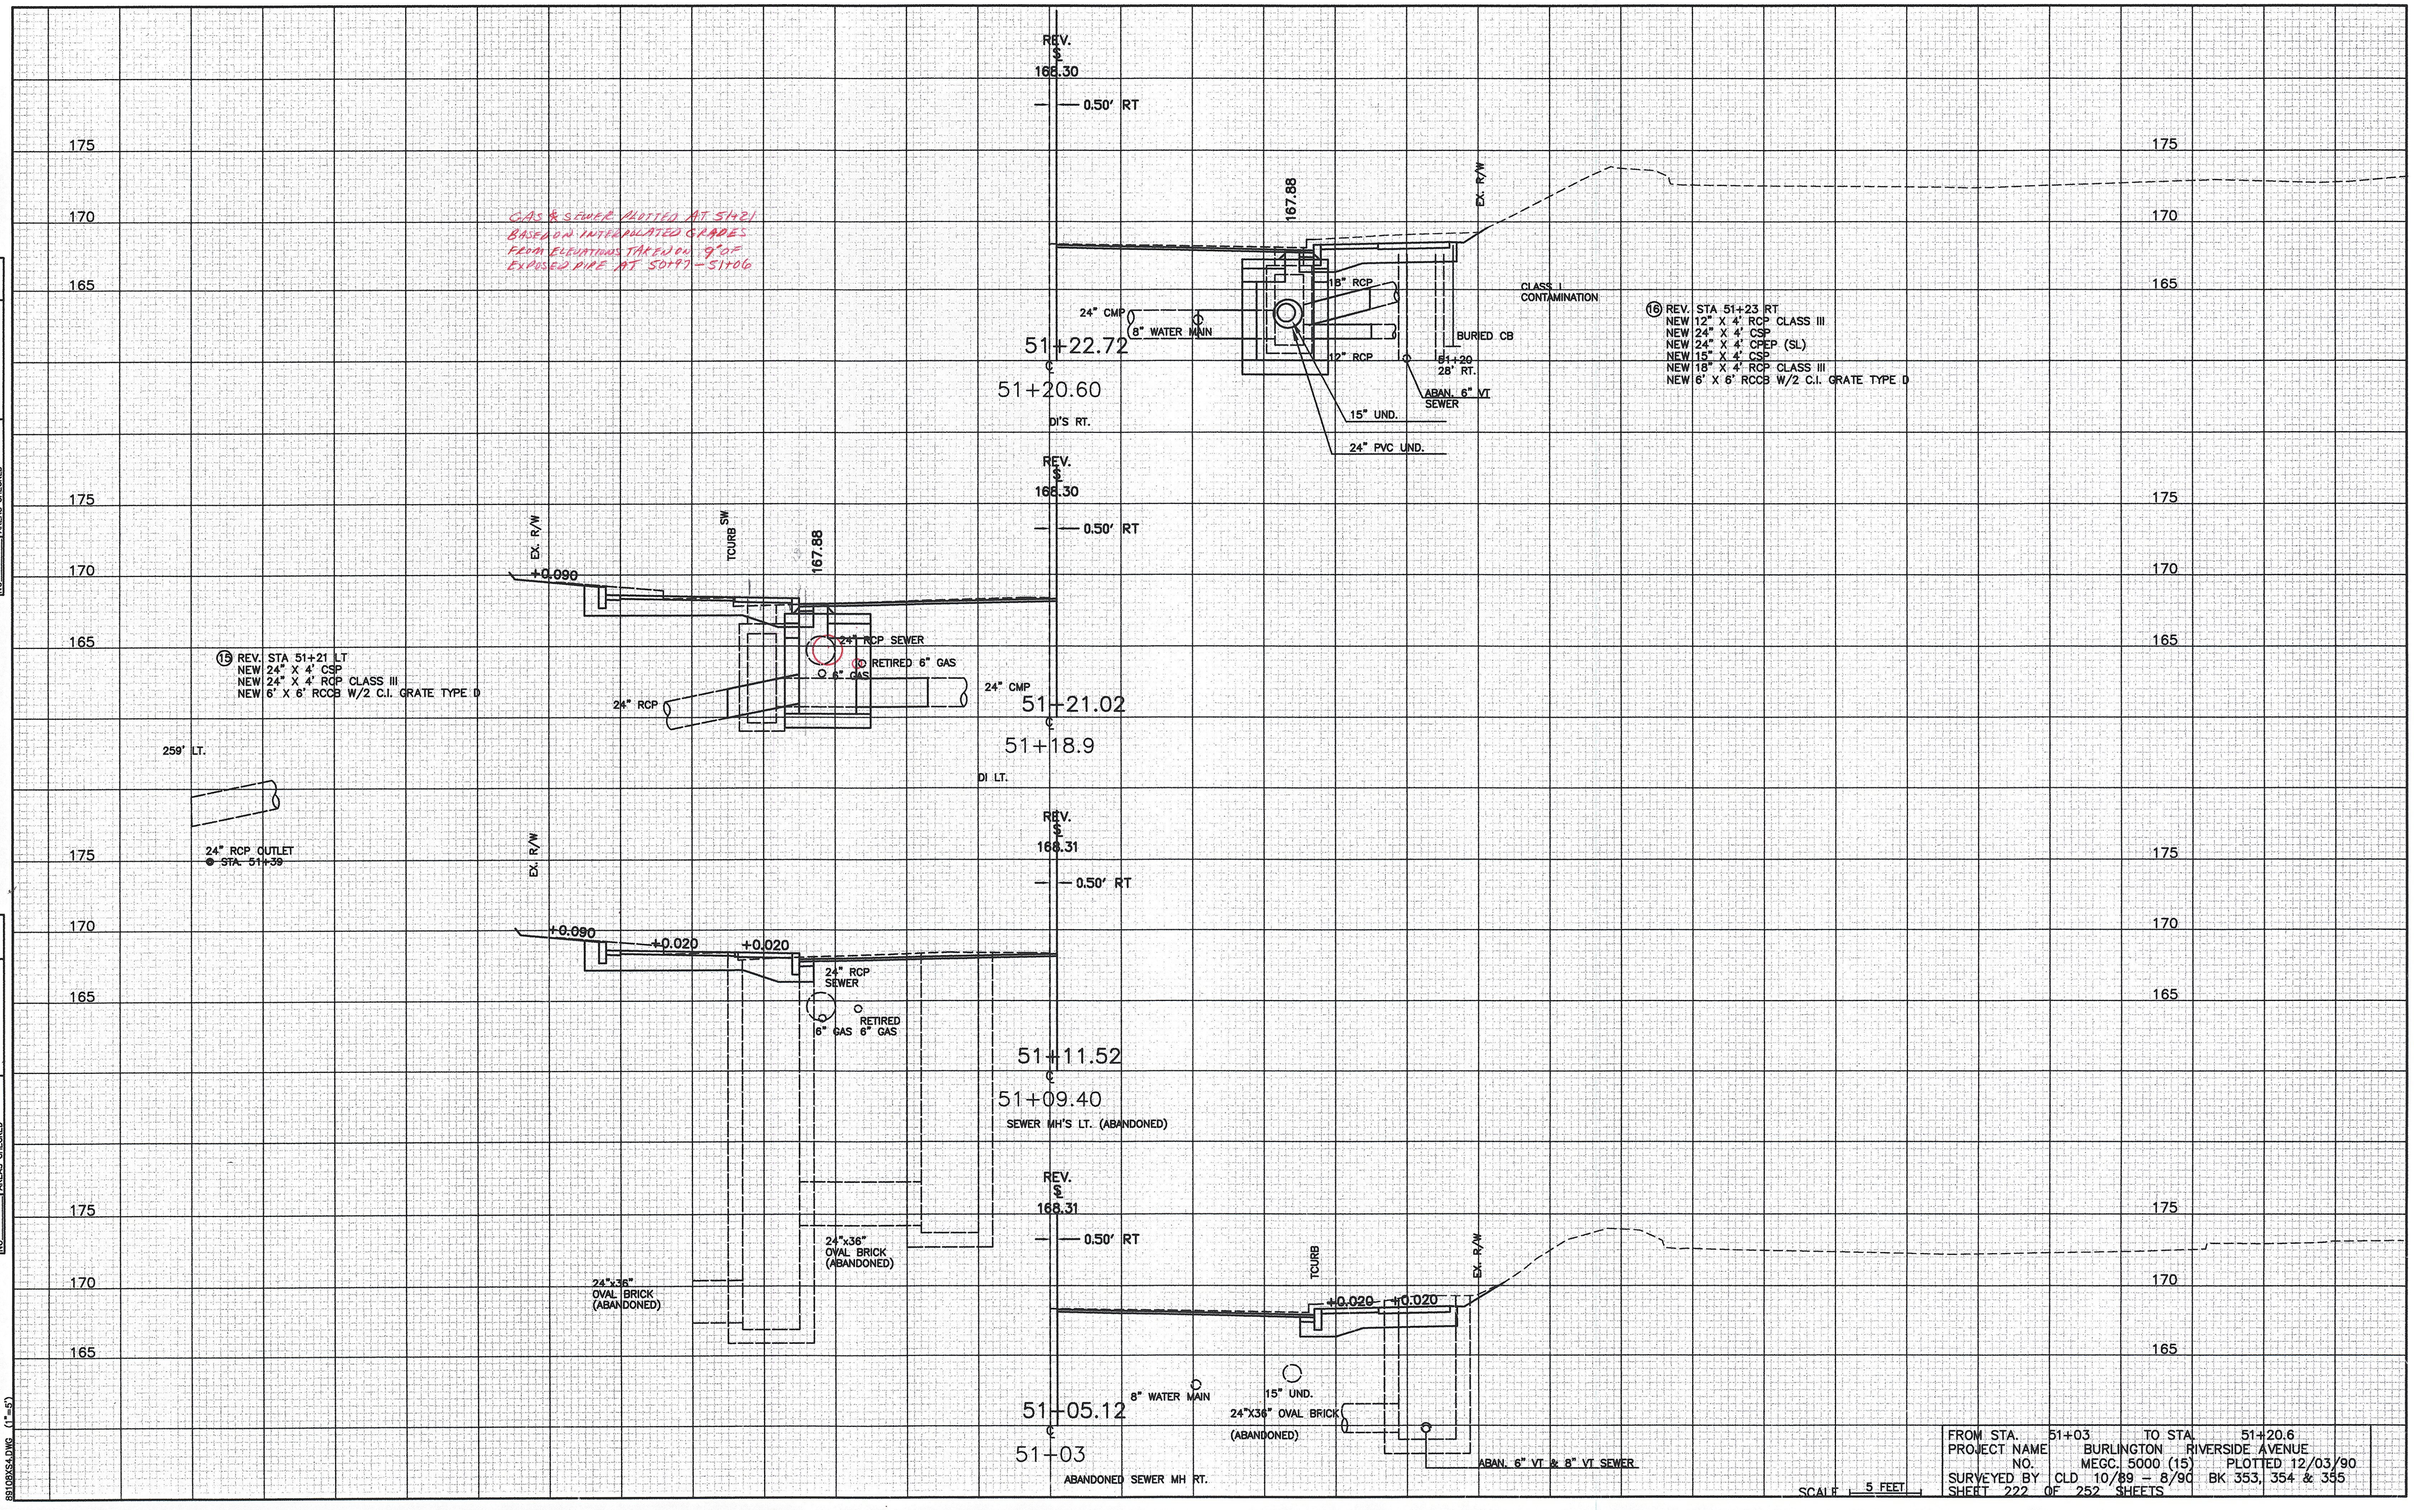


| FROM STA. 51+03 | TO STA. 51+20.6 |
|---|---|
| PROJECT NAME BURLINGTON RIVERSIDE AVENUE | |
| NO. MEGC. 5000 (15) | PLOTTED 12/03/90 |
| SURVEYED BY CLD 10/89 - 8/90 | BK 353, 354 & 355 |
| SHEET 222 OF 252 SHEETS | |

| FINAL SURVEY | | BY | DATE |
|---|---|---|---|
| NOTEBOOK | SURVEYED | | |
| NO. | PLOTTED | | |
| | TRIMLINE | | |
| | AREAS | | |
| | AREAS CHECKED | | |

| ORIGINAL SURVEY | | BY | DATE |
|---|---|---|---|
| NOTEBOOK | SURVEYED | | |
| NO. | PLOTTED | | |
| | TRIMLINE | | |
| | AREAS | | |
| | AREAS CHECKED | | |

891083S4.DWG (1"=5')