


DATE	
BY	
FINAL SURVEY NO.	
SURVEYED	
PLOTTED	
TEMPERATURE	
NOTED	
AREAS CHECKED	

DATE	
BY	
ORIGINAL SURVEY NO.	
SURVEYED	
PLOTTED	
TEMPERATURE	
NOTED	
AREAS CHECKED	

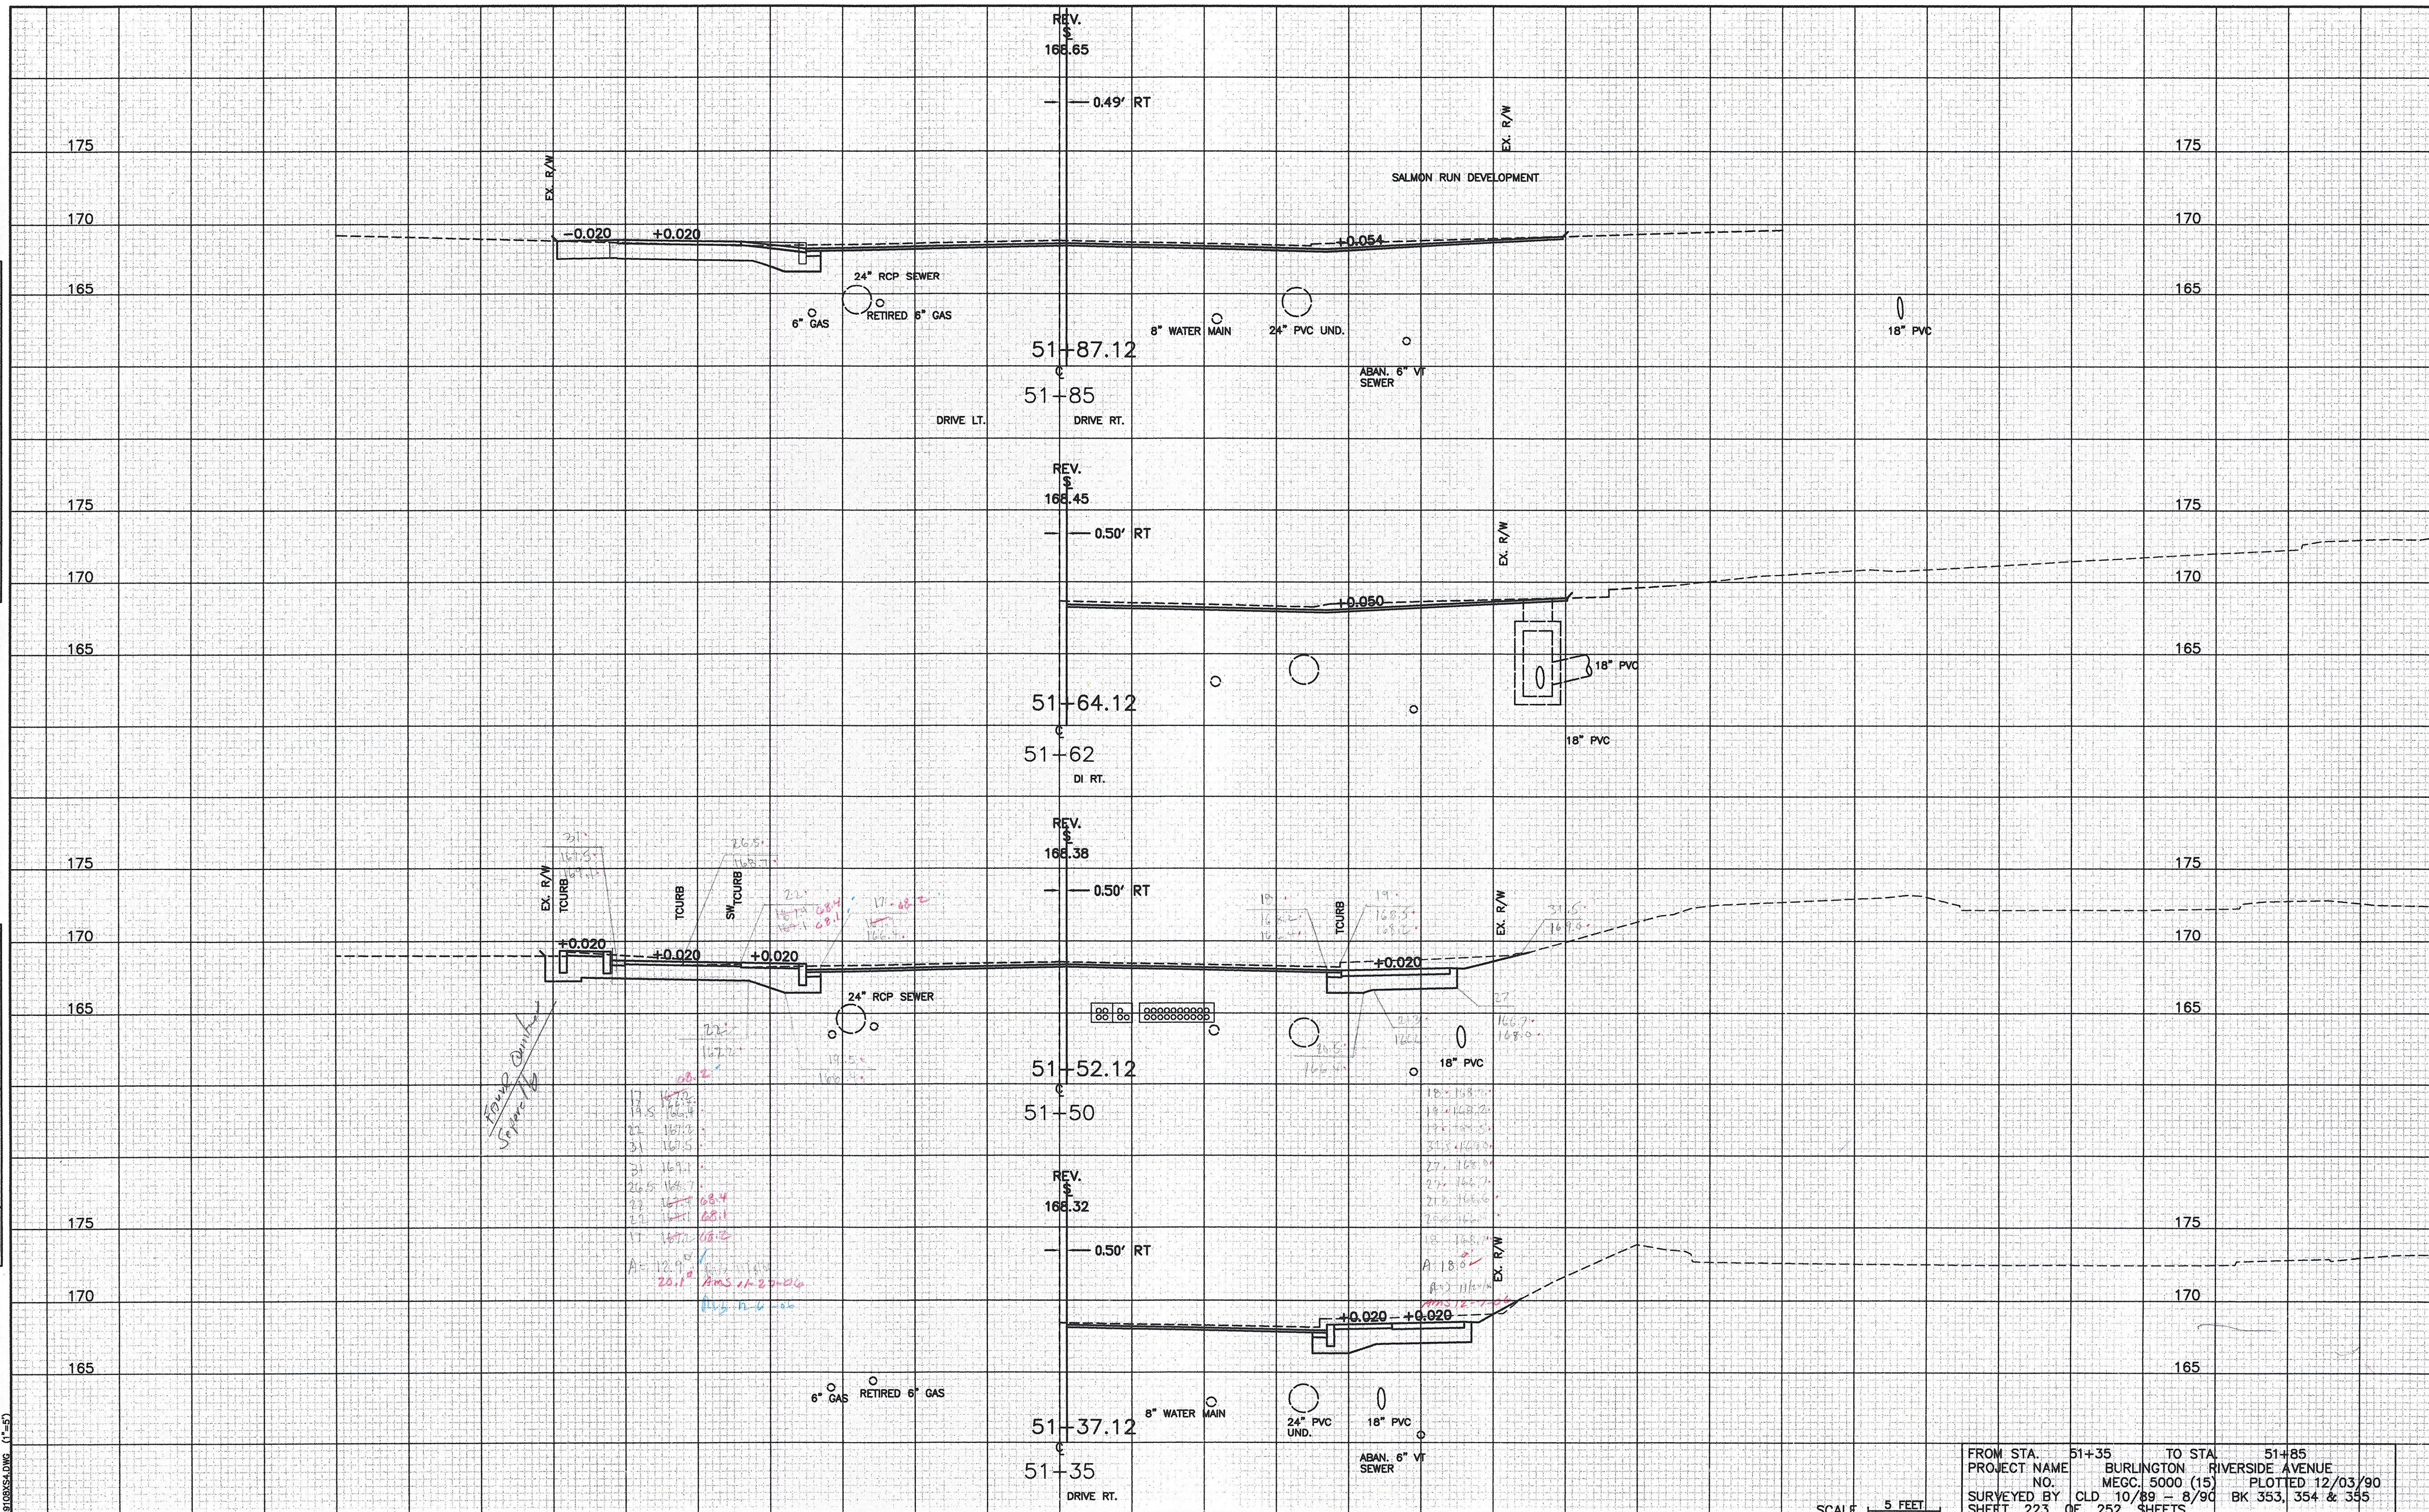

89108354.DWG (1-5)

SCALE 5 FEET

FROM STA. 51+35 TO STA. 51+85
 PROJECT NAME BURLINGTON RIVERSIDE AVENUE
 NO. MECC. 5000 (15) PLOTTED 12/03/90
 SURVEYED BY CLD 10/89 - 8/90 BK 353, 354 & 355
 SHEET 223 OF 252 SHEETS